U.S.GEOLOGICAL SURVEY
GEORGE OTIS SMITH, DIRECTOR

TOPOGRAPHY

STATE OF PENNSYLVANIA
TOPOGRAPHIC AND GEOLOGIC SURVEY COMMISSION

PENNSYLVANIA
EVERETT QUADRANGLE

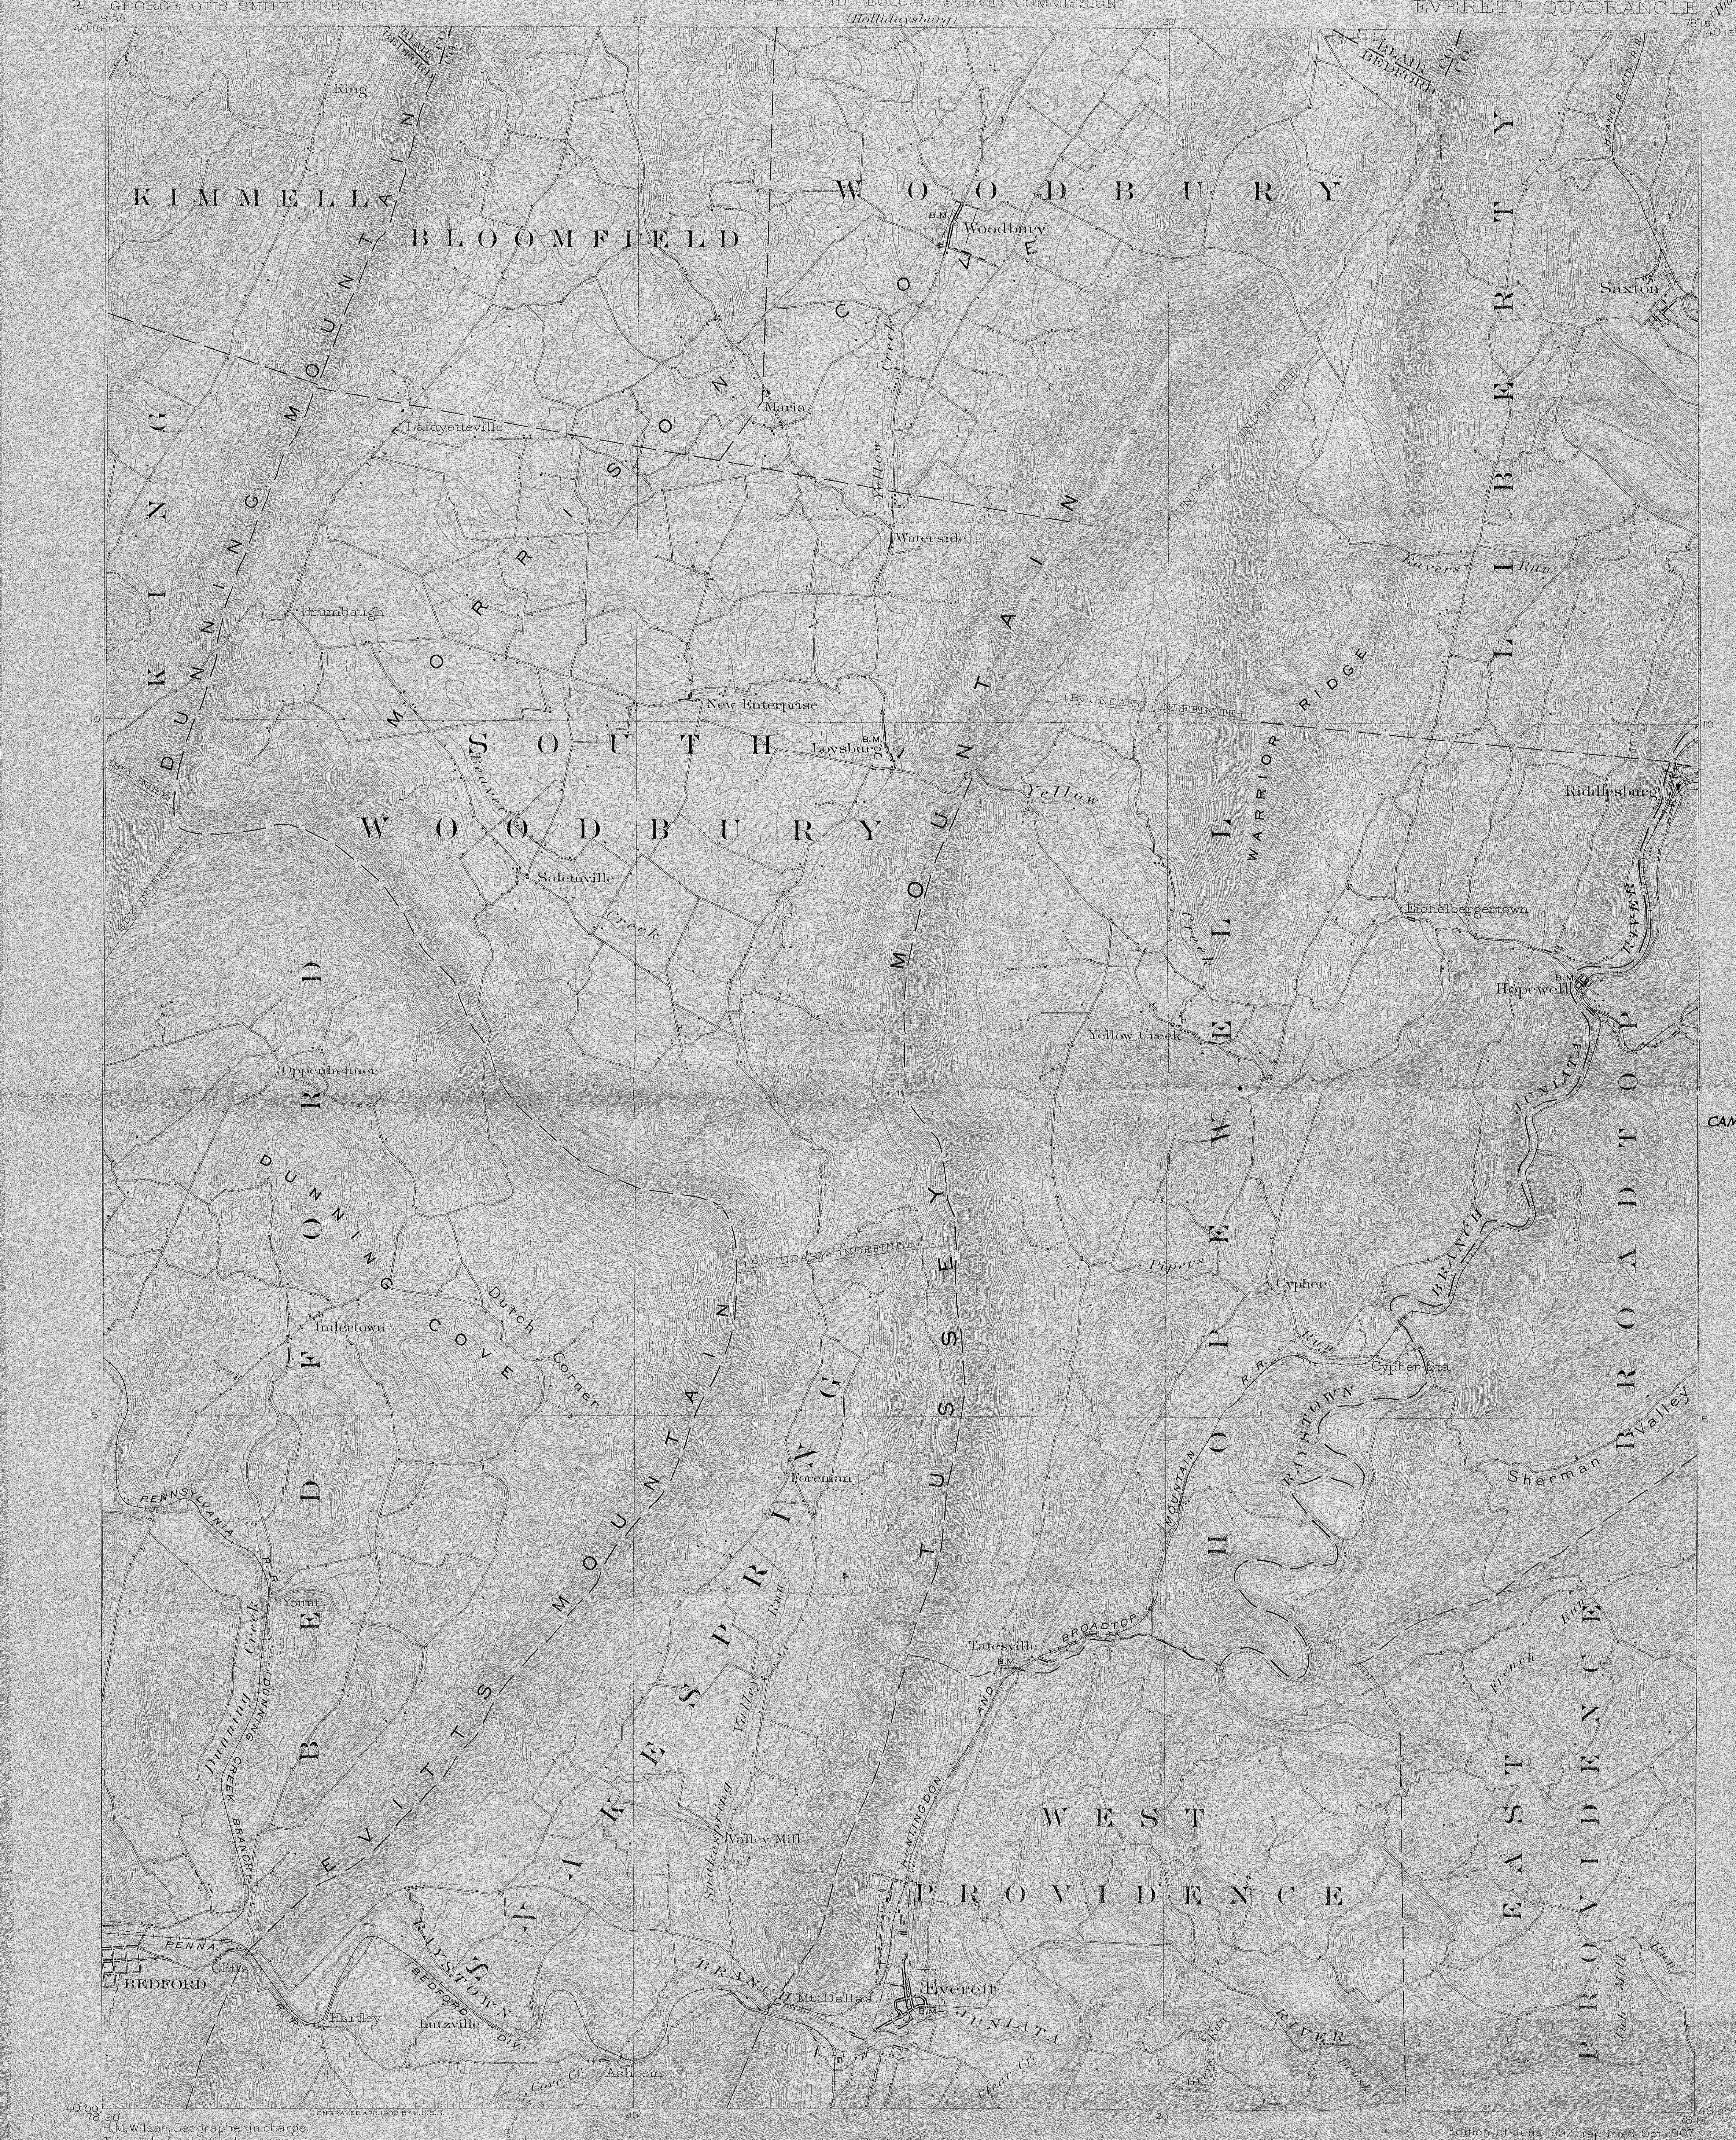
(Ebensburg)
(Hollidaysburg)
(Huntingdon)
78°30'
40°15'
25'
20'
78°15'
10'
5'
40°00'
KIMMELL
BLOOMFIELD
WOODBURY
LIBERTY
KING
DUNNING MOUNTAIN
MORRISON COVE
SOUTH WOODBURY
TUSSEY MOUNTAIN
WARRIOR RIDGE
HOPEWELL
BROAD TOP
BEDFORD
DUNNING COVE
EVITTS MOUNTAIN
SNAKE SPRING
WEST PROVIDENCE
EAST PROVIDENCE
BLAIR CO.
BEDFORD CO.
H. AND B. MTN. R.R.
King
Woodbury
Saxton
Maria
Lafayetteville
Waterside
Brumbaugh
New Enterprise
Loysburg
Riddlesburg
Salemville
Eichelbergertown
Hopewell
Yellow Creek
Oppenheimer
Cypher
Cypher Sta.
Imlertown
Dutch Corner
Foreman
Yount
Tatesville
Valley Mill
BEDFORD
Cliffs
Hartley
Lutzville
Ashcom
Mt. Dallas
Everett
Ravers Run
Yellow Creek
Beaver Creek
Pipers Run
Sherman Valley
French Run
Tub Mill Run
Snake Spring Valley Run
Dunning Creek
Cove Cr.
Clear Cr.
Greys Run
Brush Cr.
RAYSTOWN BRANCH
JUNIATA RIVER
PENNSYLVANIA R.R.
DUNNING CREEK BRANCH
PENNA. R.R. BEDFORD DIV.
HUNTINGDON AND BROADTOP MOUNTAIN R.R.
BOUNDARY INDEFINITE
B.M.

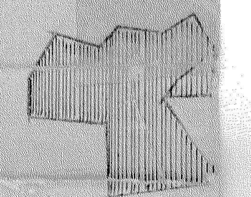

CAMBRIA STEEL CO.

363.06325A

H.M.Wilson, Geographer in charge.
Triangulation by Sledge Tatum.
Topography by A.M.Walker.
Surveyed in 1900 in cooperation with the State of Pennsylvania.

ENGRAVED APR.1902 BY U.S.G.S.

TRUE NORTH
MAGNETIC NORTH
APPROXIMATE MEAN DECLINATION 1902

Scale $\frac{1}{62500}$

1 ½ 0 1 2 3 4 Miles

1 ½ 0 1 2 3 4 5 Kilometers

Contour interval 20 feet.
Datum is mean sea level.

Edition of June 1902, reprinted Oct. 1907.

EVERETT

Coal Mined Out..
Upper Freeport, E or Kelly Seam. Colored. ▥ 363.063 Acres

CAMBRIA STEEL COMPANY.

#439
6-21-99
C.C.