


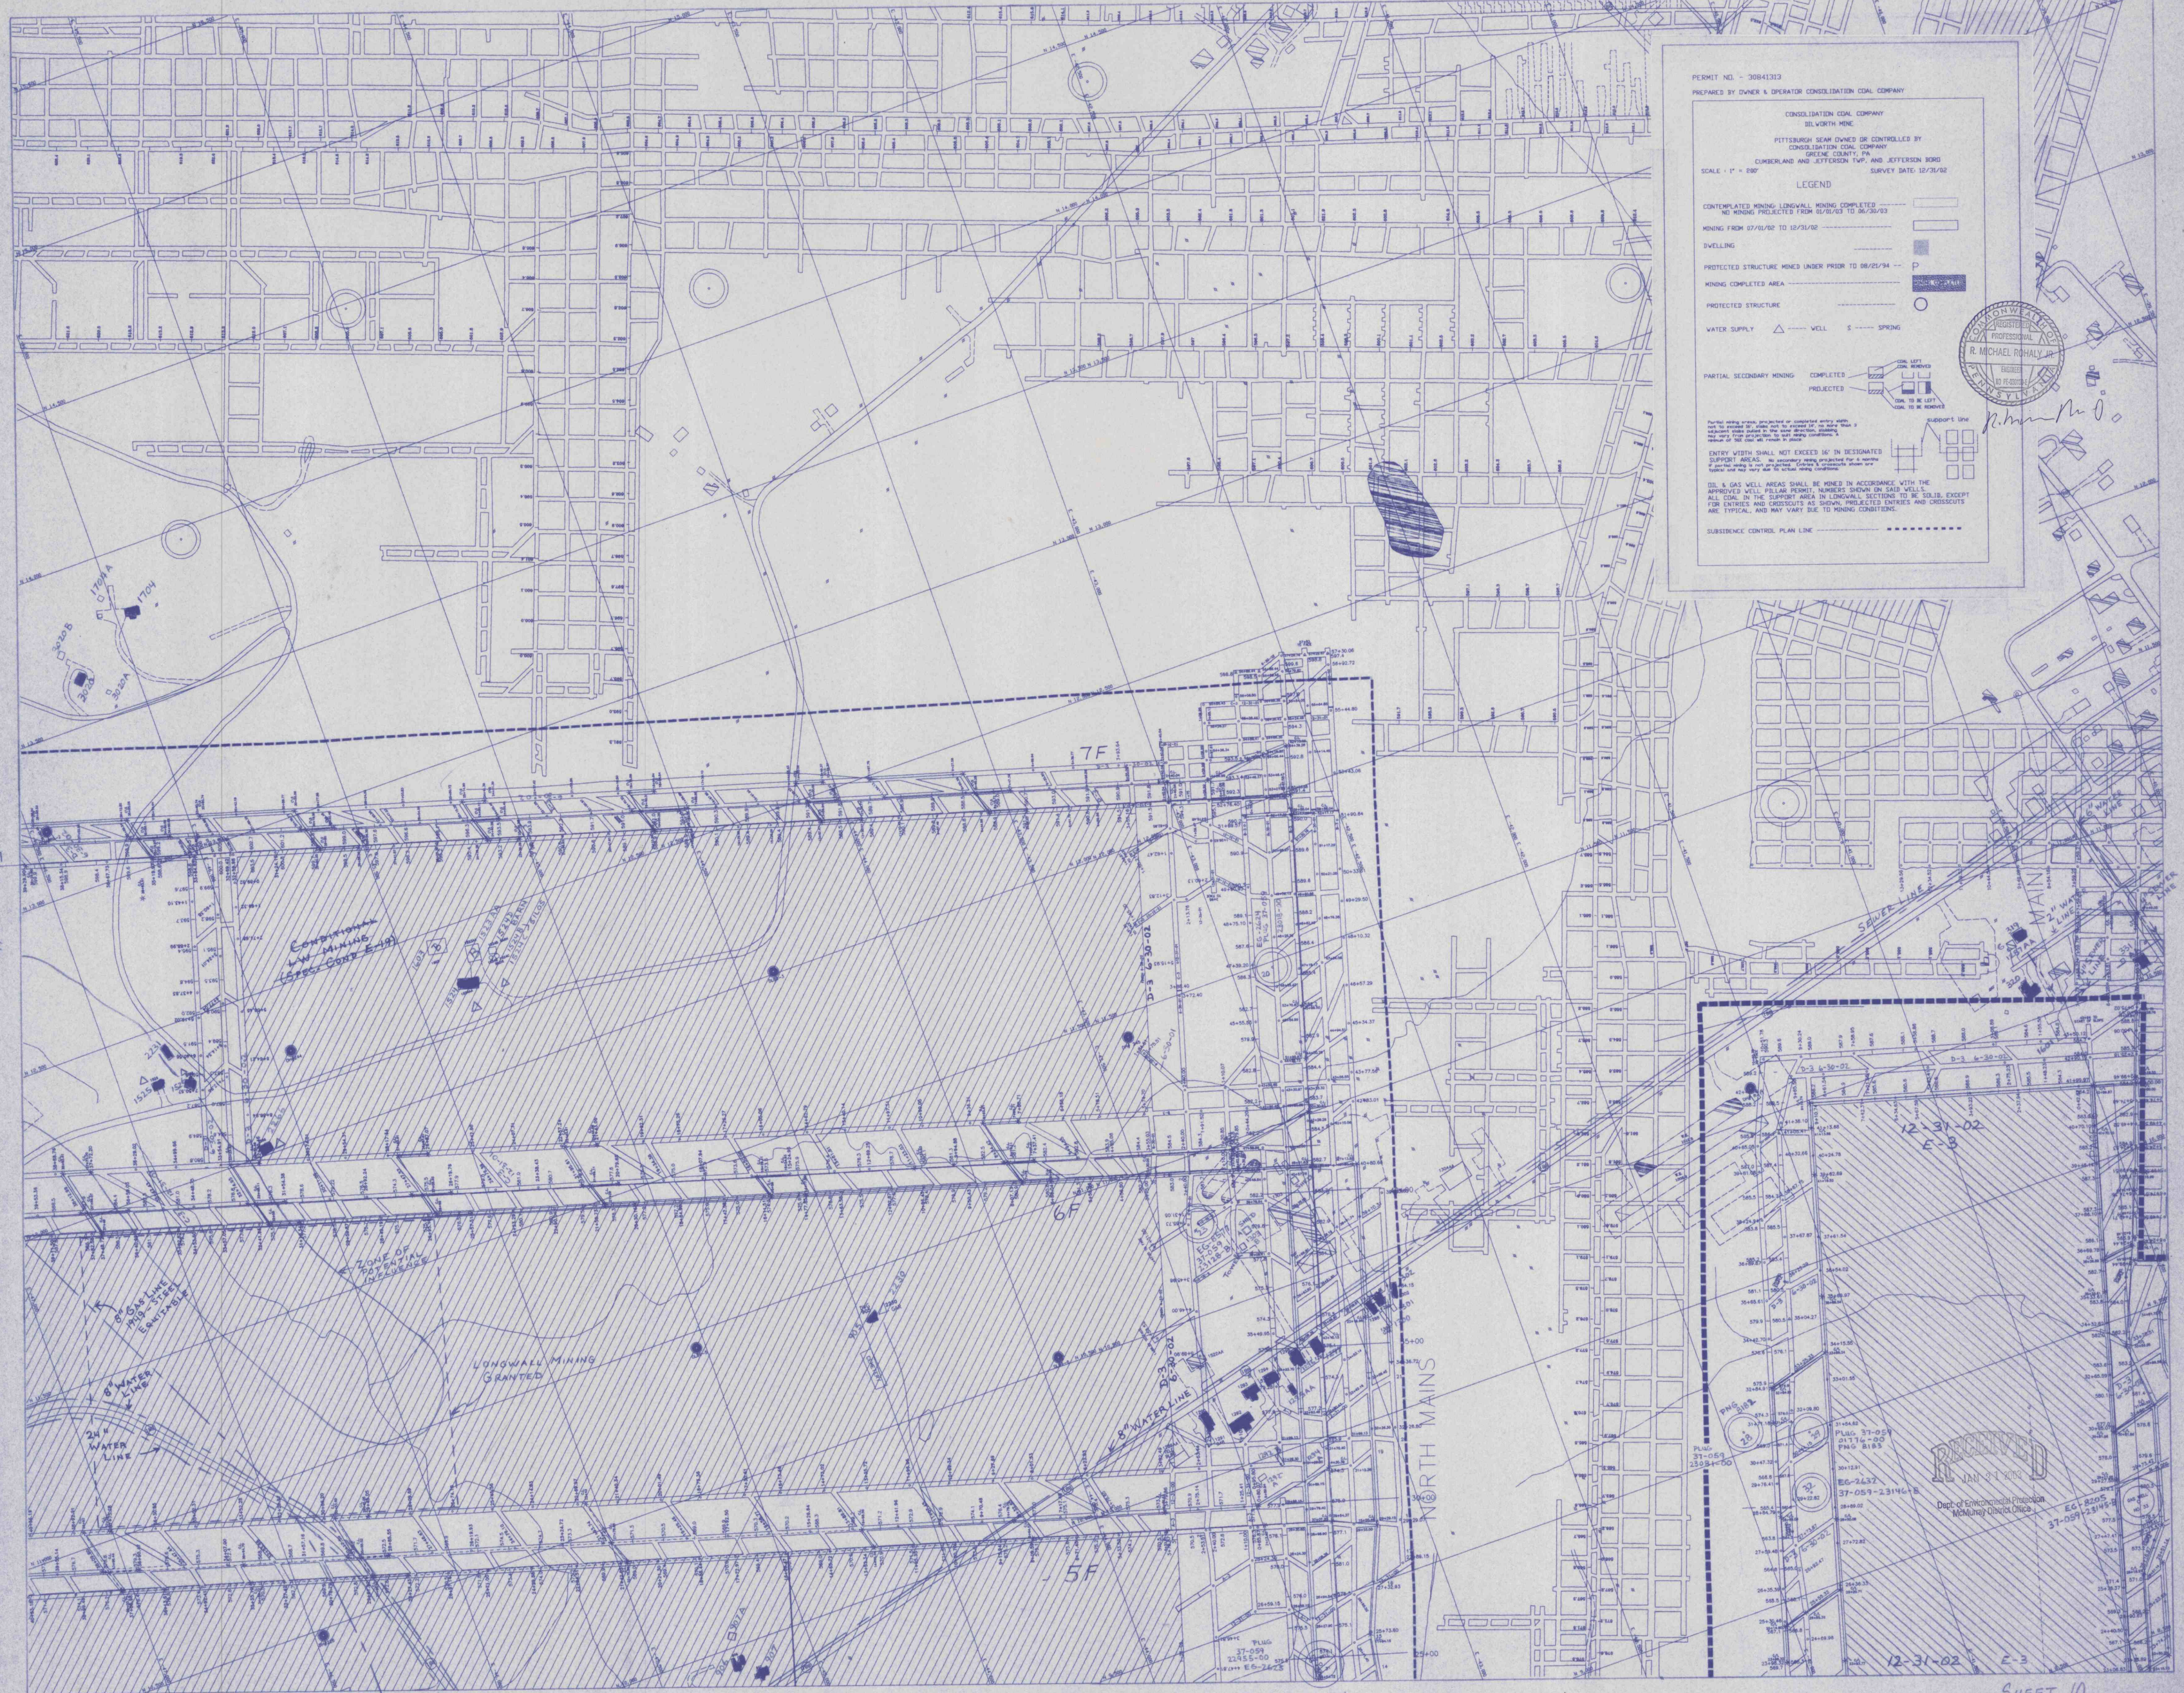

PERMIT NO. - 30841313
PREPARED BY OWNER & OPERATOR CONSOLIDATION COAL COMPANY

CONSOLIDATION COAL COMPANY
111 WORTH AVE.
PITTSBURGH SEAM OWNED OR CONTROLLED BY
CONSOLIDATION COAL COMPANY
GREENE COUNTY, PA.
CLIMBERLAND AND JEFFERSON TWP. AND JEFFERSON HORD
SURVEY DATE 12/31/02

SCALE 1" = 200'

LEGEND

CONTINGENT MINING LONGWALL MINING COMPLETED
NO MINING PROJECTED FROM 01/01/03 TO 06/30/03

MINING FROM 07/01/02 TO 12/31/02

DWELLING

PROTECTED STRUCTURE MINED UNDER PRIOR TO 08/25/94

MINING COMPLETED AREA

PROTECTED STRUCTURE

WATER SUPPLY Δ WELL $\$$ SPRING

PARTIAL SECONDARY MINING COMPLETED PROJECTED

COAL LEFT OR MINED
COAL TO BE LEFT OR TO BE MINED


ILL & GAS WELL AREAS SHALL BE MINED IN ACCORDANCE WITH THE APPROVED WELL PILLAR PERMIT NUMBERS SHOWN ON SAID WELLS. ALL COAL IN THE SUPPORT AREA IN LONGWALL SECTORS TO BE SOLID, EXCEPT FOR ENTRIES AND CROSSCUTS AS SHOWN. PROJECTED ENTRIES AND CROSSCUTS ARE TYPICAL, AND MAY VARY DUE TO MINING CONDITIONS.

SUBSISTENCE CONTROL PLAN LINE

PROFESSIONAL
R. MICHAEL ROHALY JR.
12/31/02