
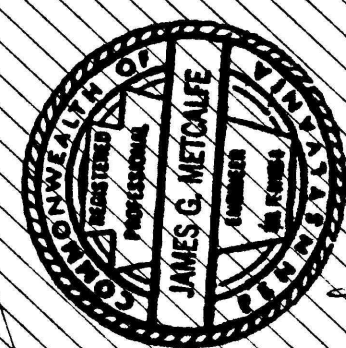


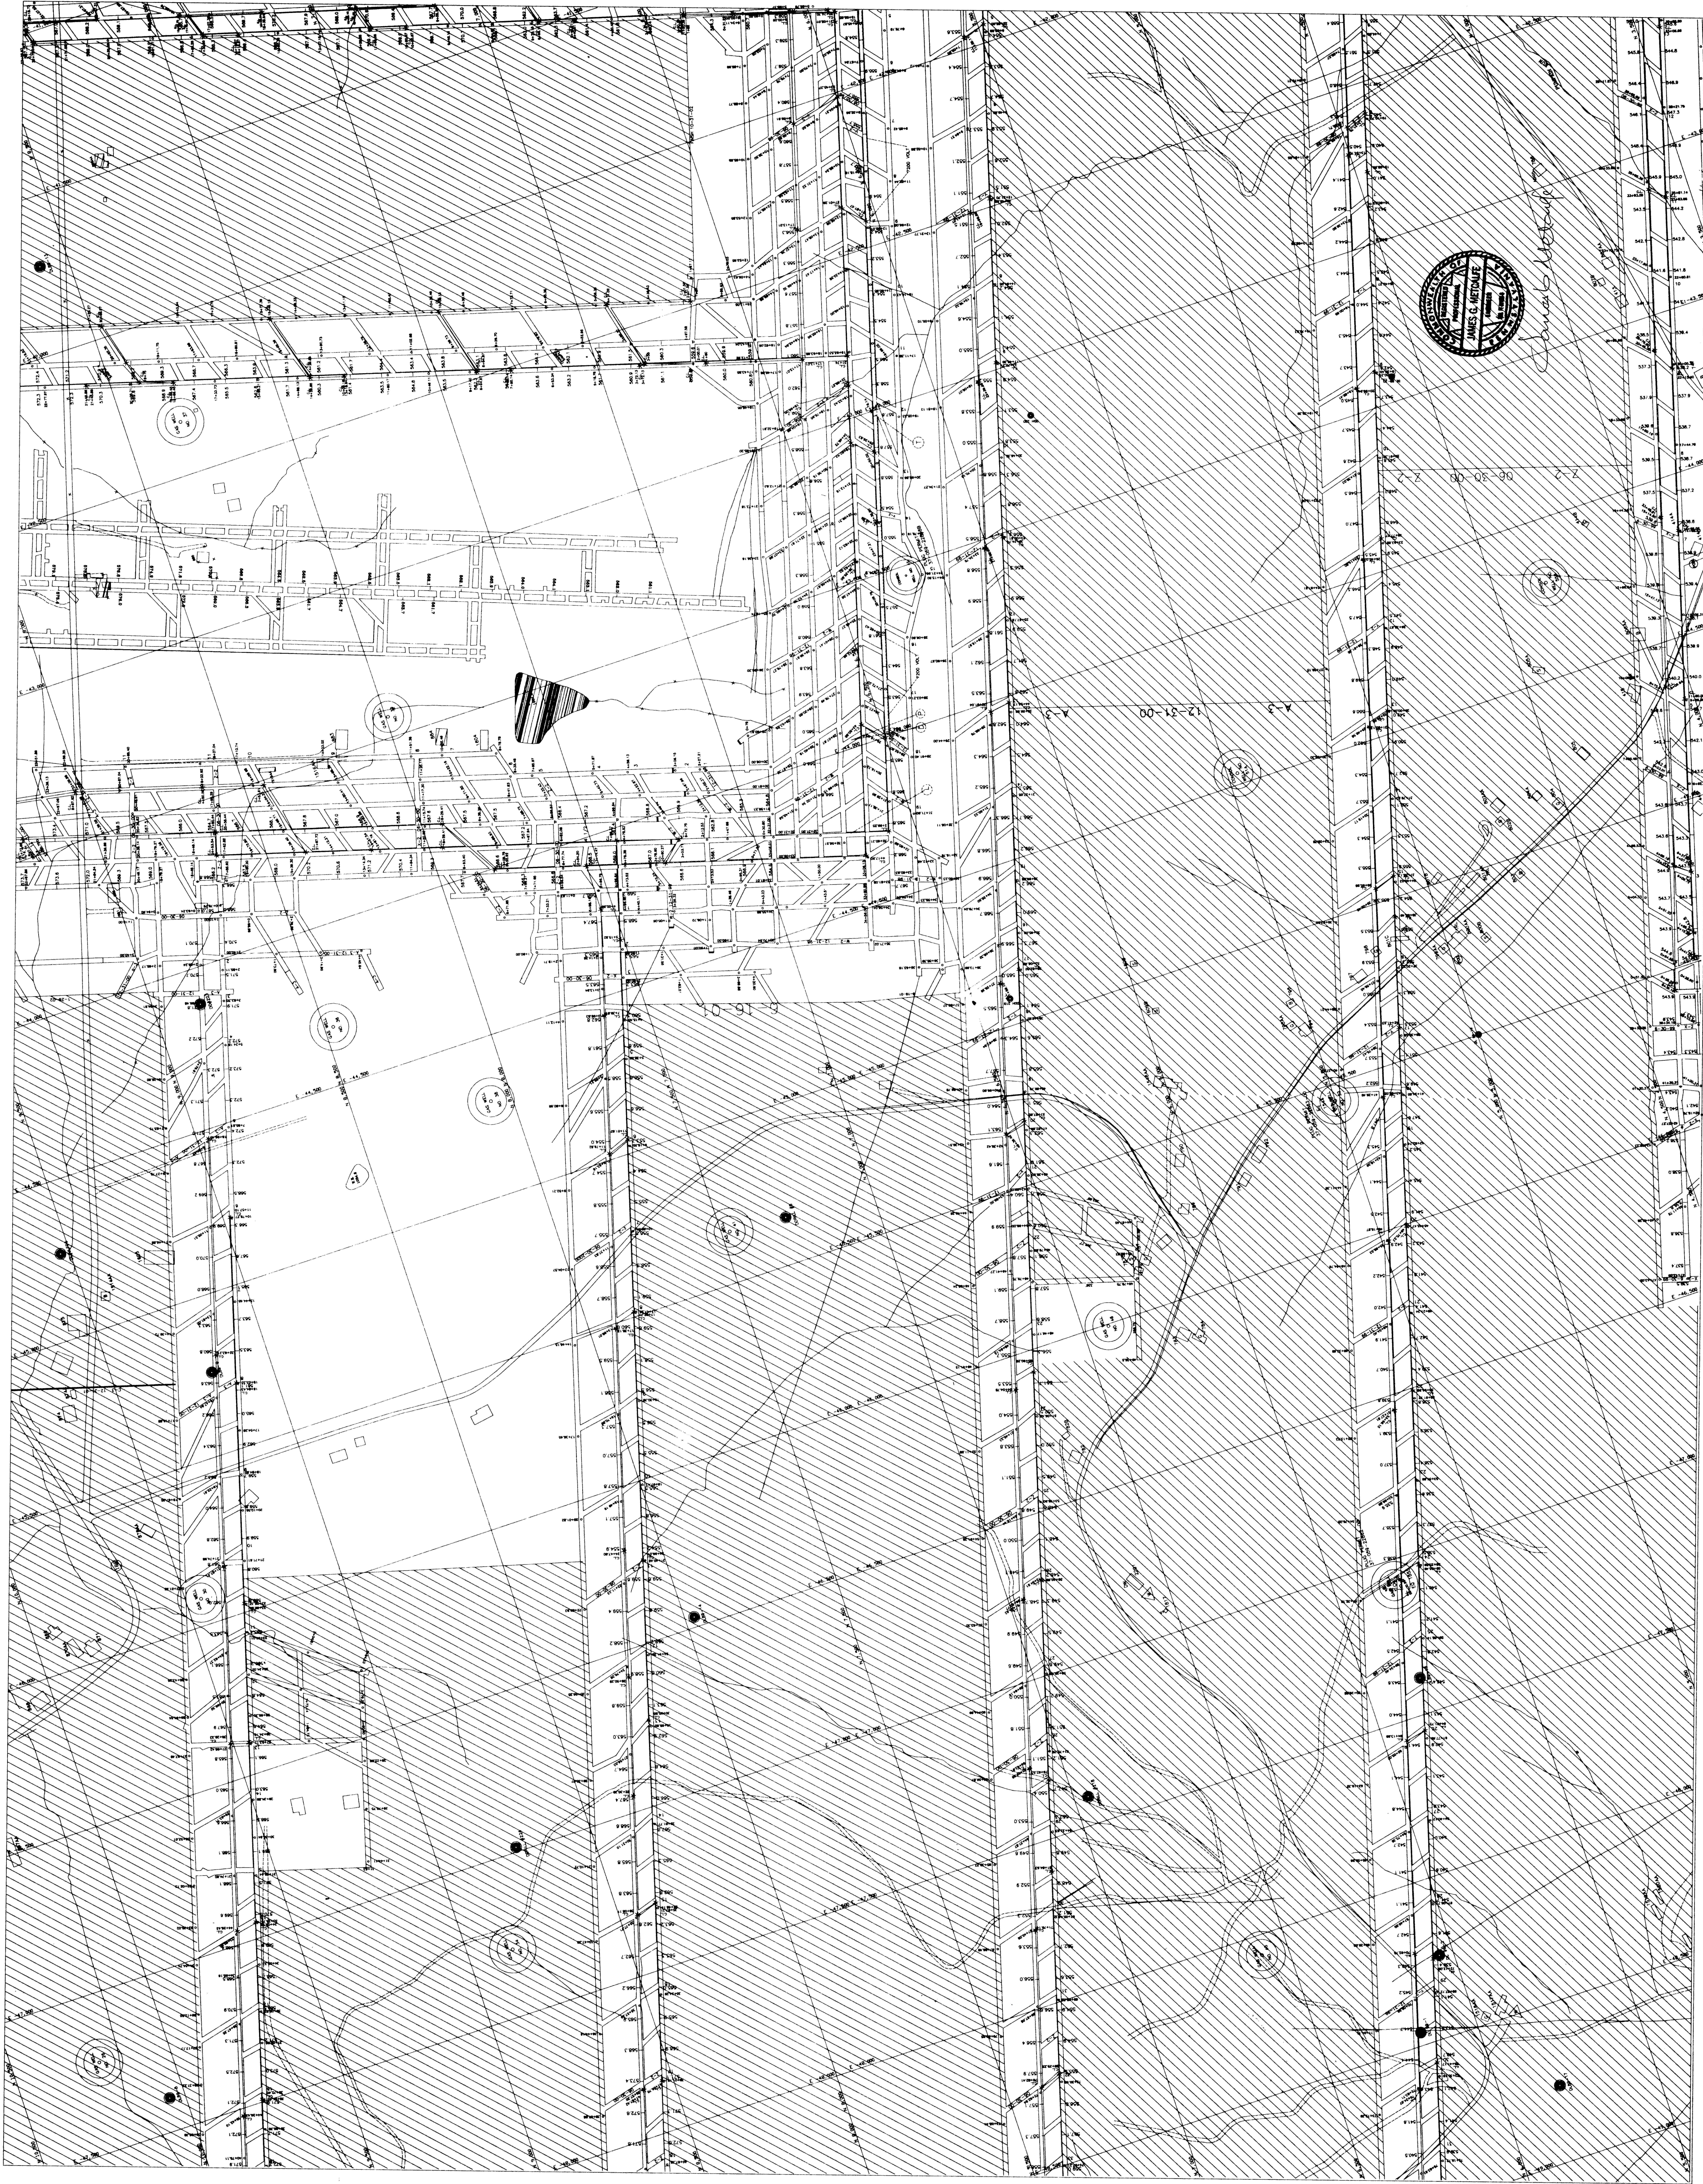


06-30-00 Z-2

3 12-31-00

DEEP MINE SAFETY	200
------------------	-----

SHEET 14

SHEET 14