


FIT TO 18 V

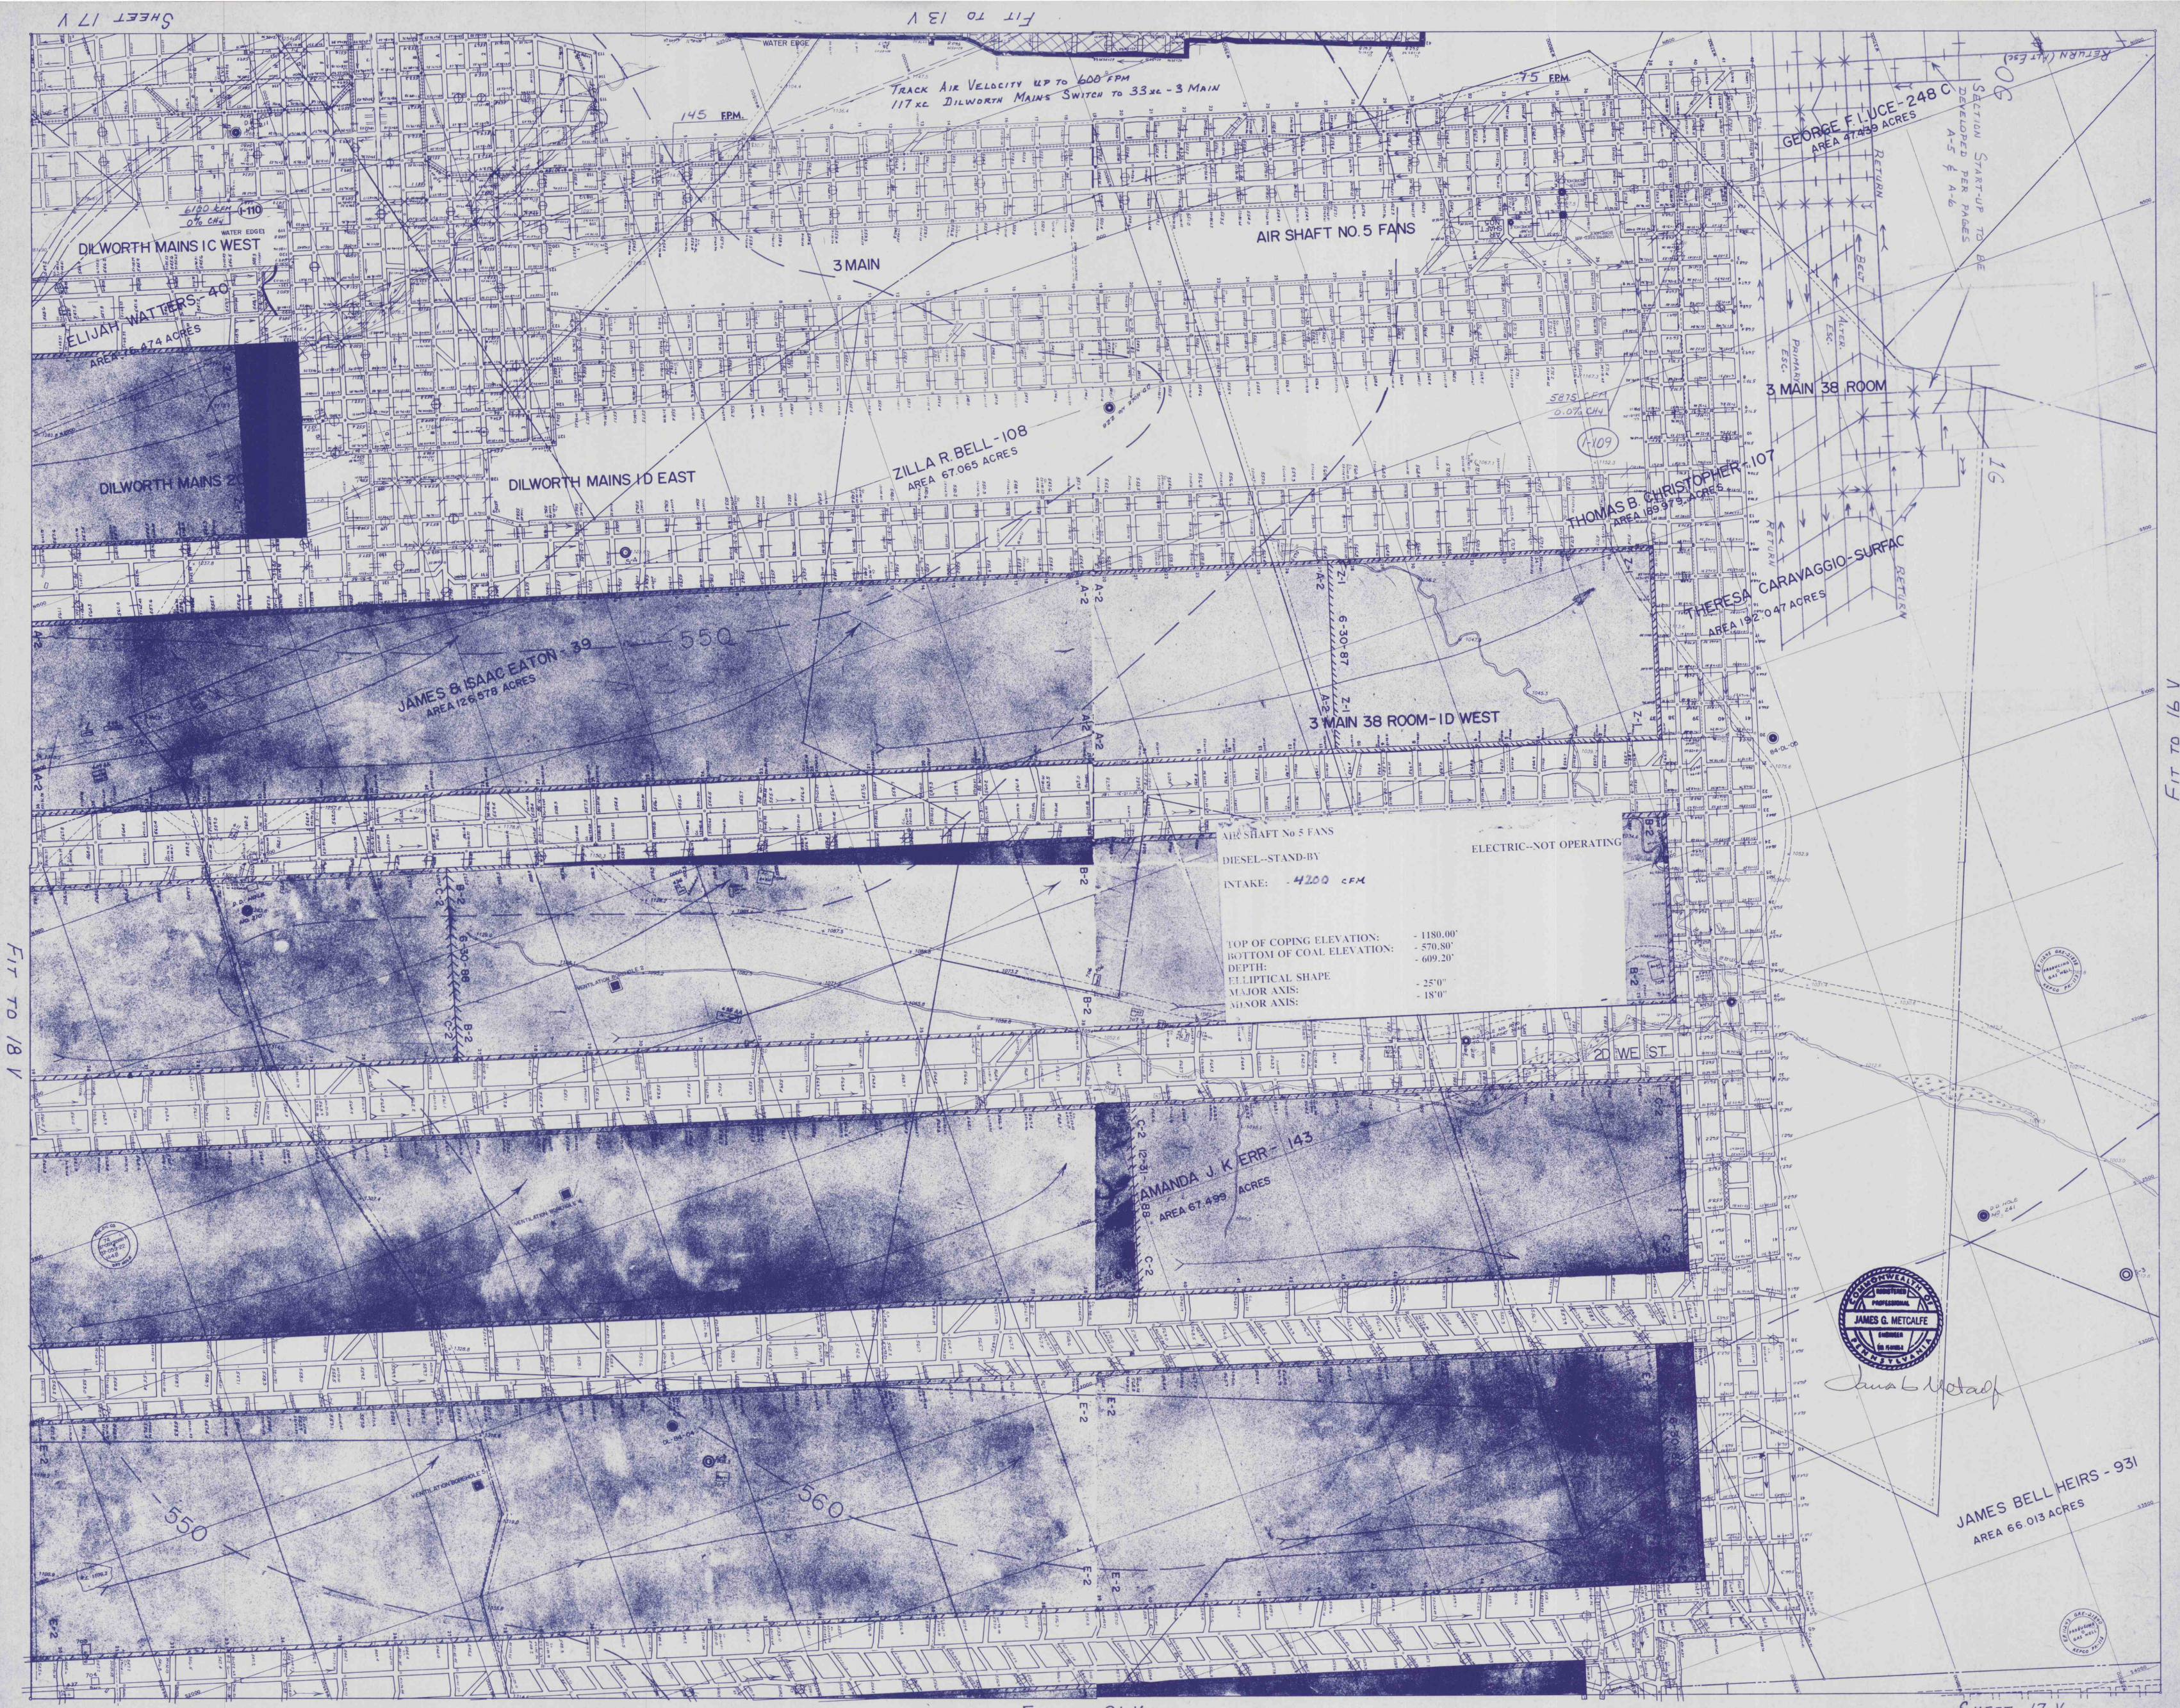

SHEET 17 V

DILWORTH MAINS 1C WEST

ELIJAH WATERS - 40
AREA 6.474 ACRES

DILWORTH MAINS 2C

DILWORTH MAINS 1D EAST

JAMES & ISAAC EATON - 39
AREA 126.578 ACRES

ZILLA R BELL - 108
AREA 67.065 ACRES

AIR SHAFT NO 5 FANS
DIESEL-STAND-BY
INTAKE: -4200 CFM

TOP OF COPING ELEVATION: -1180.00'
BOTTOM OF COAL ELEVATION: -570.80'
DEPTH: -609.20'
ELLIPTICAL SHAPE
MAJOR AXIS: -25'0"
MINOR AXIS: -18'0"

AMANDA J. KERR - 143
AREA 67.499 ACRES

GEORGE F. LUCE - 248 C
AREA 47.439 ACRES

THOMAS B. CHRISTOPHER - 107
AREA 59.979 ACRES

THERESA CARAVAGGIO-SURFAC
AREA 192.047 ACRES

JAMES BELL HEIRS - 931
AREA 66.013 ACRES



James G. Metcalfe

FIT TO 21 V

SHEET 17 V

FIT TO 16 V