


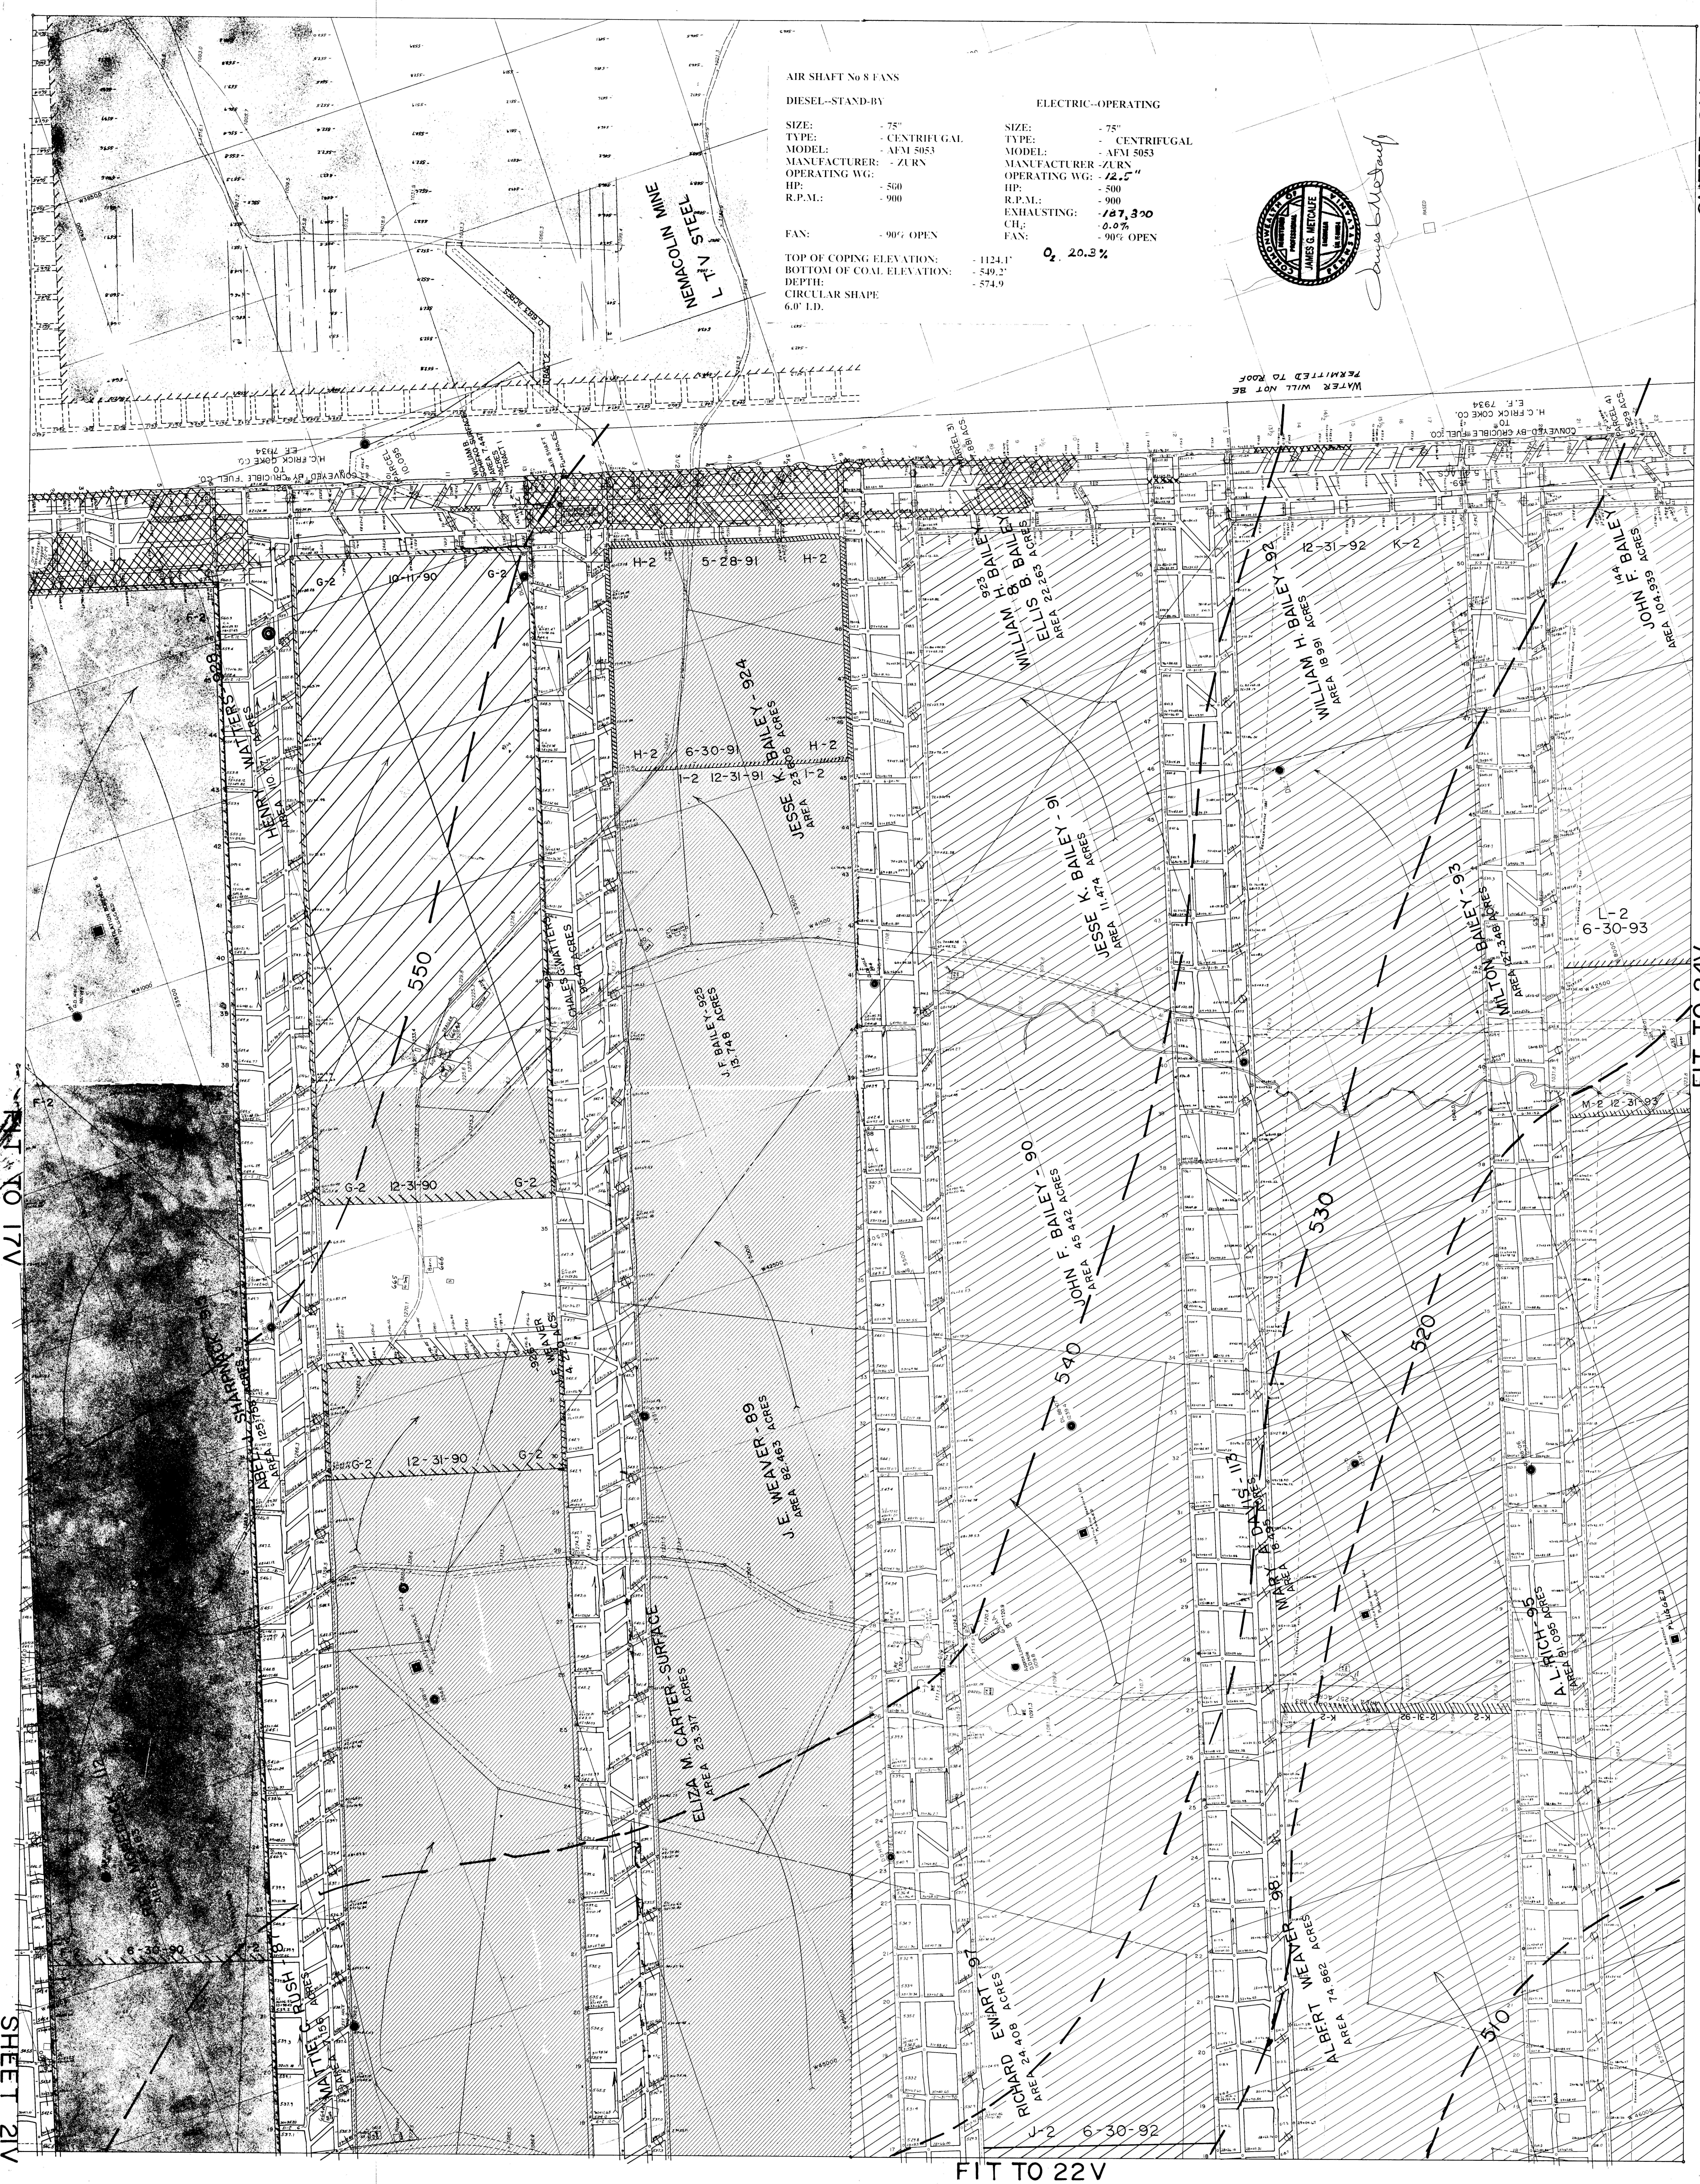

AIR SHAFT No 8 FANS
DIESEL--STAND-BY
ELECTRIC--OPERATING

SIZE: - 75"	SIZE: - 75"
TYPE: - CENTRIFUGAL	TYPE: - CENTRIFUGAL
MODEL: - AFM 5053	MODEL: - AFM 5053
MANUFACTURER: - ZURN	MANUFACTURER: - ZURN
OPERATING WG: - 500	OPERATING WG: - 12.5"
HP: - 500	HP: - 500
R.P.M.: - 900	R.P.M.: - 900
FAN: - 90% OPEN	EXHAUSTING: - 187,300
	FAN: - 90% OPEN

TOP OF COPING ELEVATION: - 1124.1'
BOTTOM OF COAL ELEVATION: - 549.2'
DEPTH: - 574.9'
CIRCULAR SHAPE
6.0' I.D.

Q₂ 20.3%

