


AIR SHAFT #10
6' DIA.
INTAKE 6160 CFM SURFACE ELEV. 1083.00'
0.0 % CH₄ BOTTOM COAL EL. 508.00'
DEPTH 575.00'

FANS	
ELECTRIC	DIESEL
(CURRENTLY OFF)	(OFF)
SIZE: 81"	81"
TYPE: CENTRIFUGAL	CENTRIFUGAL
MODEL: AF 1037	AF 1037
MFR: ROBINSON INDUSTRIES INC.	
OPERATING WG:	
HP: 500	500
RPM: 880	880
FAN OPENING:	

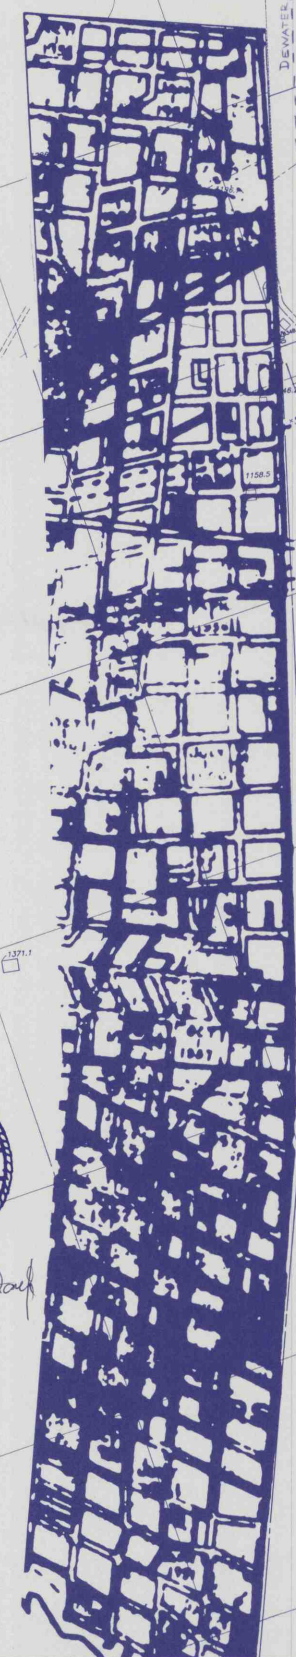

James G. Metcalfe



W.A. RUSH
AREA 12.639 ACRES

JOSEPH BURRELL HEIRS - 75
AREA 114.844 ACRES

LOT L. RICH - 73
AREA 114.966 ACRES

SAMUEL T. KEENEY - 23
AREA 45.393 ACRES

MARSHALL GWYN HEIRS - 110
AREA 81.560 ACRES

JOSEPH GWYN - 74
AREA 10.123 ACRES