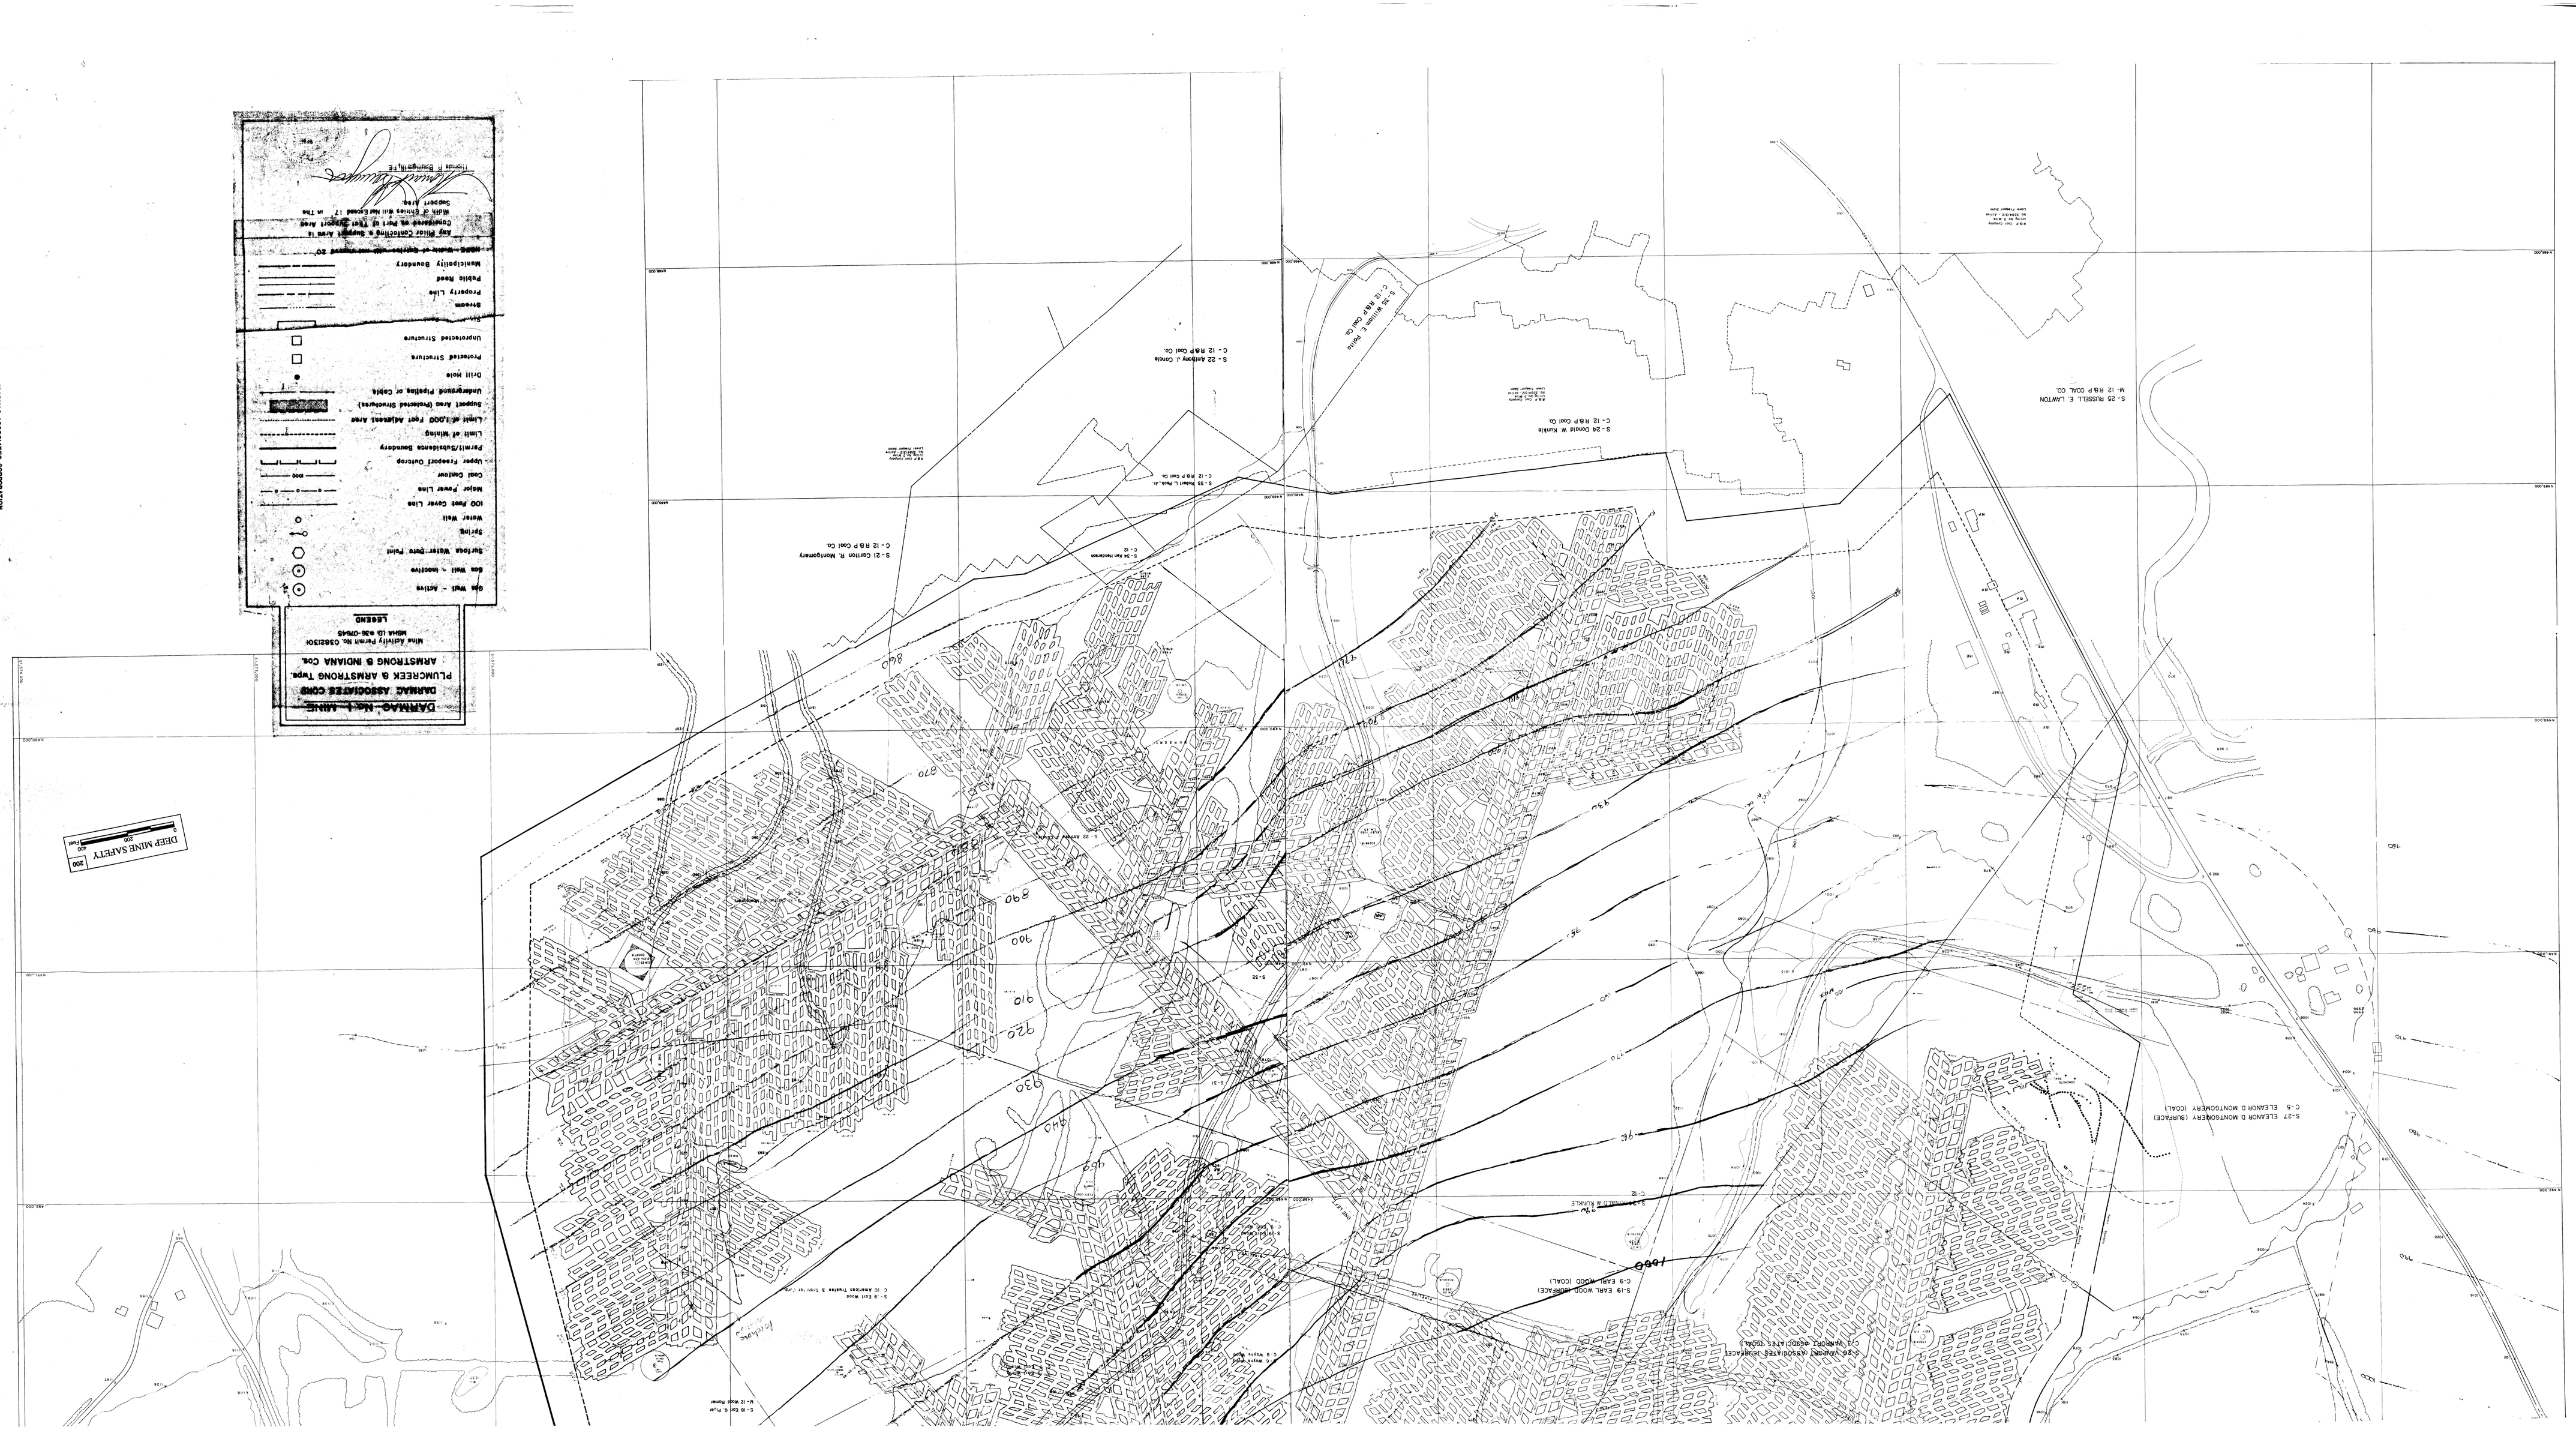FINAL CLOSURE MAP (11-25-92)