


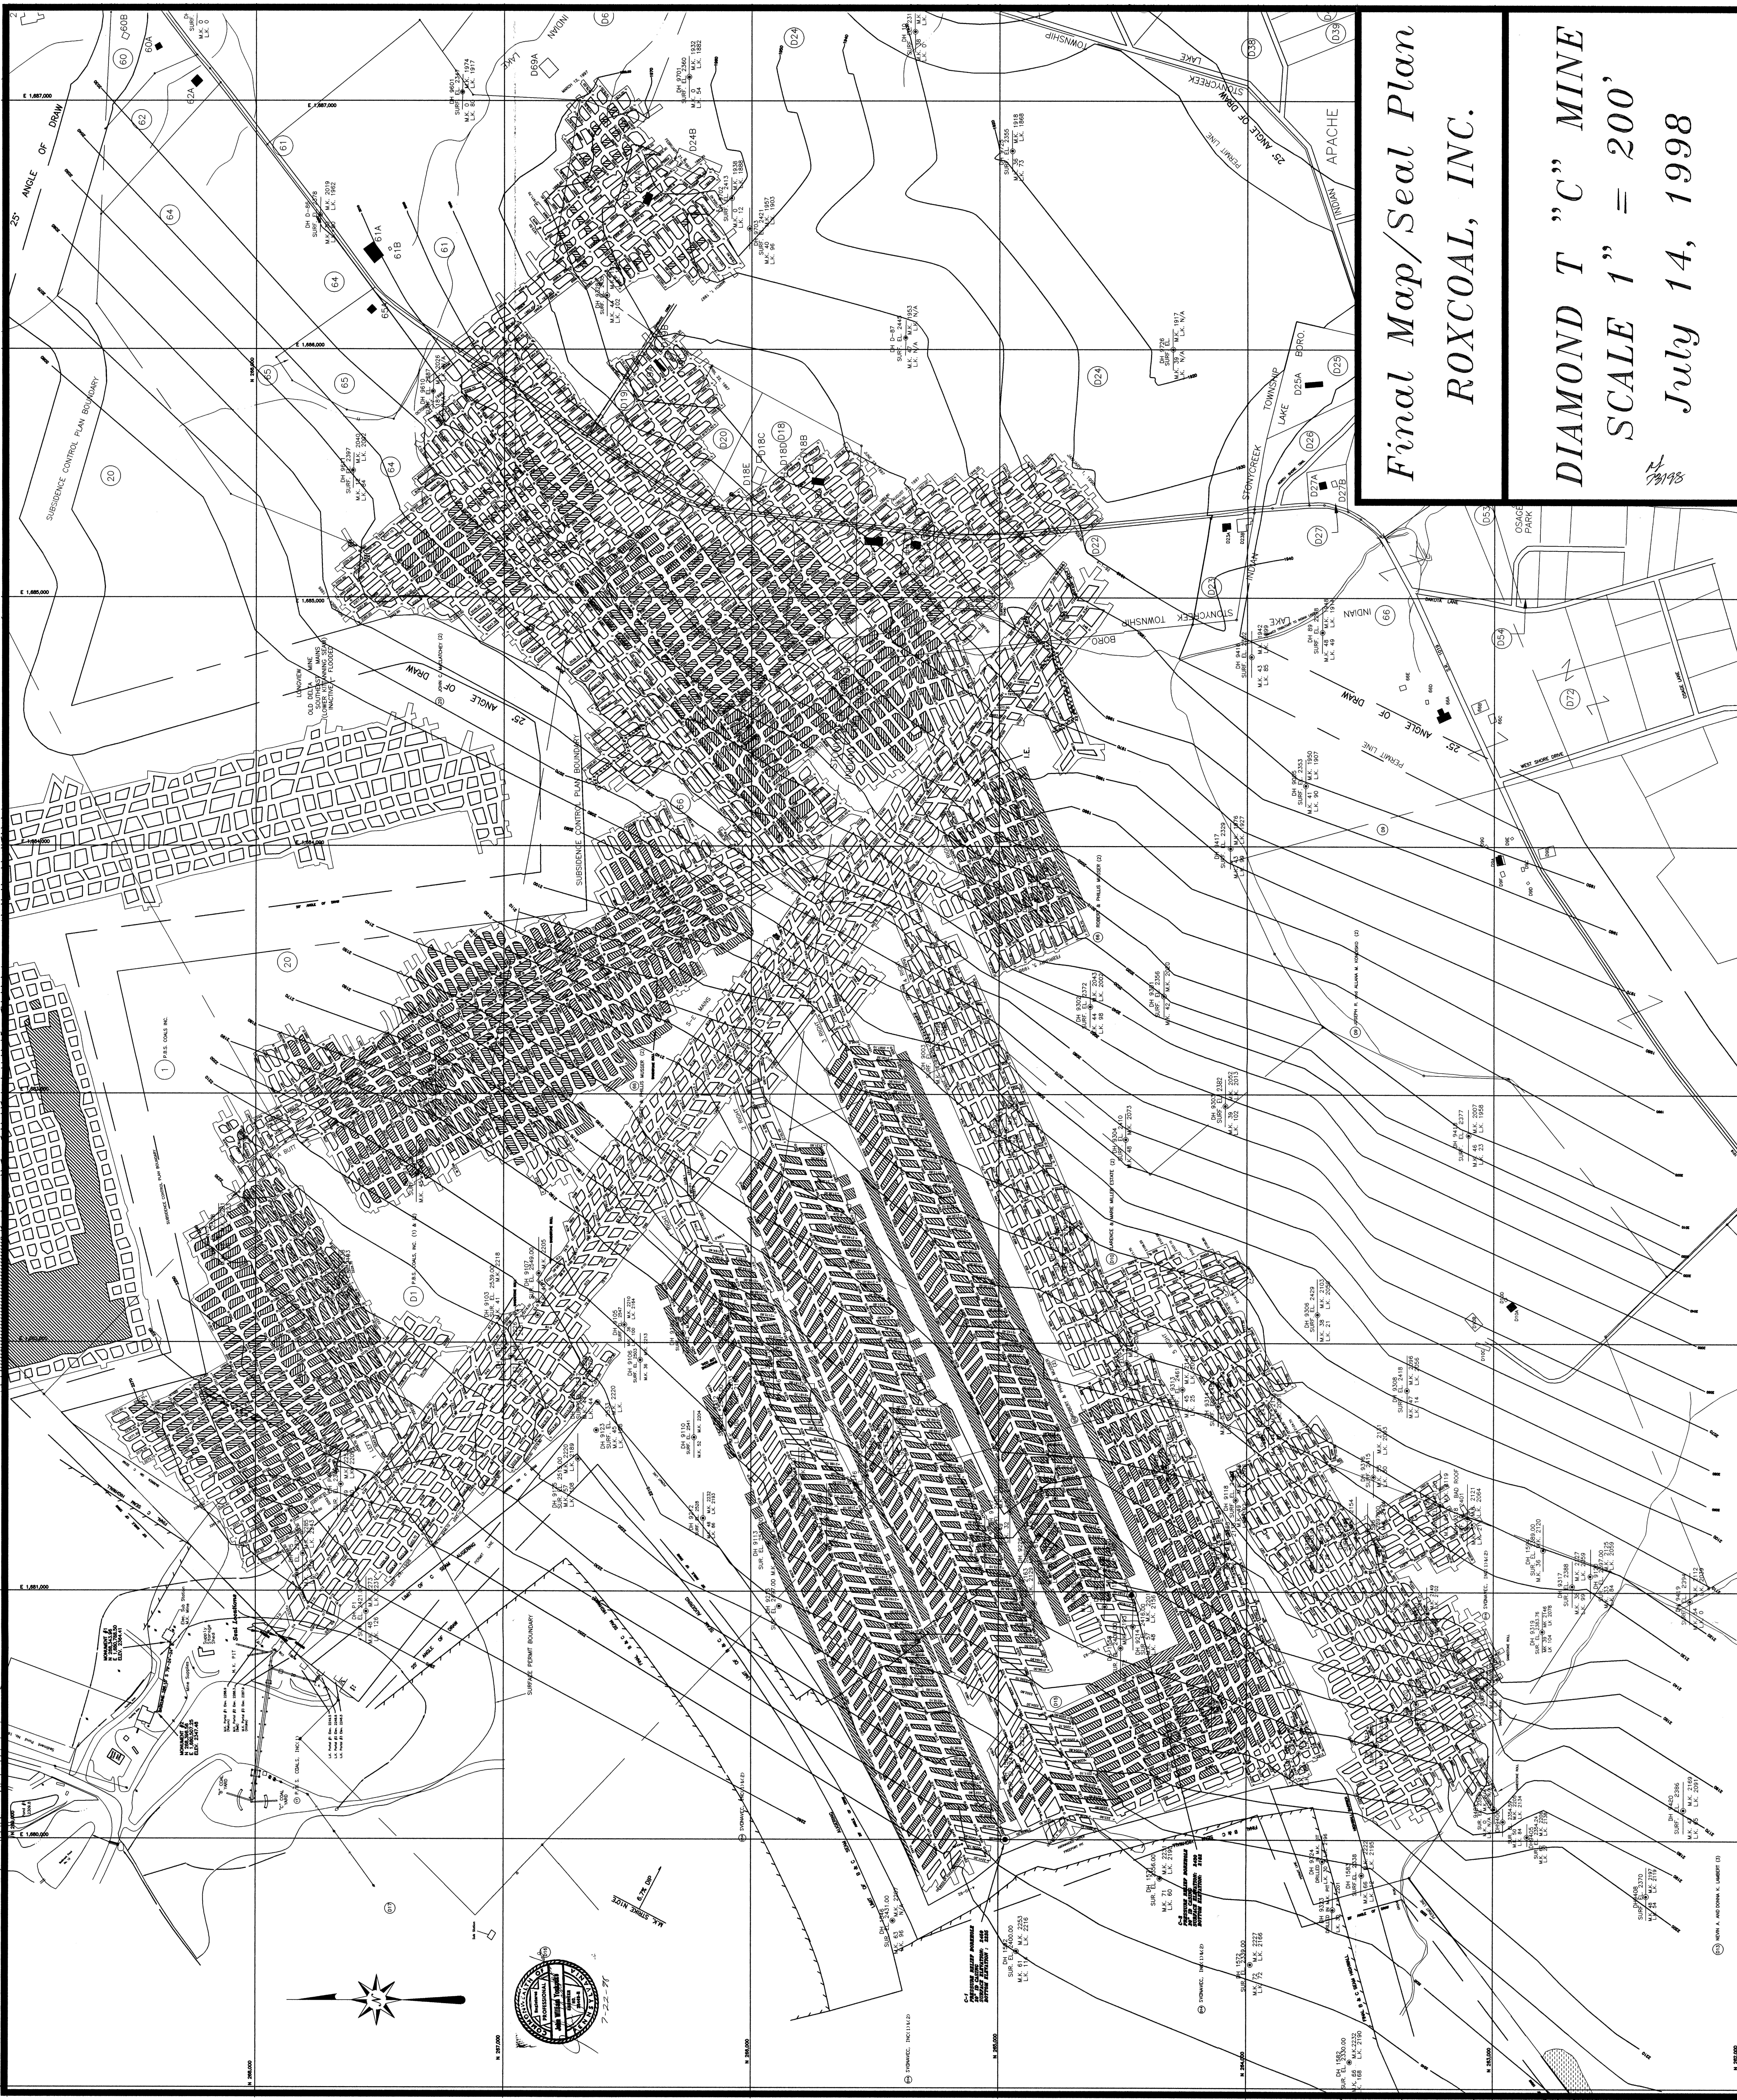

Final Map/Seal Plan
ROXCOAL, INC.

DIAMOND T "C" MINE
SCALE 1" = 200'
July 14, 1998