



Final Map/Seal Plan
ROXCOAL, INC.

ROXCOAL, INC.

DIAMOND T "B" MINE

Scale: 1" = 200'


July 14, 1998

I, the undersigned, hereby certify that this map is correct and shows all the information, to the best of my knowledge and belief, required by the mining laws of this state.




CA PROFESSIONAL

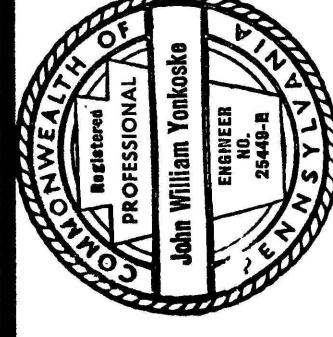

DEEP MINE SAFETY	200
------------------	-----

A vertical scale bar with markings at 0, 200, and 400 feet.

700