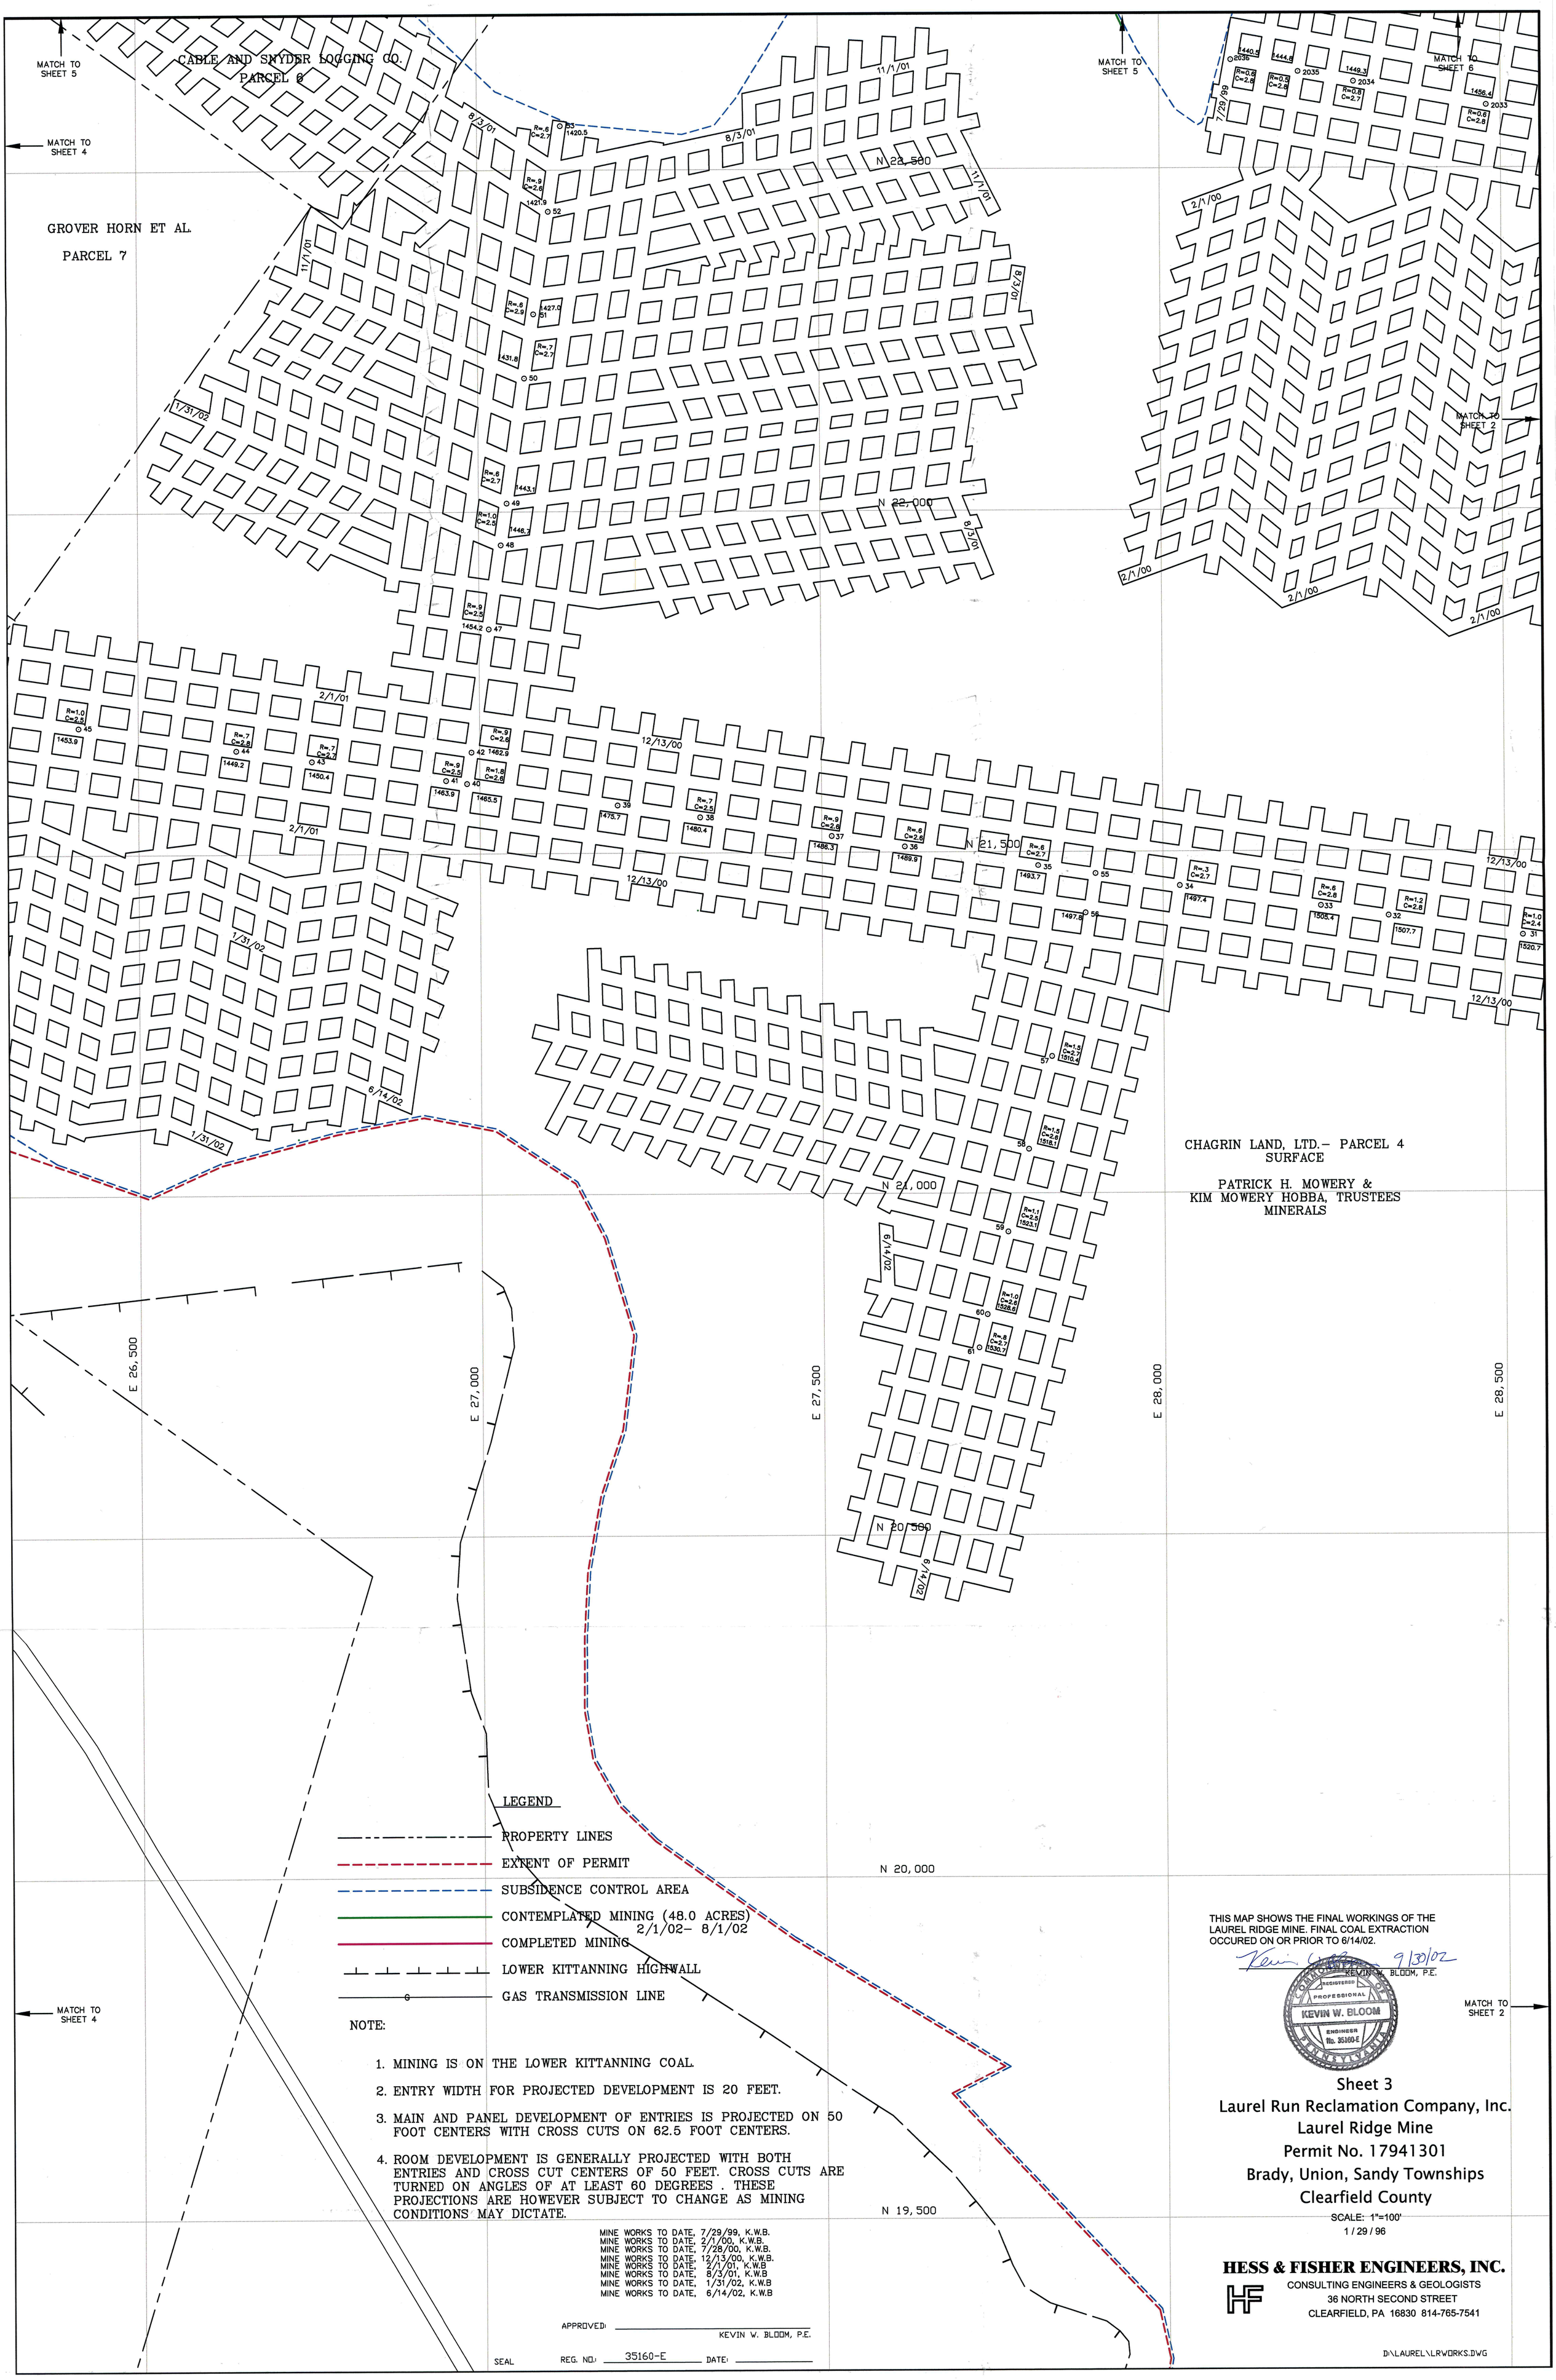
MATCH TO SHEET 5
CABLE AND SNYDER LOGGING CO.
PARCEL 6
MATCH TO SHEET 4
GROVER HORN ET AL.
PARCEL 7
MATCH TO SHEET 5
MATCH TO SHEET 6
MATCH TO SHEET 2
MATCH TO SHEET 4
N 23,500
N 22,000
N 21,500
N 21,000
N 20,500
N 20,000
N 19,500
E 26,500
E 27,000
E 27,500
E 28,000
E 28,500
CHAGRIN LAND, LTD.- PARCEL 4
SURFACE
PATRICK H. MOWERY &
KIM MOWERY HOBBA, TRUSTEES
MINERALS
LEGEND
PROPERTY LINES
EXTENT OF PERMIT
SUBSIDENCE CONTROL AREA
CONTEMPLATED MINING (48.0 ACRES)
2/1/02- 8/1/02
COMPLETED MINING
LOWER KITTANNING HIGHWALL
GAS TRANSMISSION LINE
NOTE:
1. MINING IS ON THE LOWER KITTANNING COAL.
2. ENTRY WIDTH FOR PROJECTED DEVELOPMENT IS 20 FEET.
3. MAIN AND PANEL DEVELOPMENT OF ENTRIES IS PROJECTED ON 50 FOOT CENTERS WITH CROSS CUTS ON 62.5 FOOT CENTERS.
4. ROOM DEVELOPMENT IS GENERALLY PROJECTED WITH BOTH ENTRIES AND CROSS CUT CENTERS OF 50 FEET. CROSS CUTS ARE TURNED ON ANGLES OF AT LEAST 60 DEGREES . THESE PROJECTIONS ARE HOWEVER SUBJECT TO CHANGE AS MINING CONDITIONS MAY DICTATE.
MINE WORKS TO DATE, 7/29/99, K.W.B.
MINE WORKS TO DATE, 2/1/00, K.W.B.
MINE WORKS TO DATE, 7/28/00, K.W.B.
MINE WORKS TO DATE, 12/13/00, K.W.B.
MINE WORKS TO DATE, 2/1/01, K.W.B
MINE WORKS TO DATE, 8/3/01, K.W.B
MINE WORKS TO DATE, 1/31/02, K.W.B
MINE WORKS TO DATE, 6/14/02, K.W.B
APPROVED:
KEVIN W. BLOOM, P.E.
SEAL
REG. NO.: 35160-E
DATE:
THIS MAP SHOWS THE FINAL WORKINGS OF THE LAUREL RIDGE MINE. FINAL COAL EXTRACTION OCCURED ON OR PRIOR TO 6/14/02.
9/30/02
KEVIN W. BLOOM, P.E.
COMMONWEALTH OF PENNSYLVANIA
REGISTERED PROFESSIONAL
KEVIN W. BLOOM
ENGINEER
No. 35160-E
Sheet 3
Laurel Run Reclamation Company, Inc.
Laurel Ridge Mine
Permit No. 17941301
Brady, Union, Sandy Townships
Clearfield County
SCALE: 1"=100'
1 / 29 / 96
HESS & FISHER ENGINEERS, INC.
CONSULTING ENGINEERS & GEOLOGISTS
36 NORTH SECOND STREET
CLEARFIELD, PA 16830 814-765-7541
D:\LAUREL\LRWORKS.DWG