


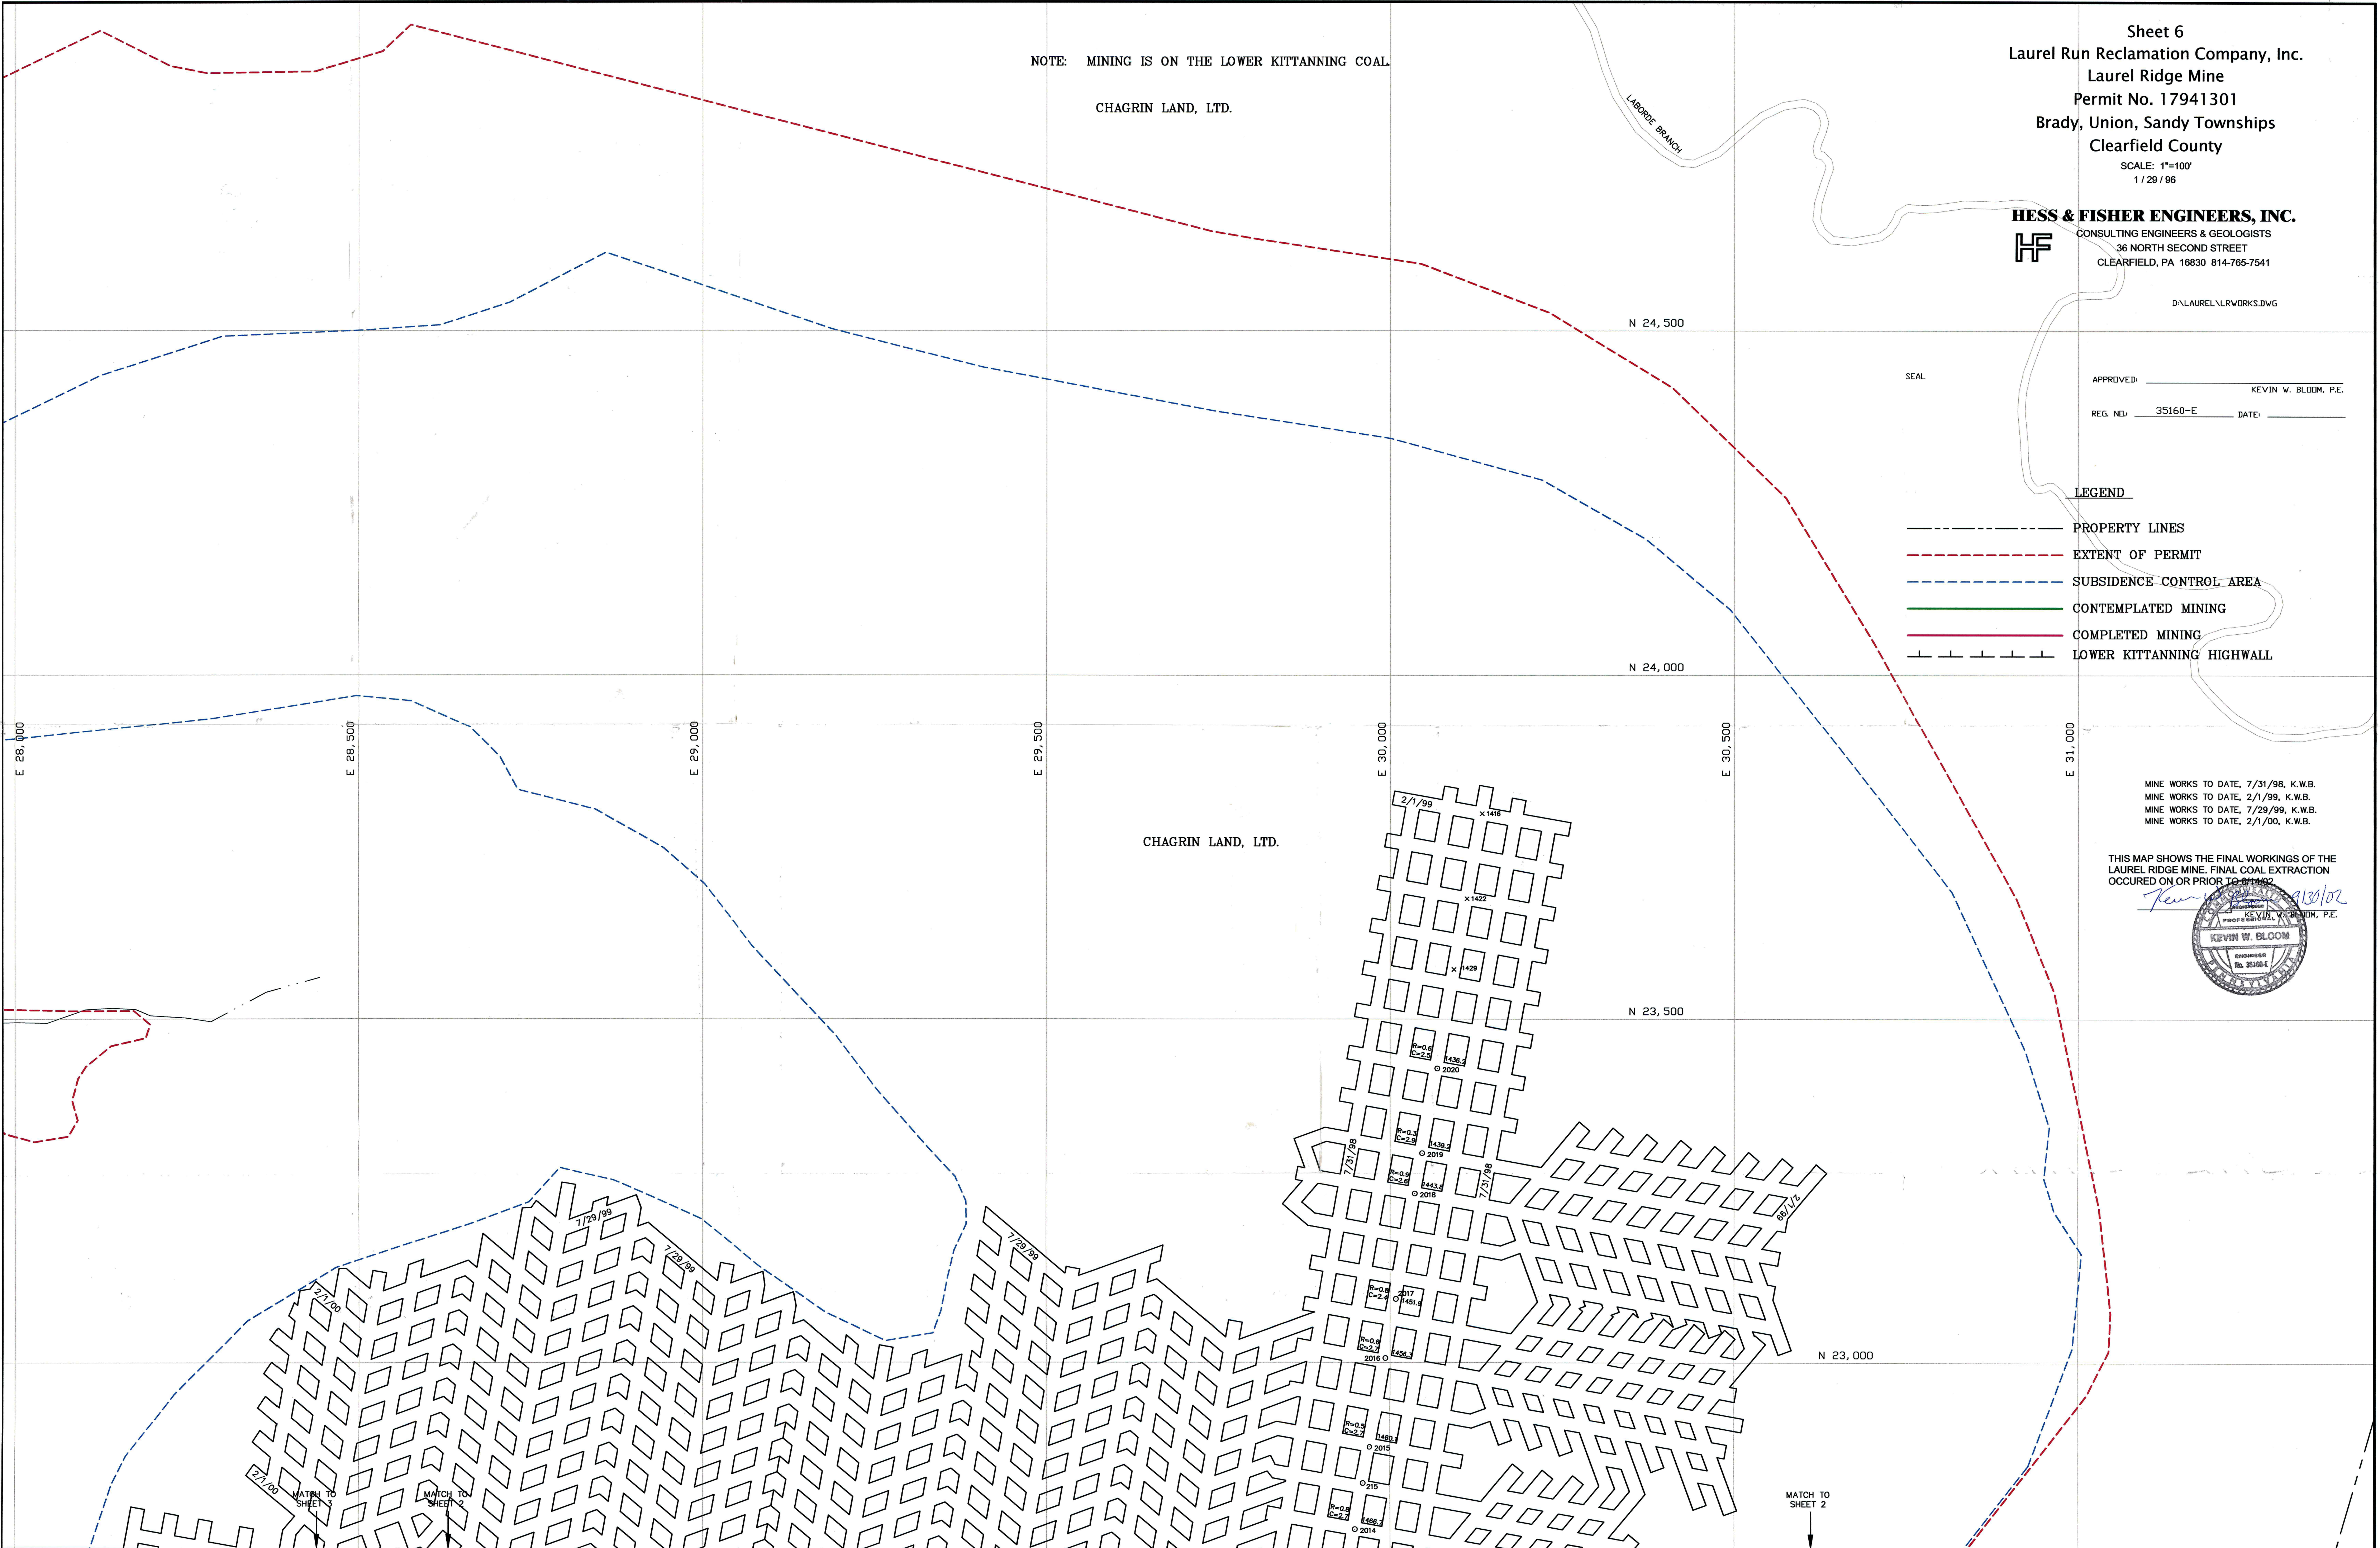

NOTE: MINING IS ON THE LOWER KITTANNING COAL.

CHAGRIN LAND, LTD.

Sheet 6
Laurel Run Reclamation Company, Inc.
Laurel Ridge Mine
Permit No. 17941301
Brady, Union, Sandy Townships
Clearfield County

SCALE: 1"=100'
1 / 29 / 96

HESS & FISHER ENGINEERS, INC.
CONSULTING ENGINEERS & GEOLOGISTS
36 NORTH SECOND STREET
CLEARFIELD, PA 16830 814-765-7541

D:\LAUREL\LRWORKS.DWG


APPROVED: _____ KEVIN W. BLOOM, P.E.
REG. NO. 35160-E DATE: _____

LEGEND

- PROPERTY LINES
- EXTENT OF PERMIT
- SUBSIDENCE CONTROL AREA
- CONTEMPLATED MINING
- COMPLETED MINING
- LOWER KITTANNING HIGHWALL

MINE WORKS TO DATE, 7/31/98, K.W.B.
MINE WORKS TO DATE, 2/1/99, K.W.B.
MINE WORKS TO DATE, 7/29/99, K.W.B.
MINE WORKS TO DATE, 2/1/00, K.W.B.

THIS MAP SHOWS THE FINAL WORKINGS OF THE
LAUREL RIDGE MINE. FINAL COAL EXTRACTION
OCCURRED ON OR PRIOR TO 201402

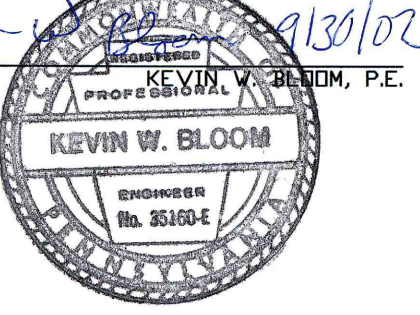

MATCH TO
SHEET 5

MATCH TO
SHEET 7

MATCH TO
SHEET 2