


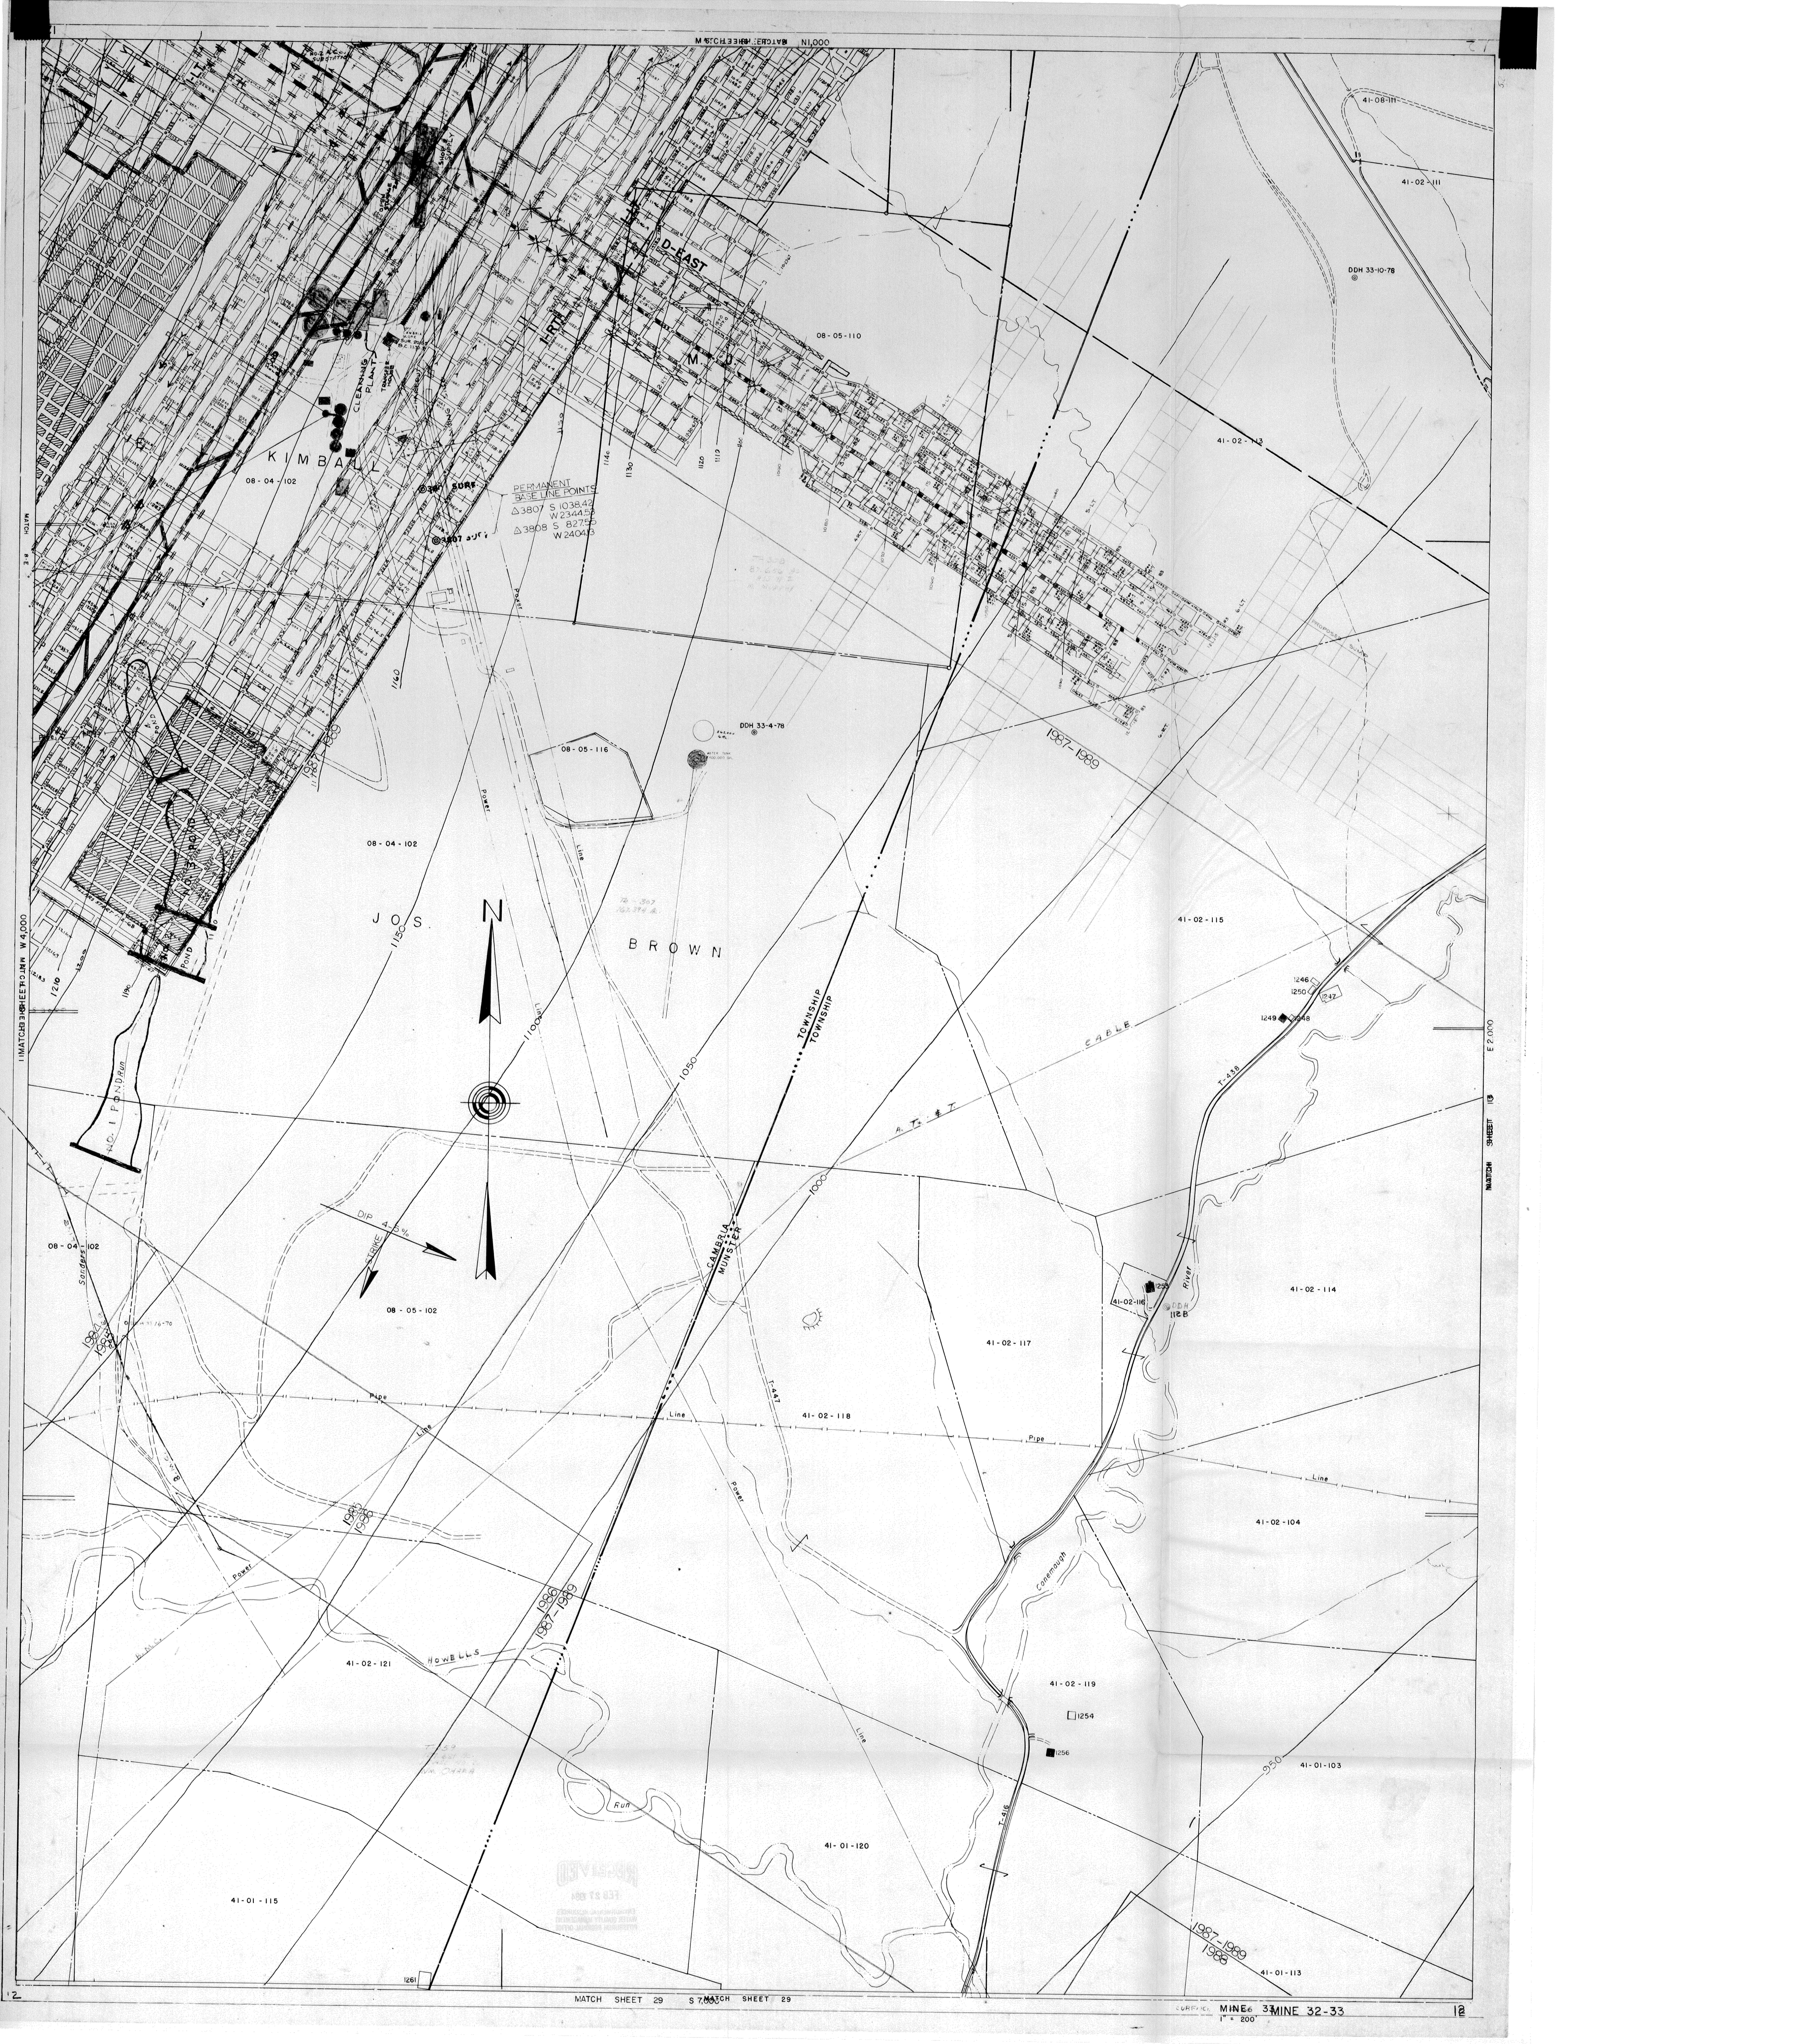

0000 N MATCH SHEET 29



MATCH SHEET 29 S MATCH SHEET 29

MINE 32-33