


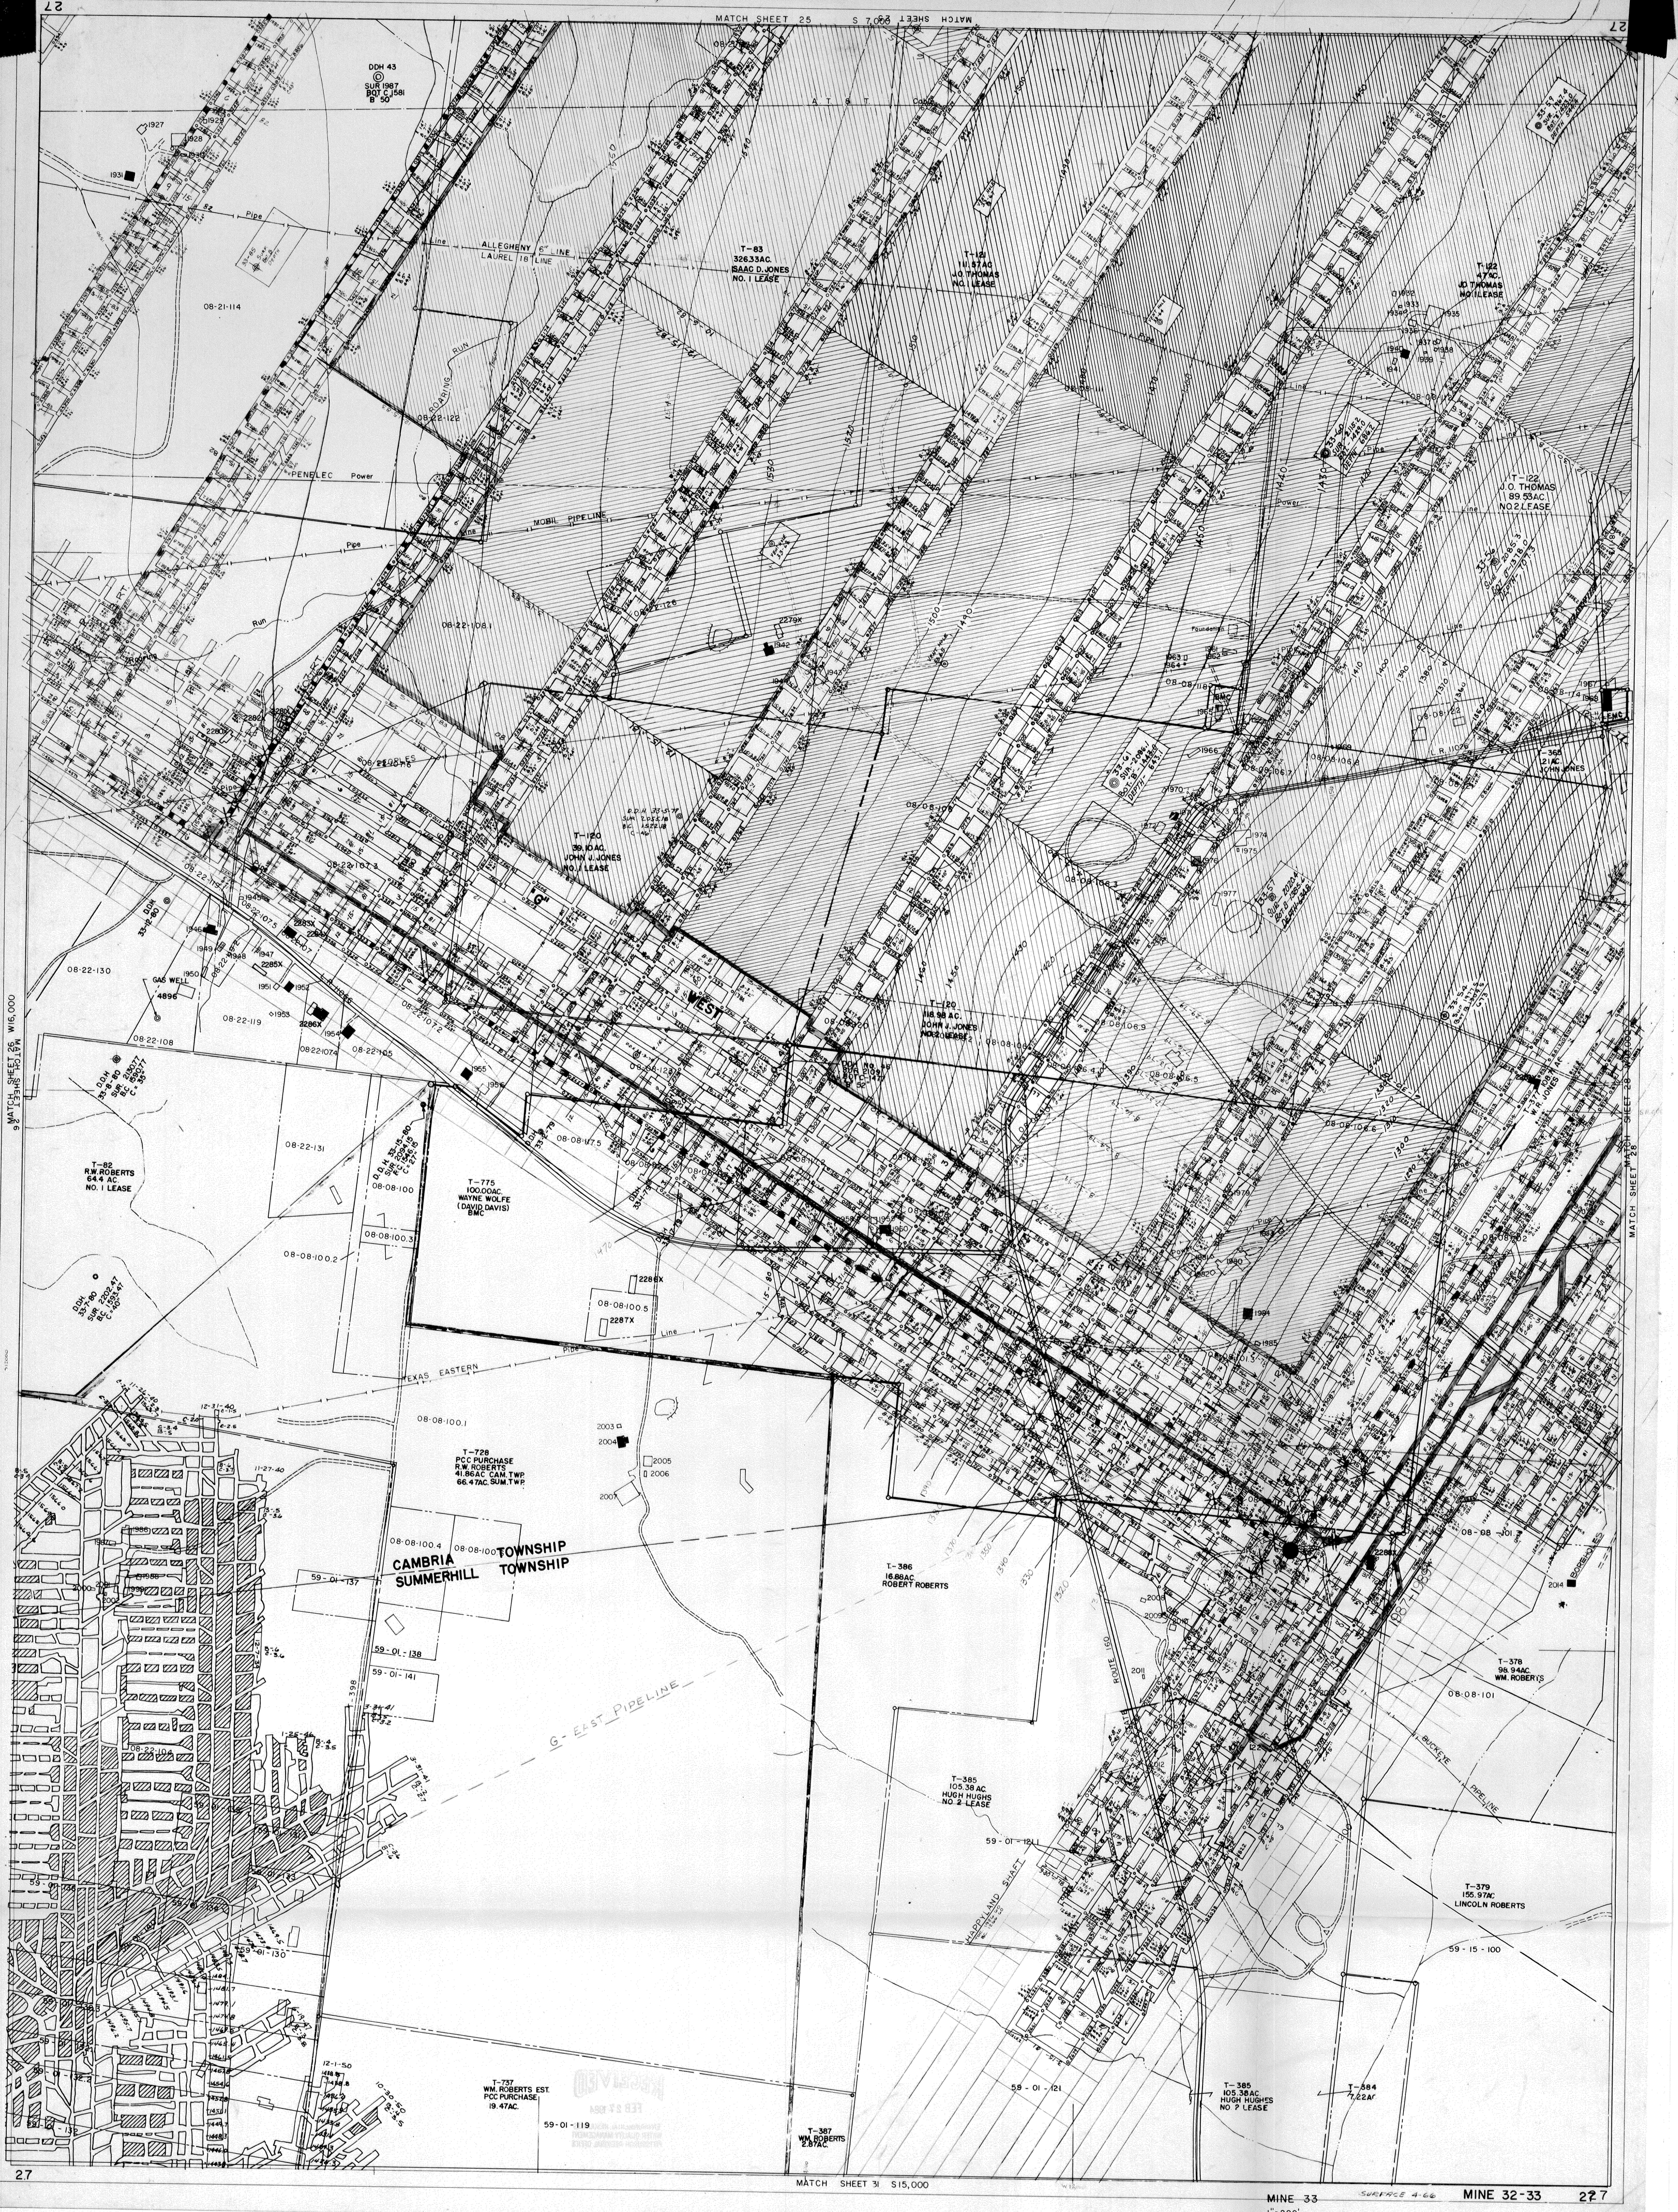

MATCH SHEET 26 W.E.000

MATCH SHEET 28 W.E.000