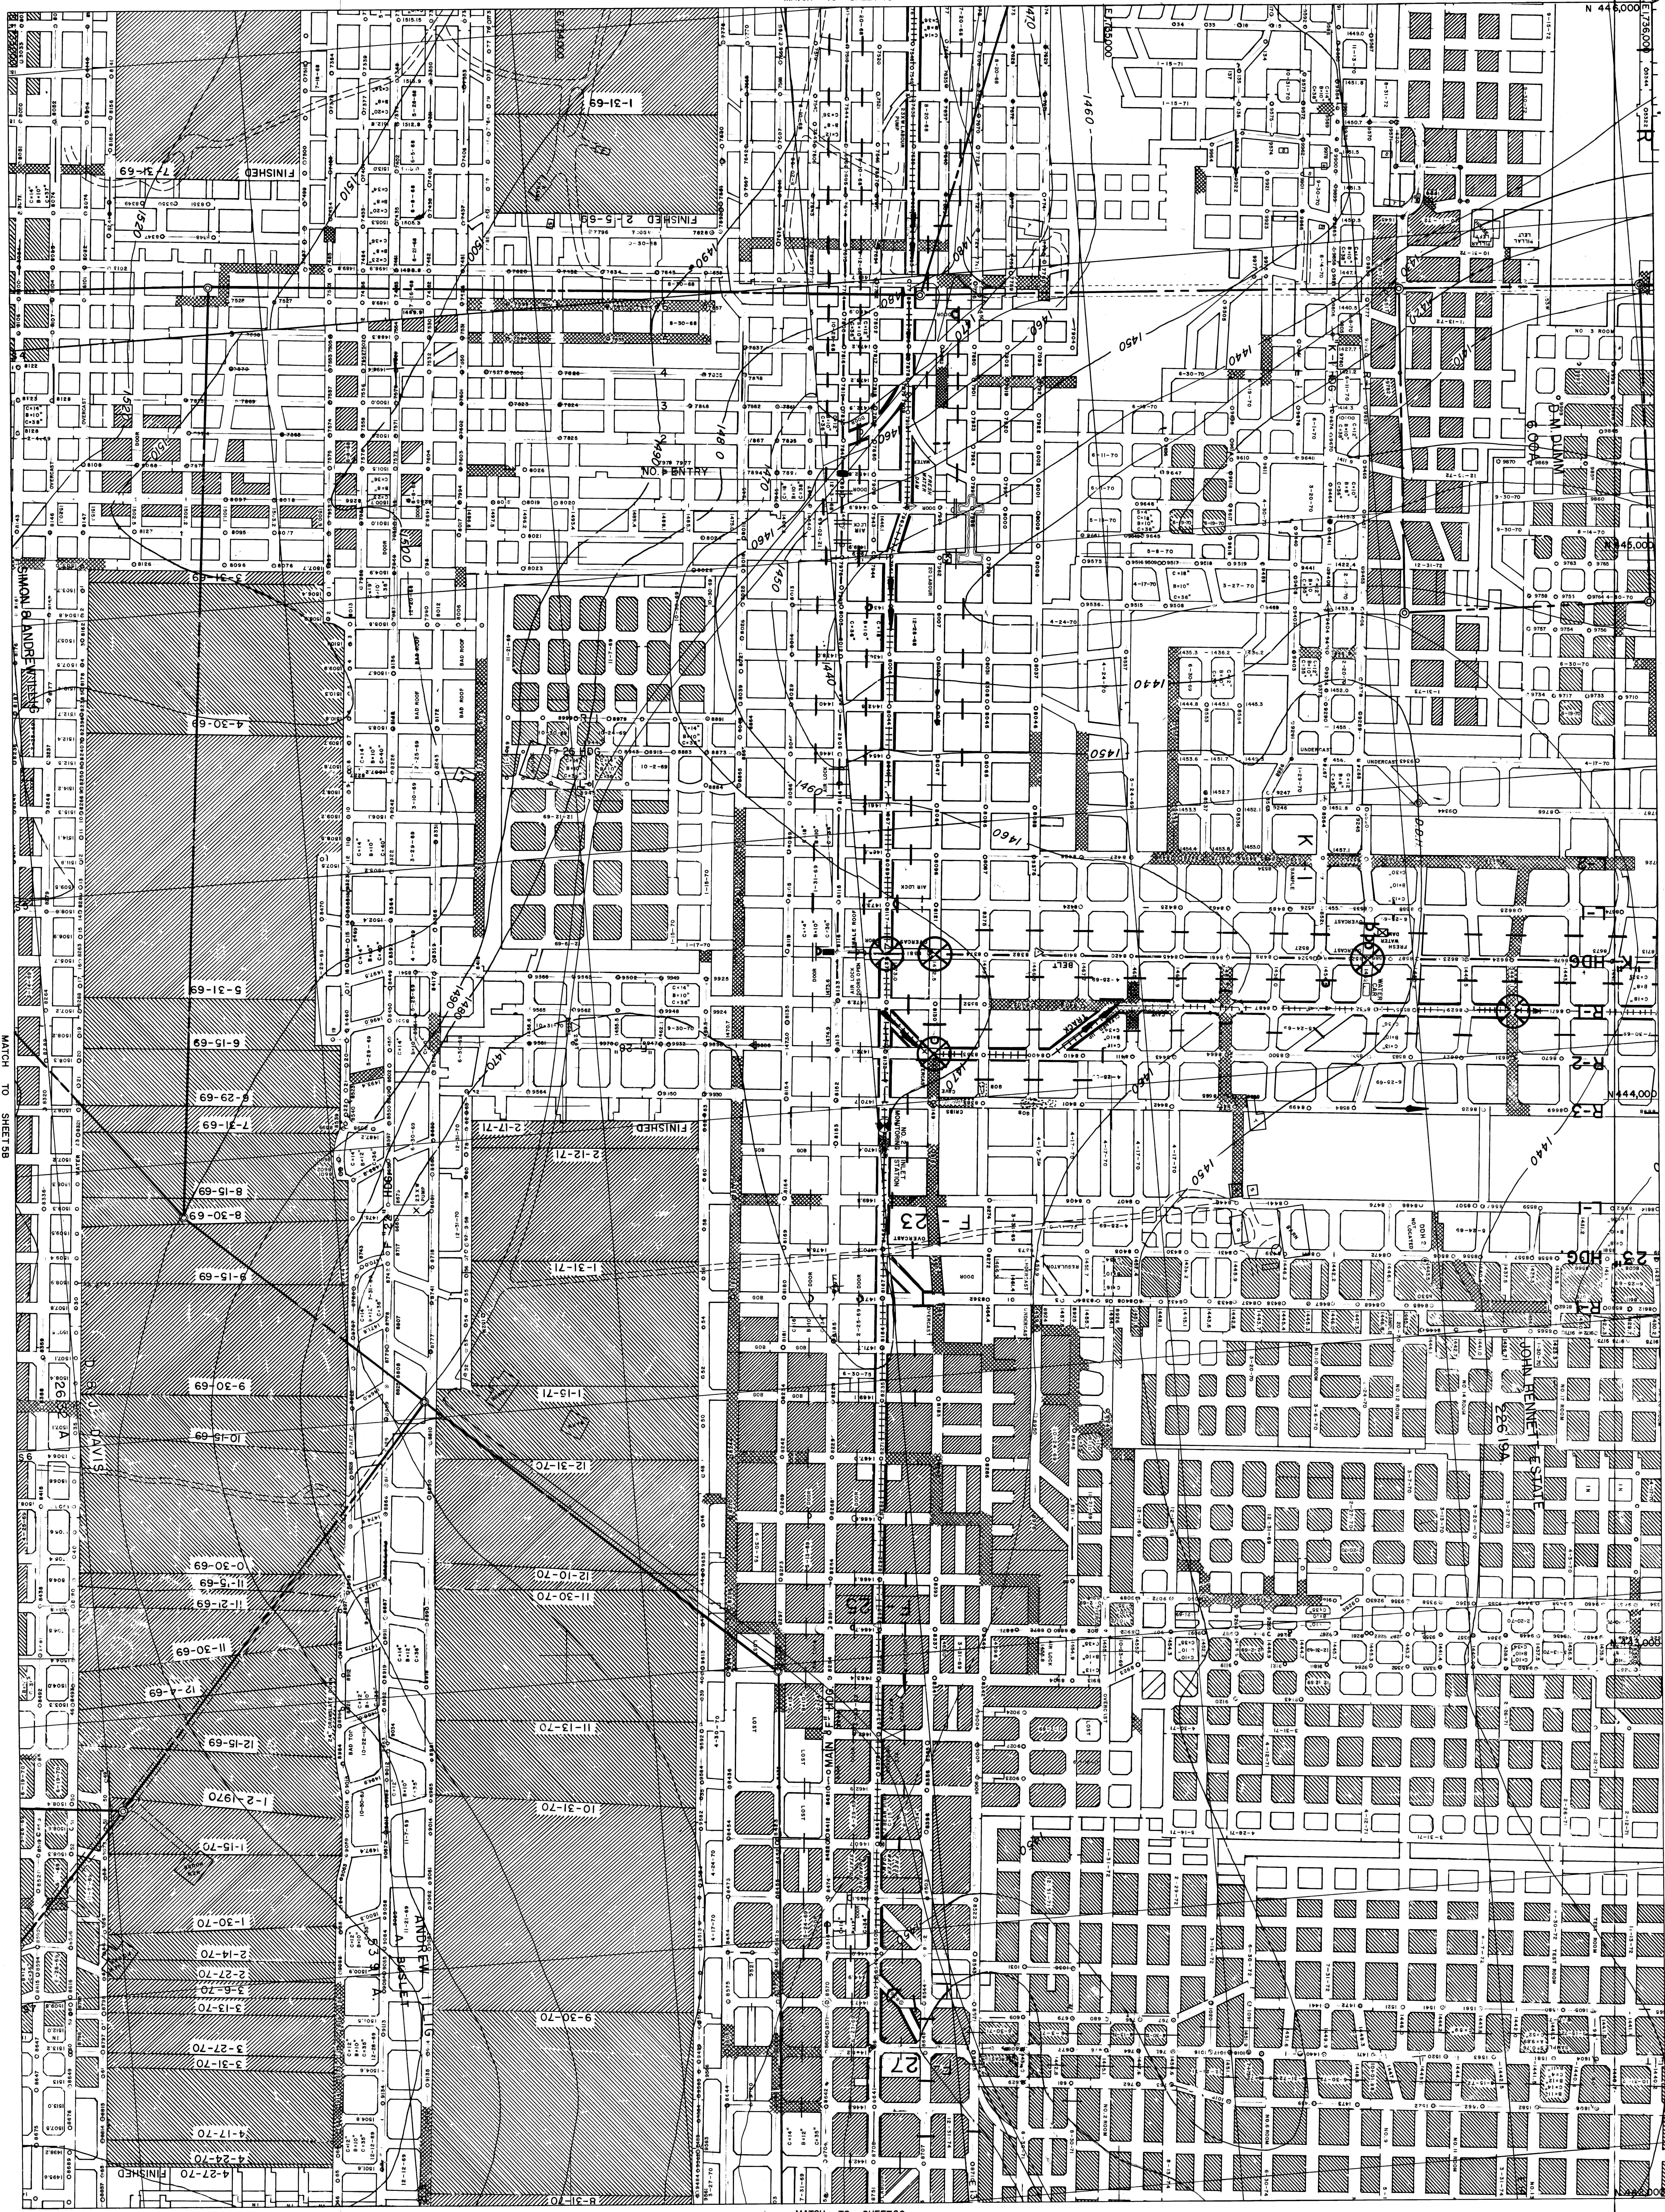


BARNE & TUCKER COMPANY  
LAW OFFICE  
EAST CARROLL TOWNSHIP, CAMBERIA COUNTY, PENNSYLVANIA  
SCALE 1"=100'  
DATE JULY 1976