


MATCH TO SHEET 5C

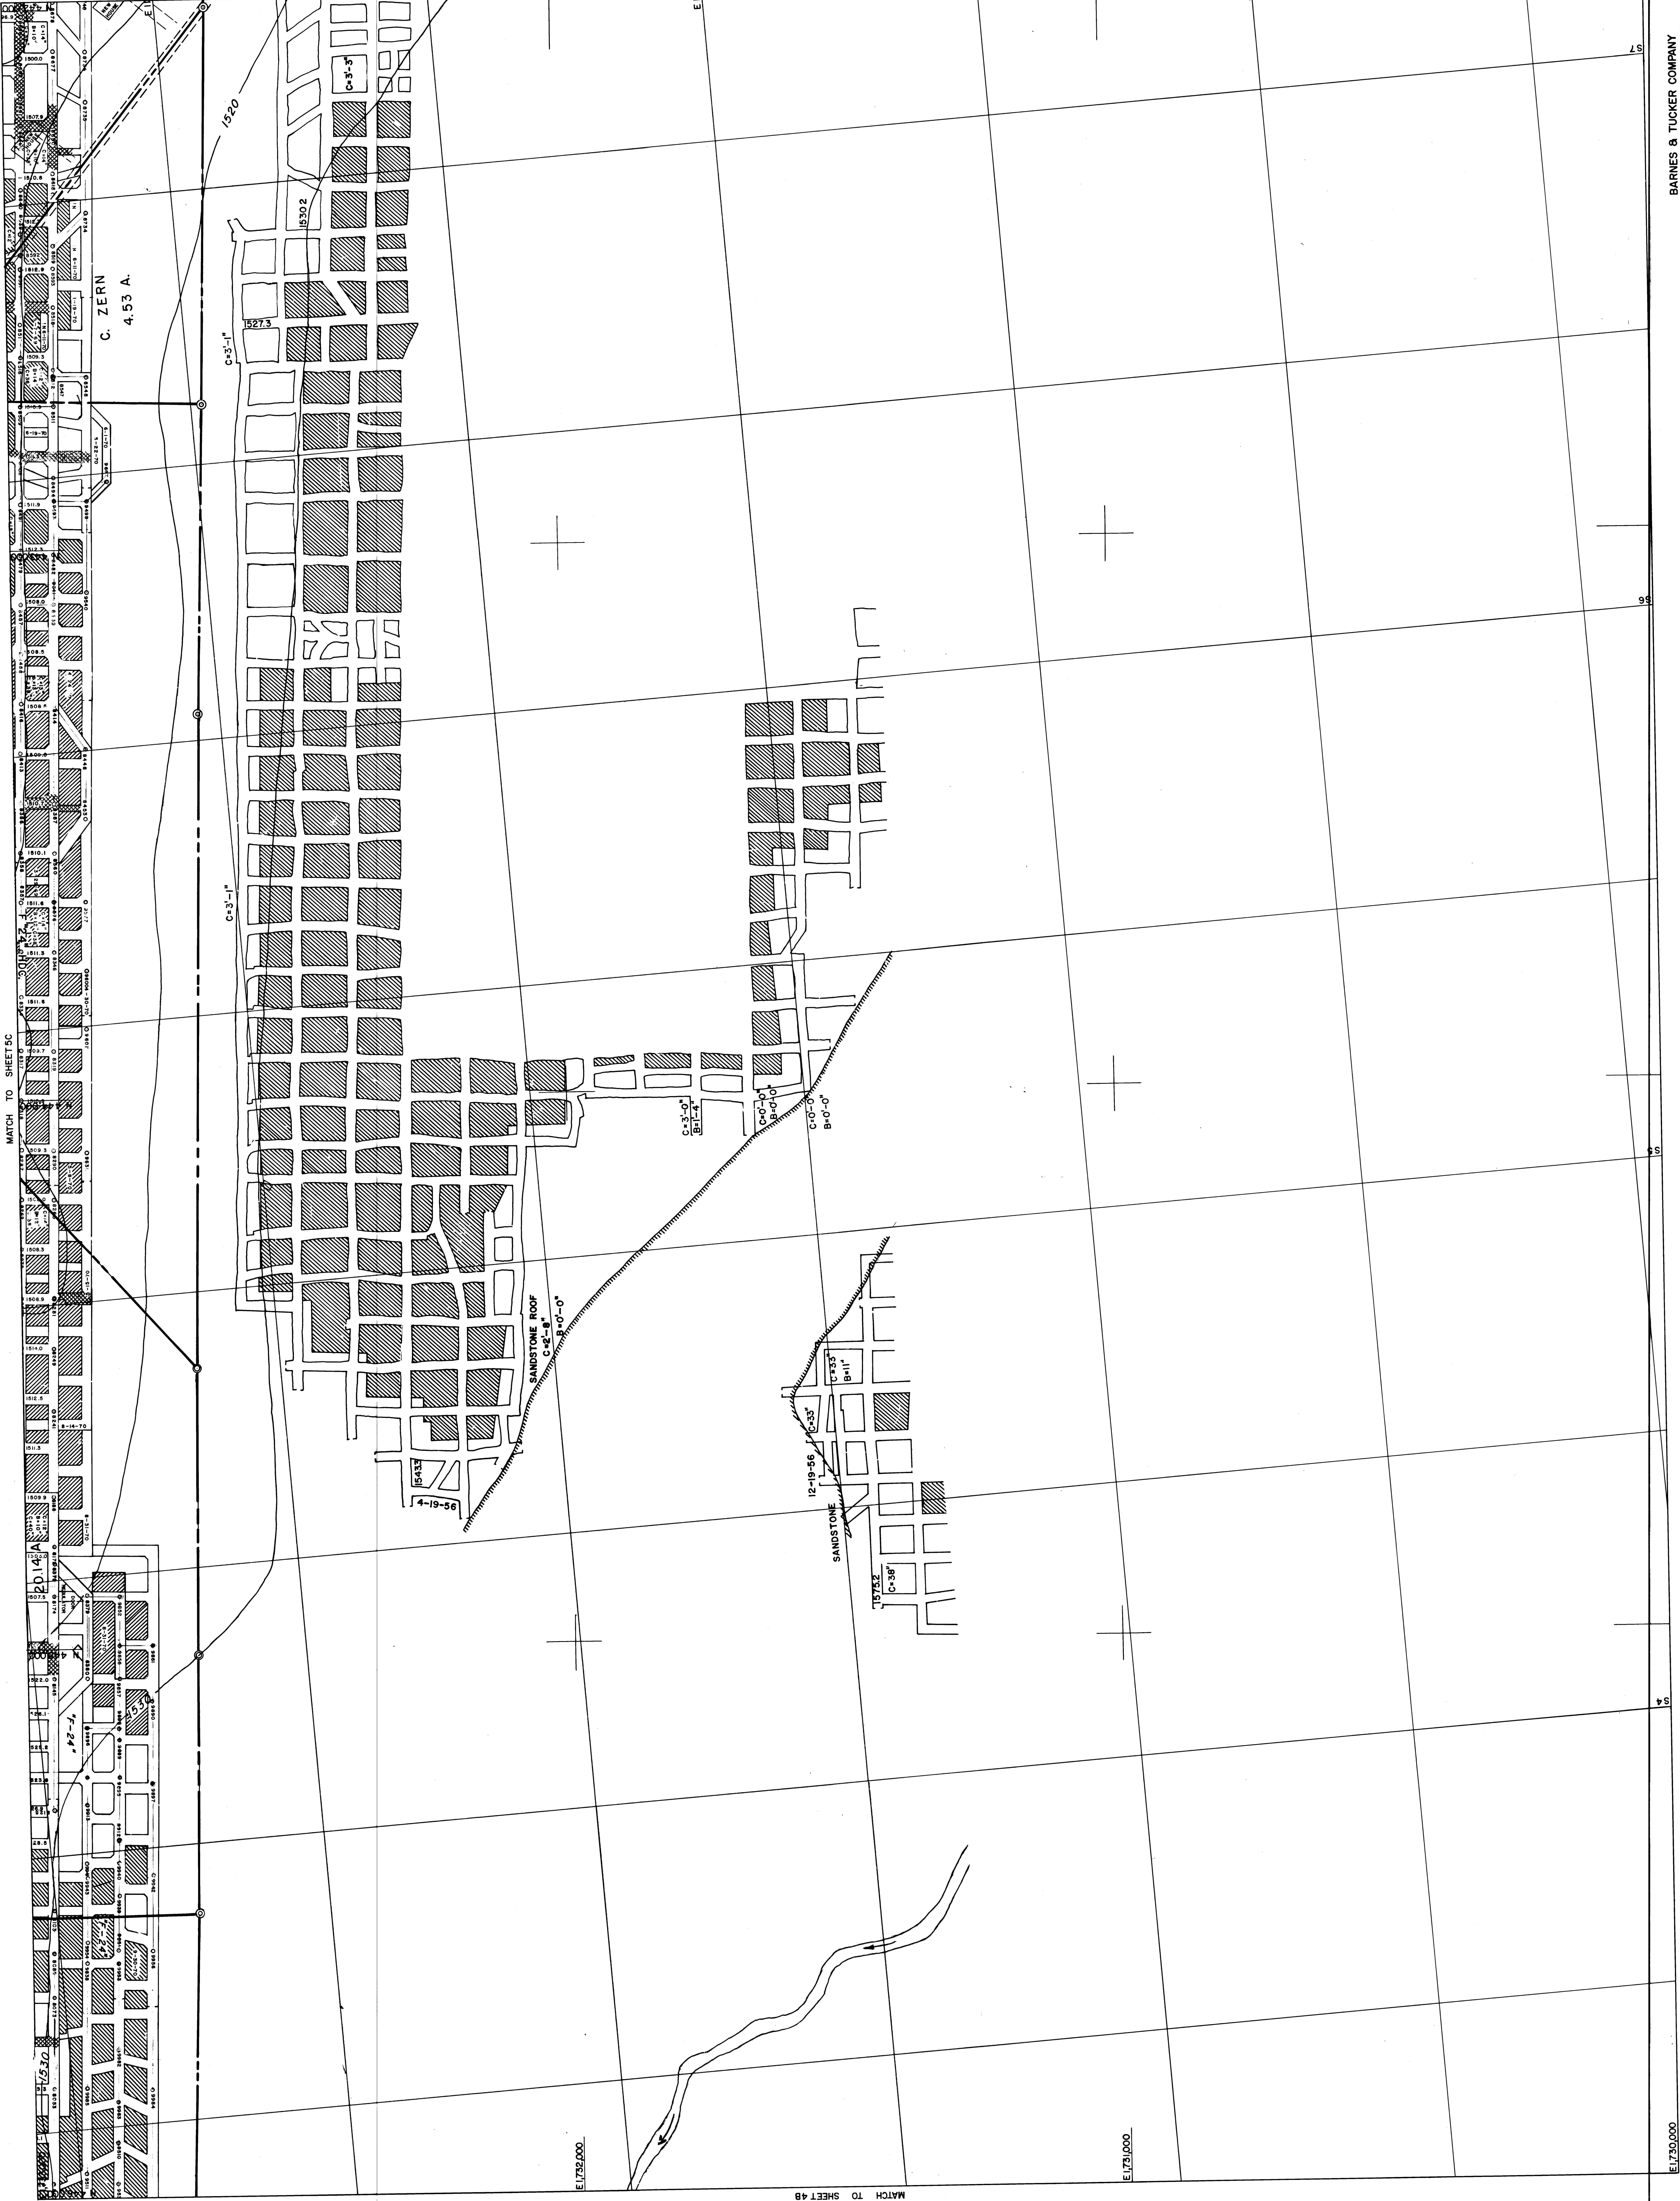

MATCH TO SHEET 4B

MATCH TO SHEET 6B

E1730.000

E1731.000

E1732.000

FINAL MAPPING DATE: 01-29-86

1:2500

BARNES & TUCKER COMPANY
LANCASHIRE NO. 20 MINE
EAST CARROLL TOWNSHIP, CAMBRIA COUNTY, PENNSYLVANIA
SCALE: 1"=100'
DATE: JULY, 1976

5B