


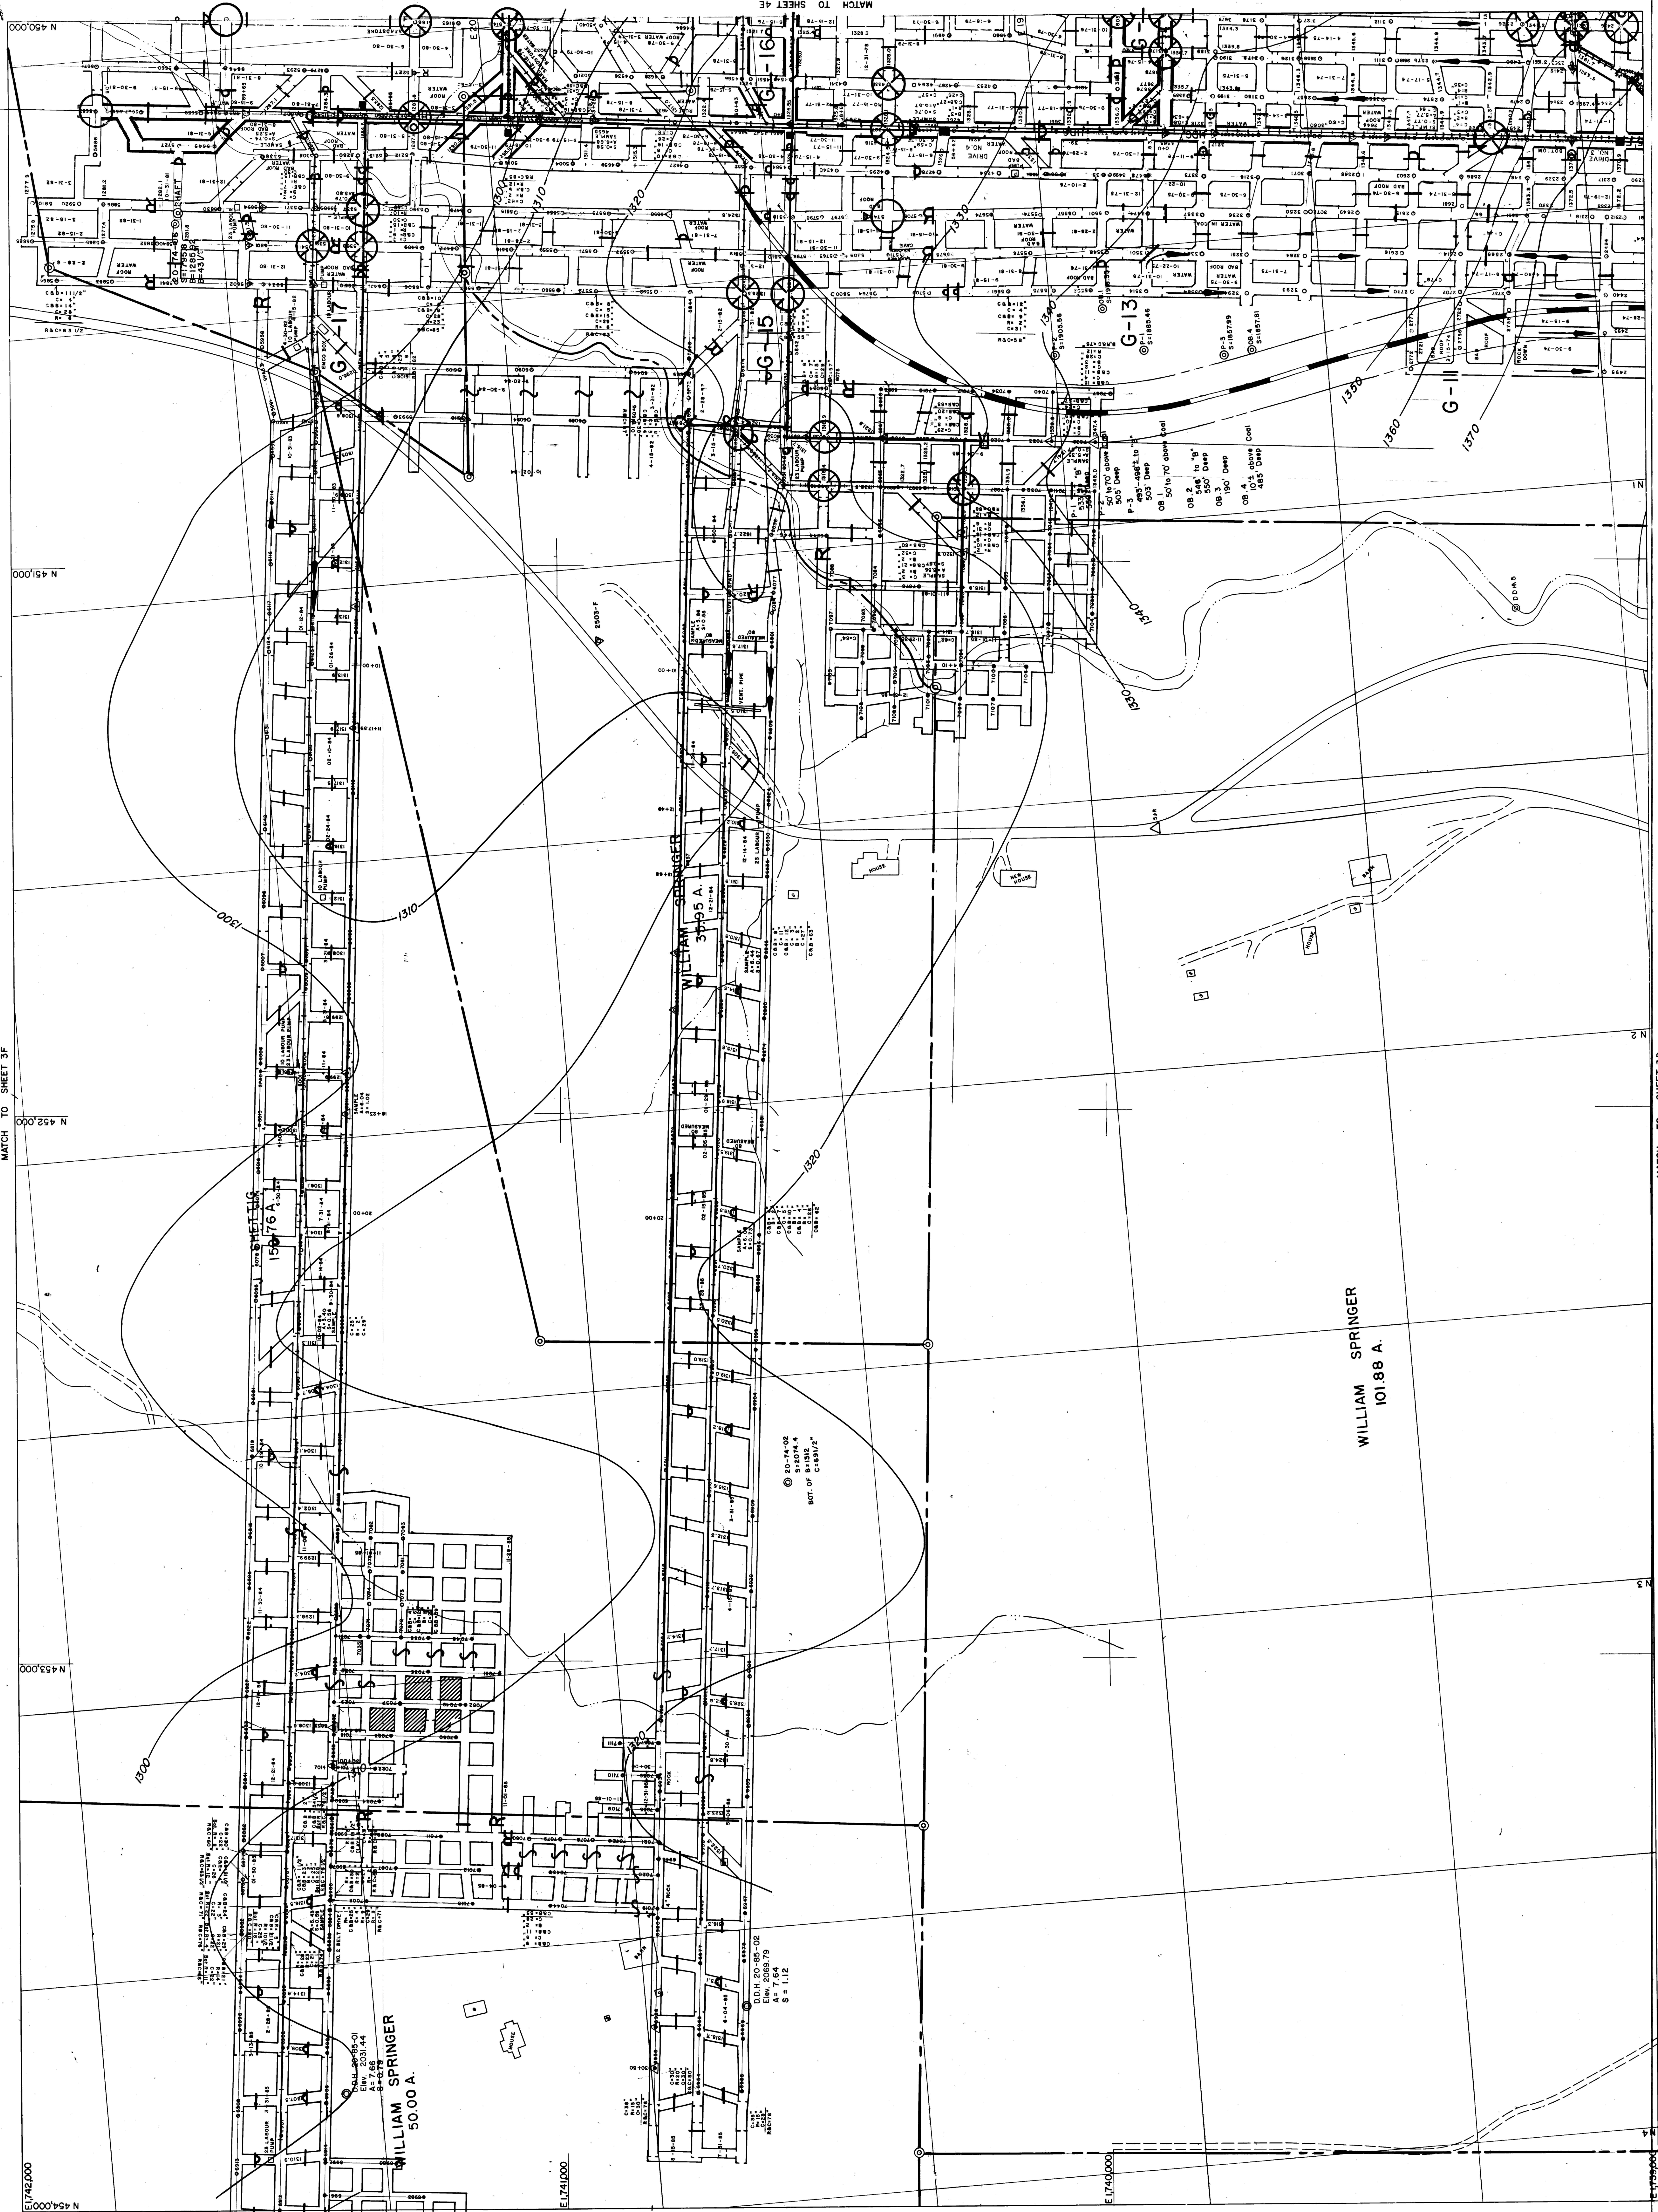

MATCH TO SHEET 3P

MATCH TO SHEET 3 D

FINAL MAPPING DATE: 01-29-86

BARNES & TUCKER COMPANY
LANCASHIRE NO. 20 MINE
EAST CARROLL TOWNSHIP, CAMBRIA COUNTY, PENNSYLVANIA
DATE: 1111 Y 1976
LOCAL F. 11-1001