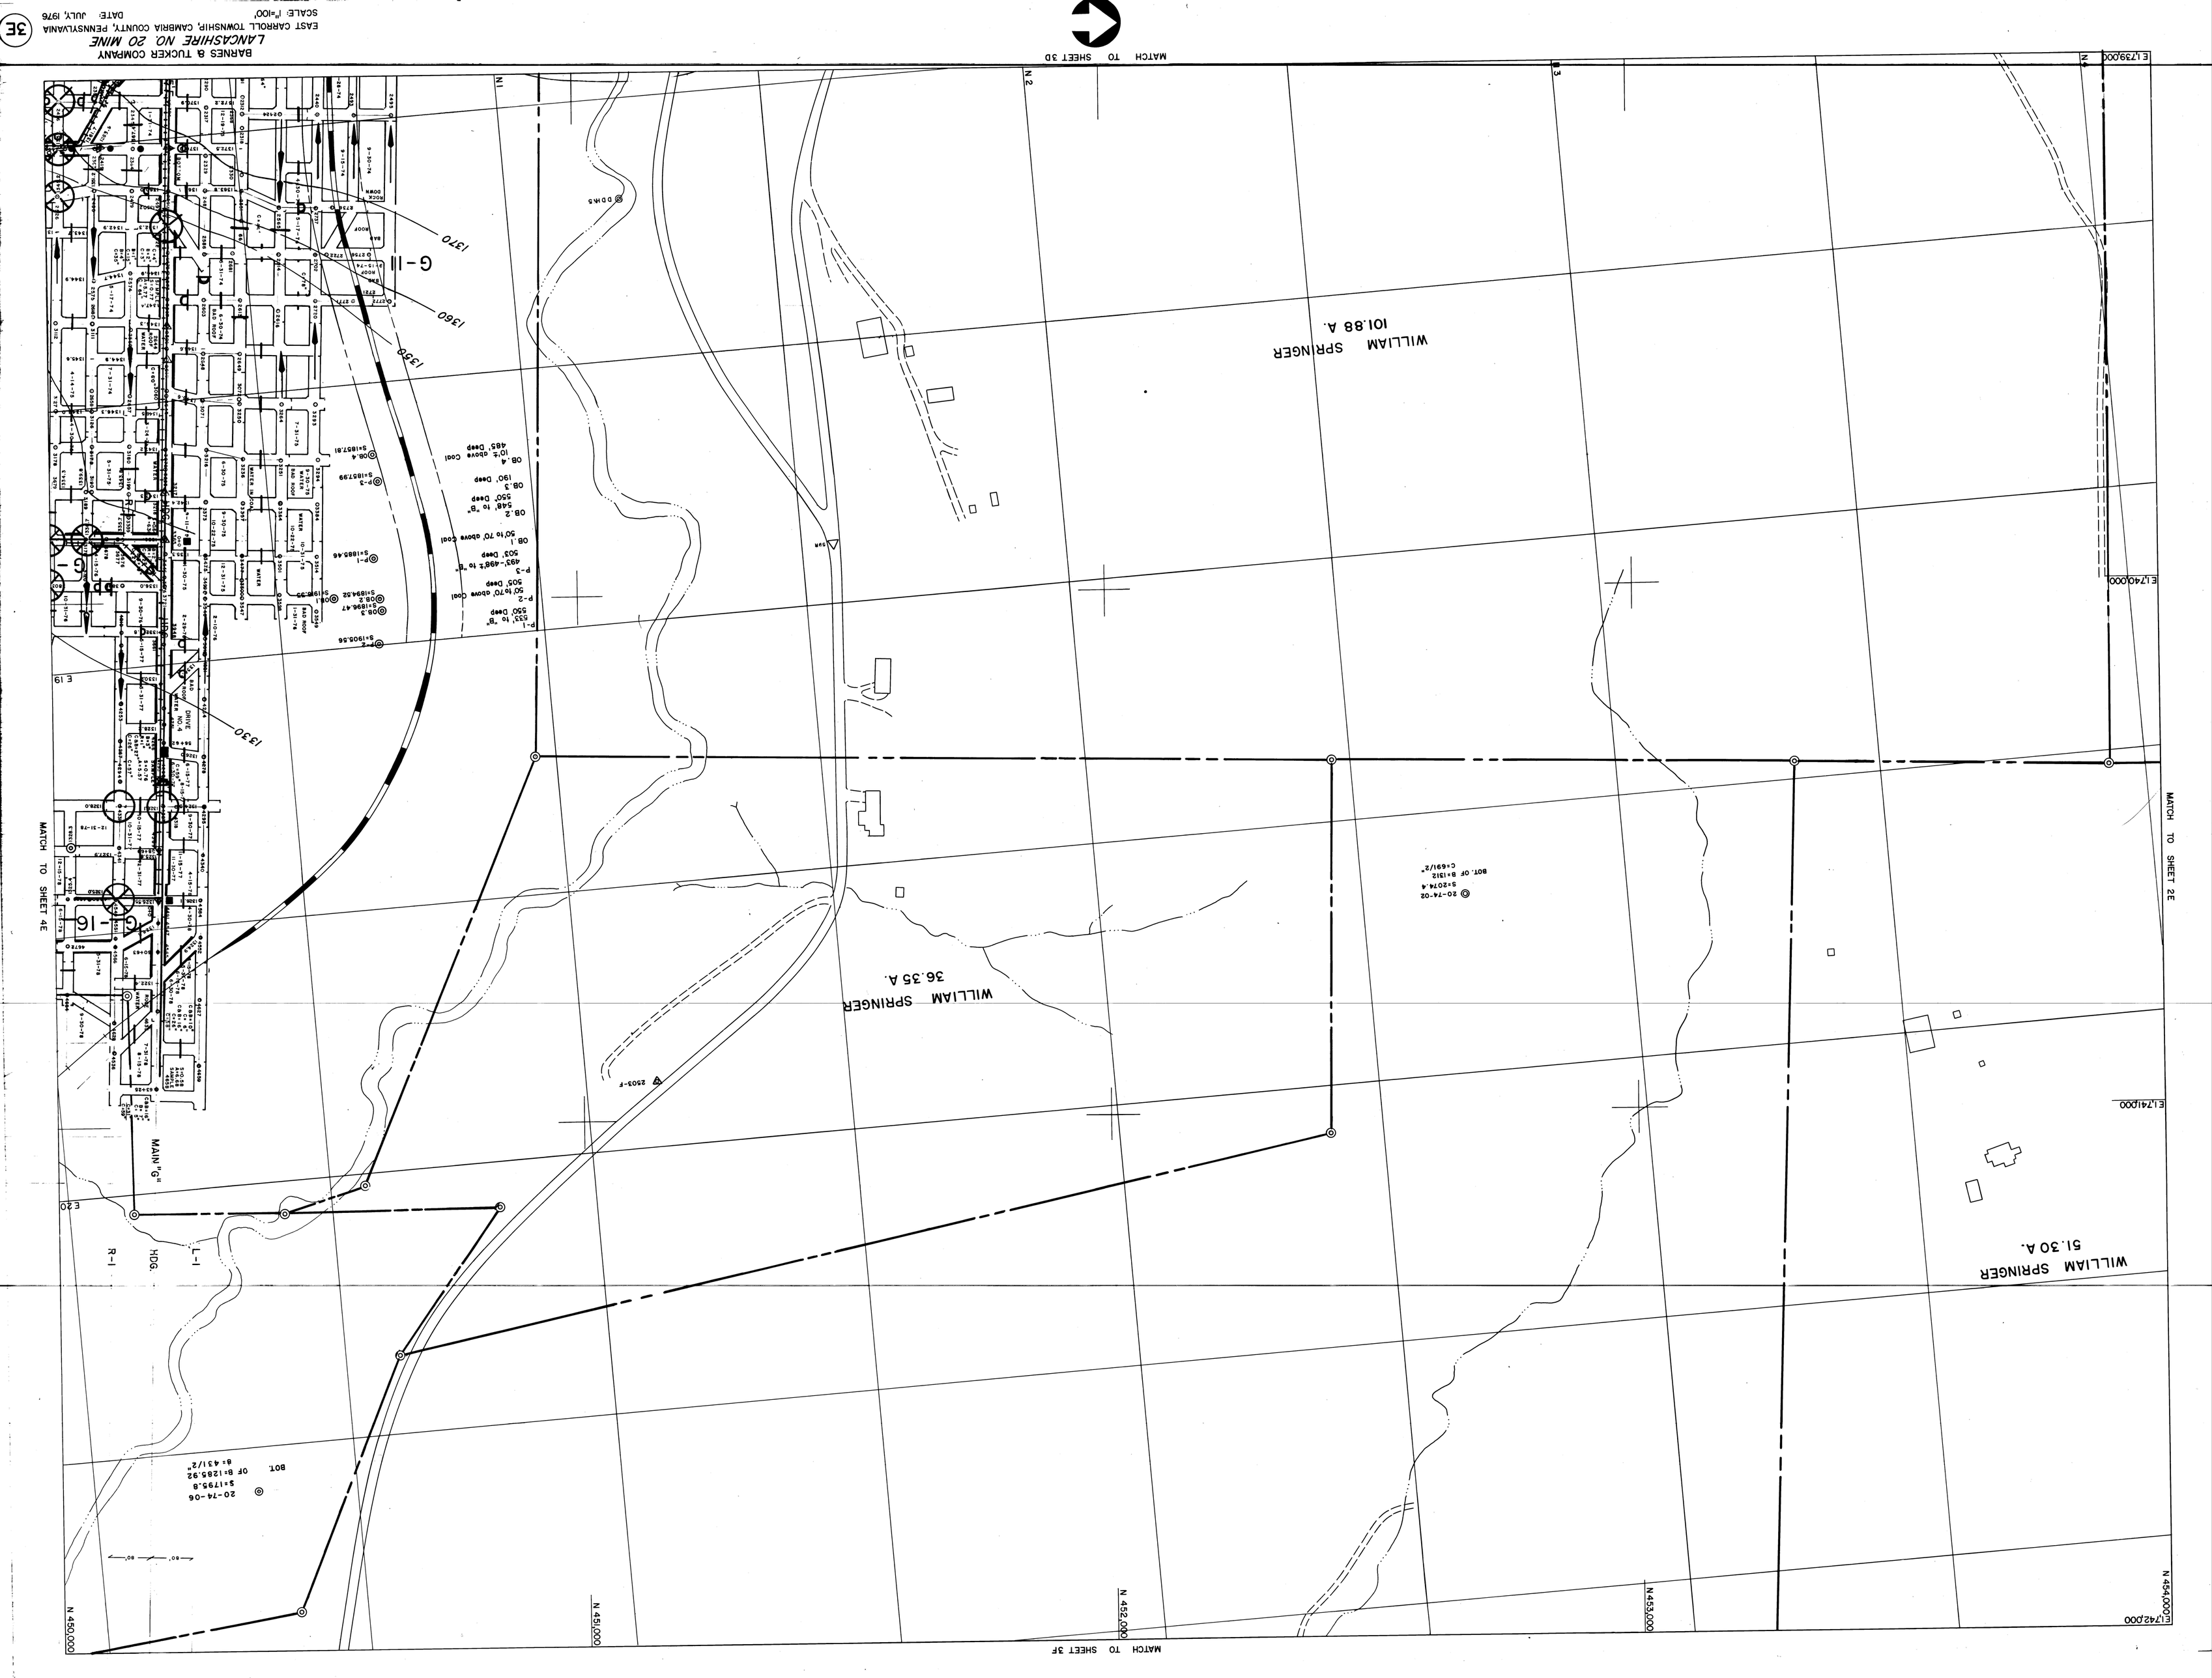
BARNES & TUCKER COMPANY
LANCASHIRE NO 20 MINE
EAST CARROLL TOWNSHIP, CAMBRIA COUNTY, PENNSYLVANIA
SCALE: 1"=100'
DATE: JULY, 1976
3E
MATCH TO SHEET 3D
MATCH TO SHEET 3F
MATCH TO SHEET 2E
MATCH TO SHEET 4E
N 450,000
N 451,000
N 452,000
N 453,000
N 454,000
E 1,742,000
E 1,740,000
E 1,741,000
E 1,739,000
WILLIAM SPRINGER
101.88 A.
WILLIAM SPRINGER
36.35 A.
WILLIAM SPRINGER
51.30 A.
MAIN "G"
HDG.
R-1
L-1
G-16
G-11
1330
1360
1370
1390
20-74-02
S=20174.4
BOT. OF B=1312
C=69 1/2"
20-74-06
S=1795.8
BOT. OF B=1285.92
B=43 1/2"
2503-F
P-1
P-2
P-3
OB.1
OB.2
OB.3
OB.4
P-2
P-3
P-1
OB.2
OB.3
OB.4
S=1905.56
S=1896.47
S=1894.62
S=1919.35
S=1885.46
S=1857.99
S=1857.81