


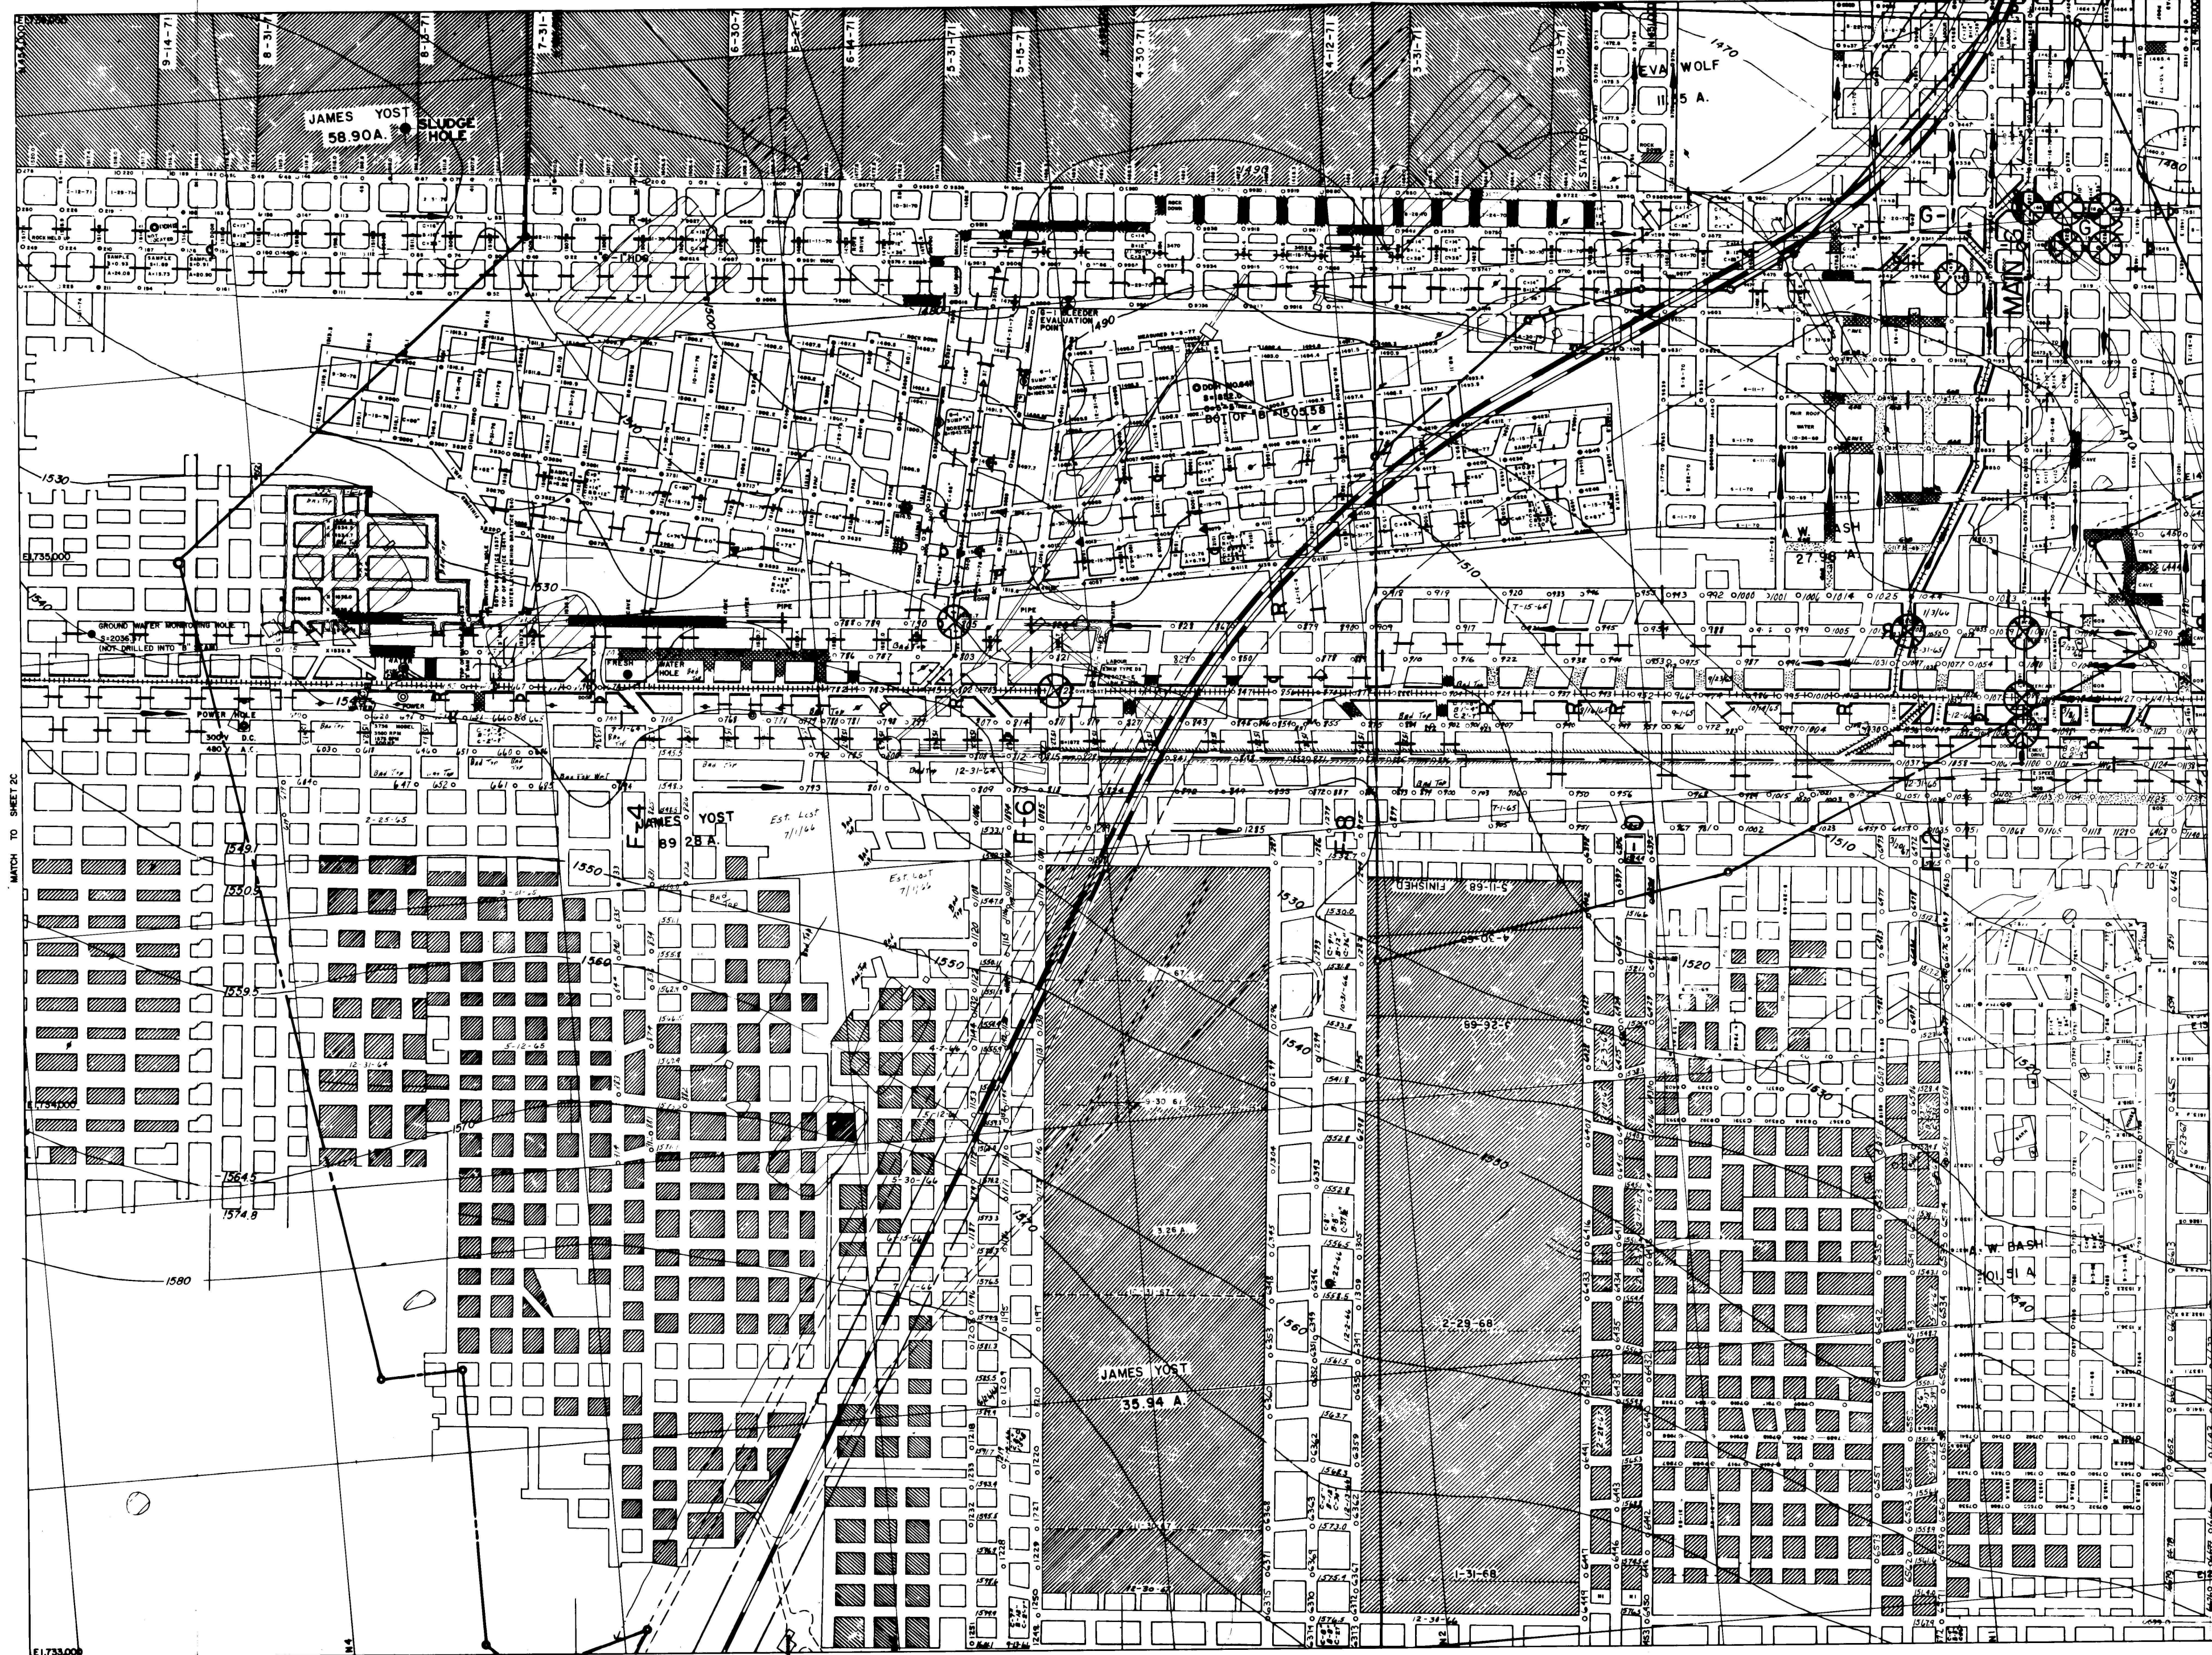

MATCH TO SHEET 2C

MATCH TO SHEET 4C

MATCH TO SHEET 3B

