


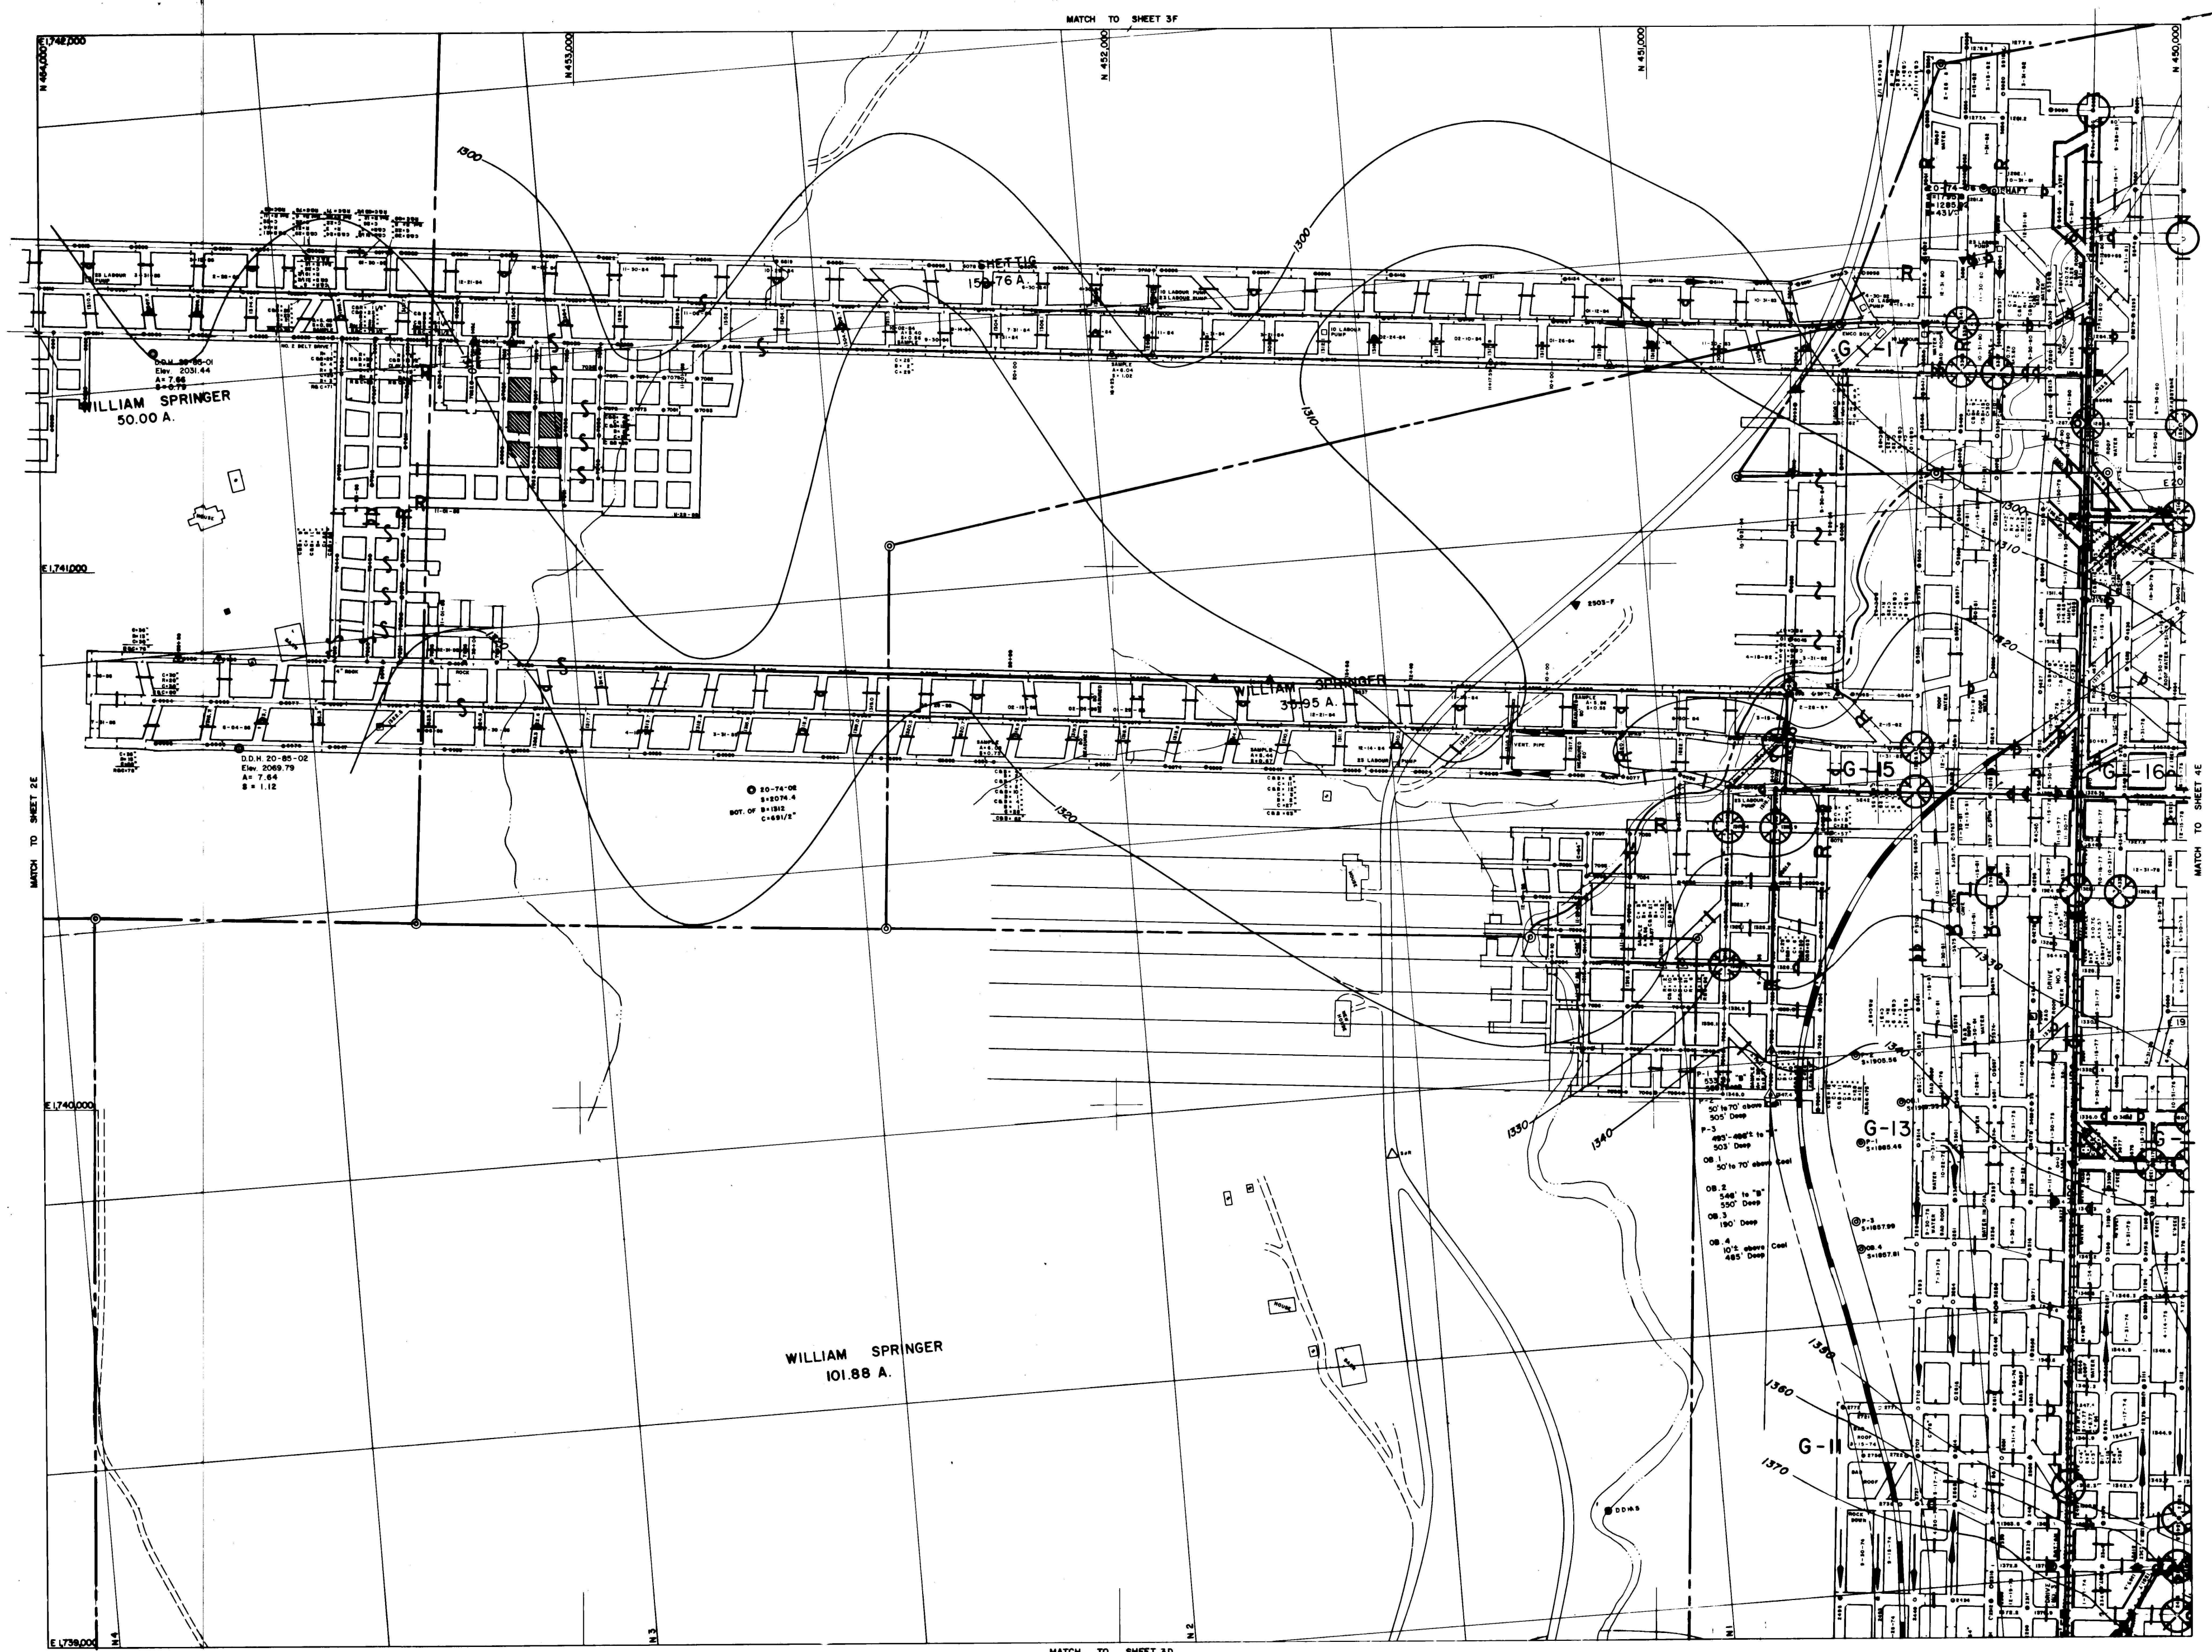

WILLIAM SPRINGER
101.88 A.

P-2
50' to 70' above
505' Deep

P-3
495' - 485' to "B"
503' Deep

OB.1
50' to 70' above
505' Deep

OB.2
548' to "B"
550' Deep

OB.3
190' Deep

OB.4
10' to "B" above
485' Deep

15


G-11