


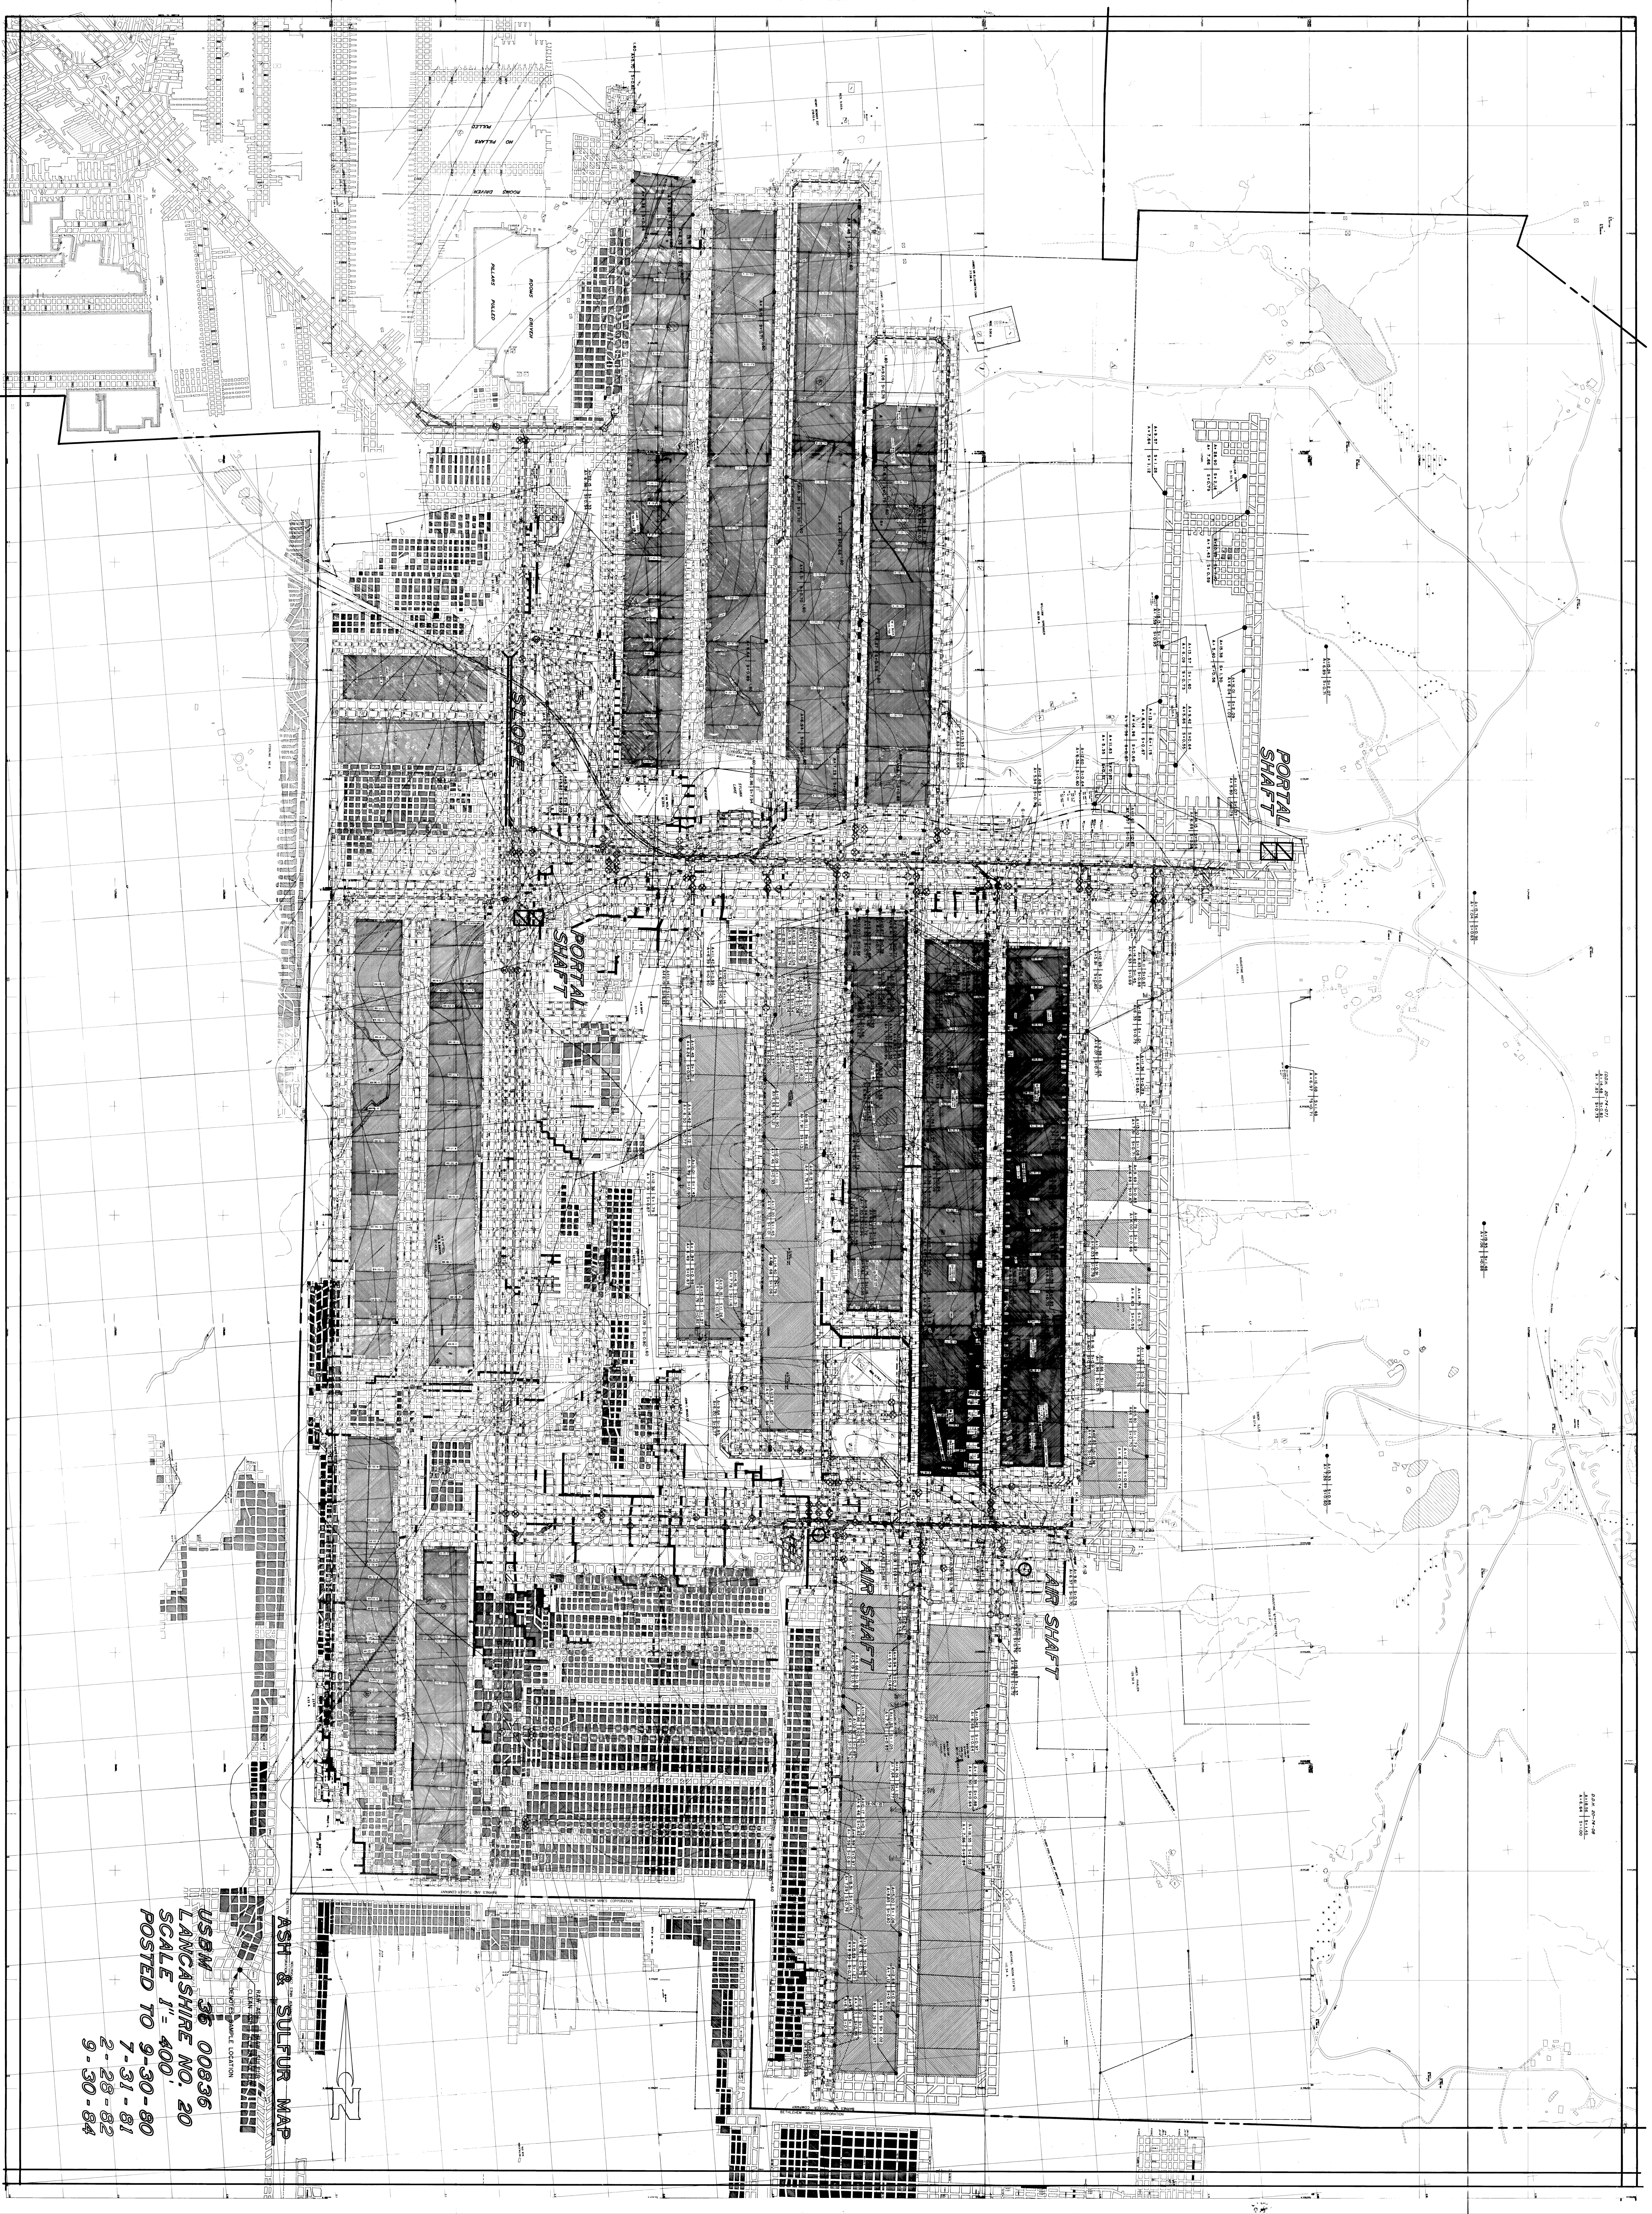

ASH & SULFUR MAP
USBM 36 00836
LANCASHIRE NO. 20
SCALE 1" = 400'
POSTED TO 9-30-80
7-31-81
2-28-82
9-30-84