


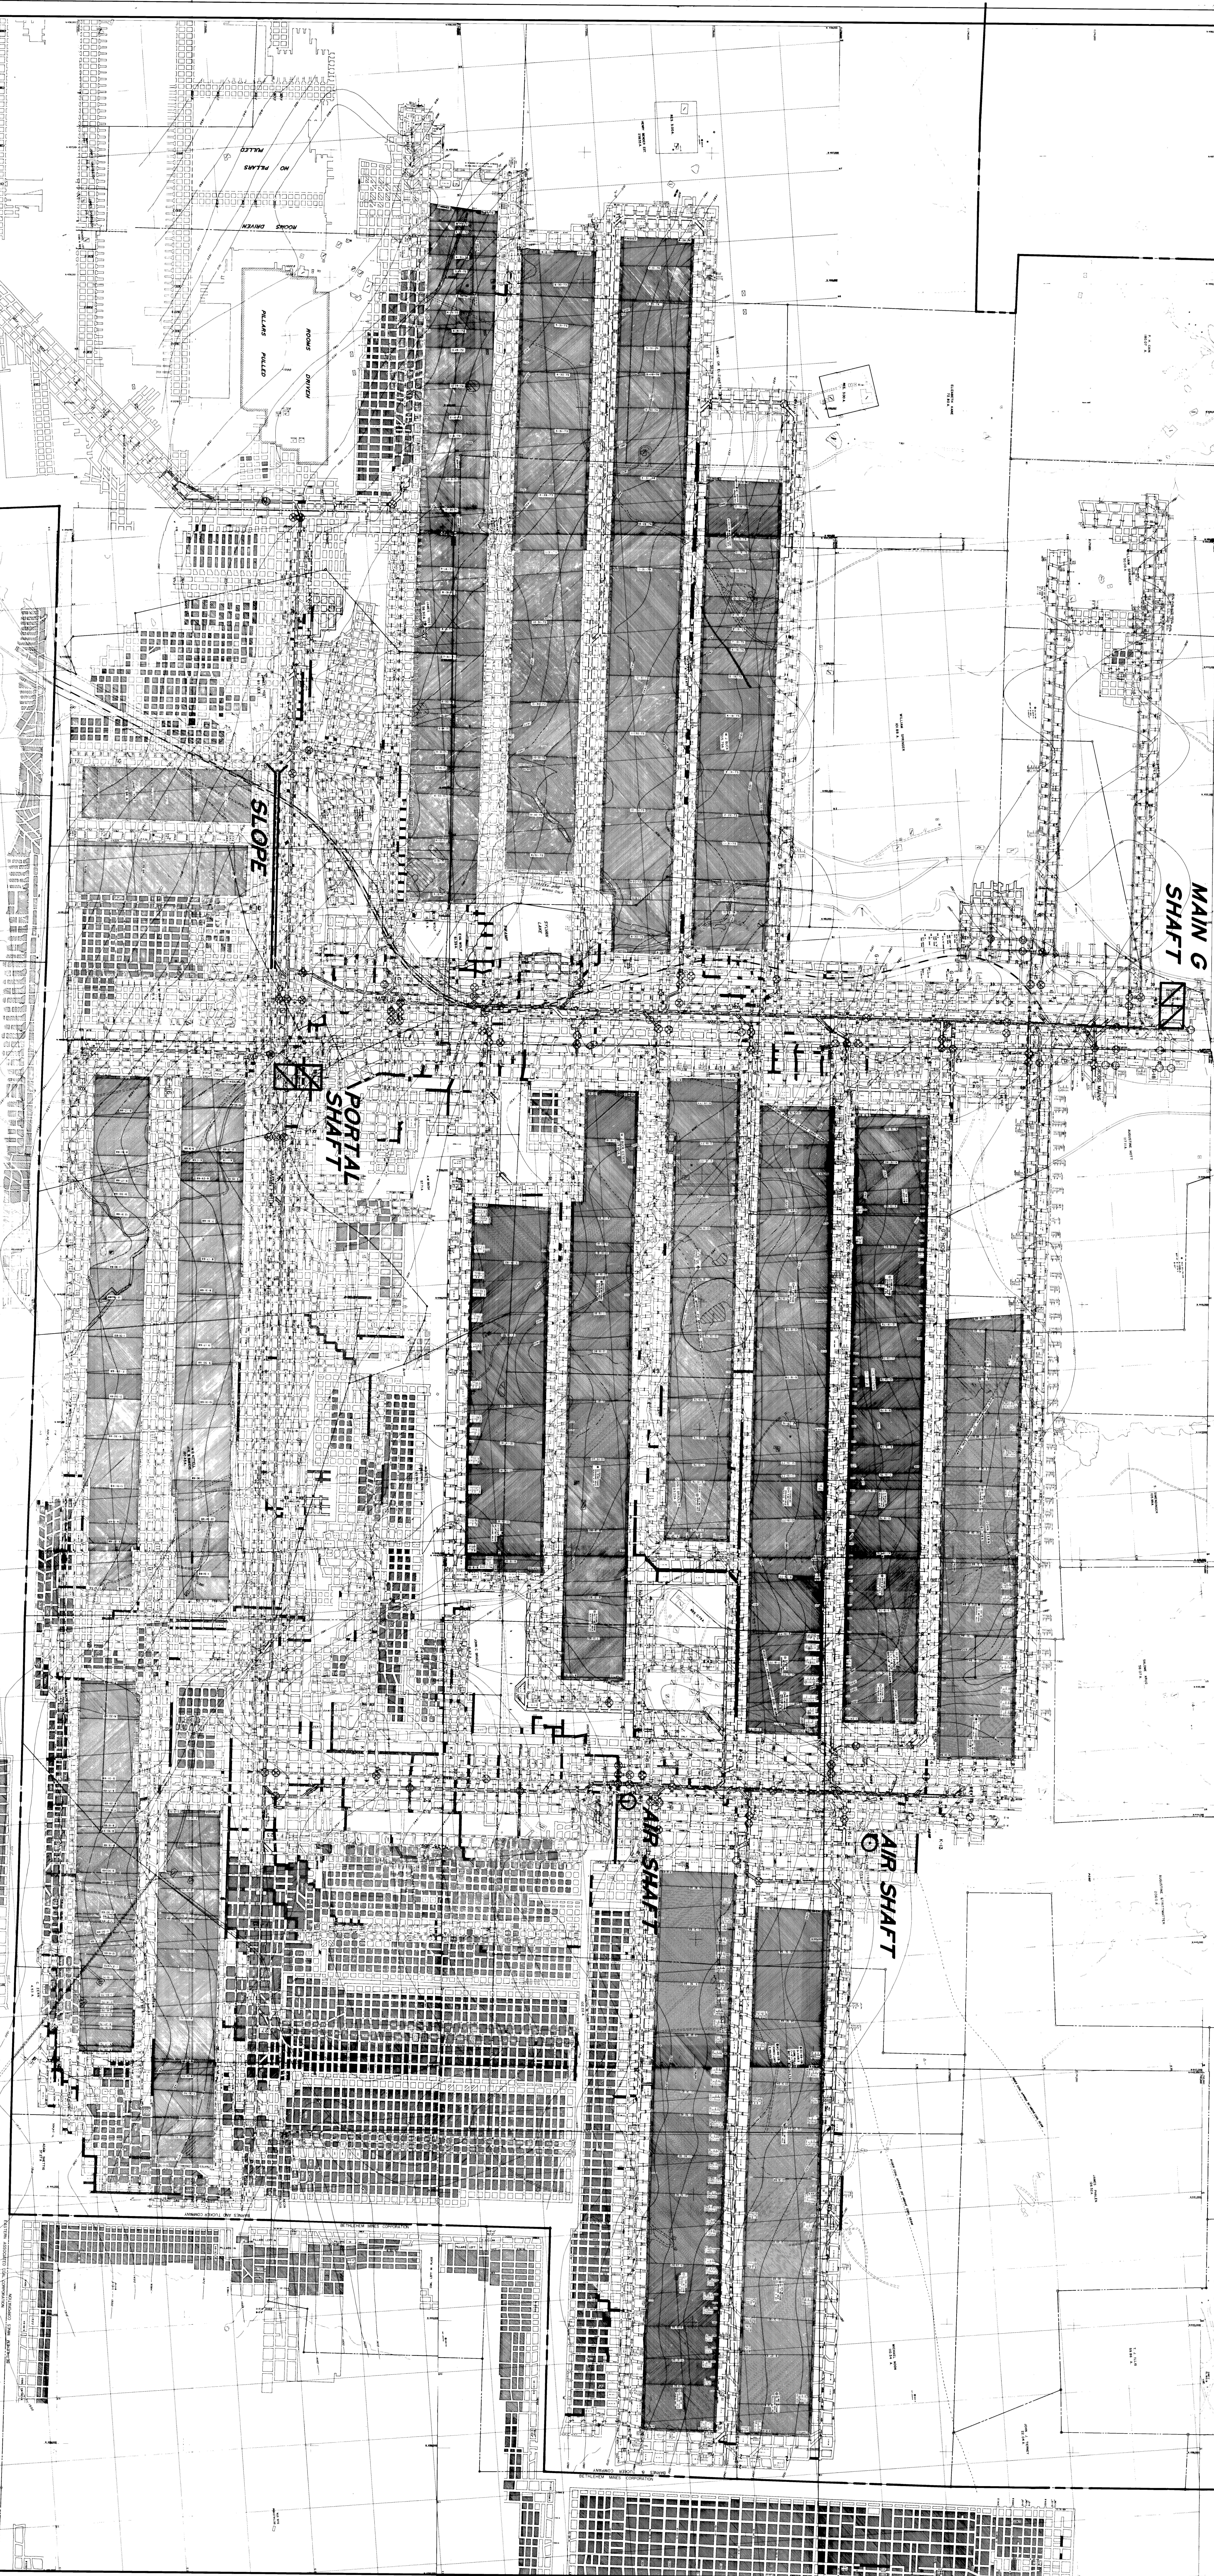

USBM 36 00836
LANCASHIRE NO. 20
SCALE 1"=400'
POSTED TO 12-31-8

1-29-86

FINAL MAPPING

