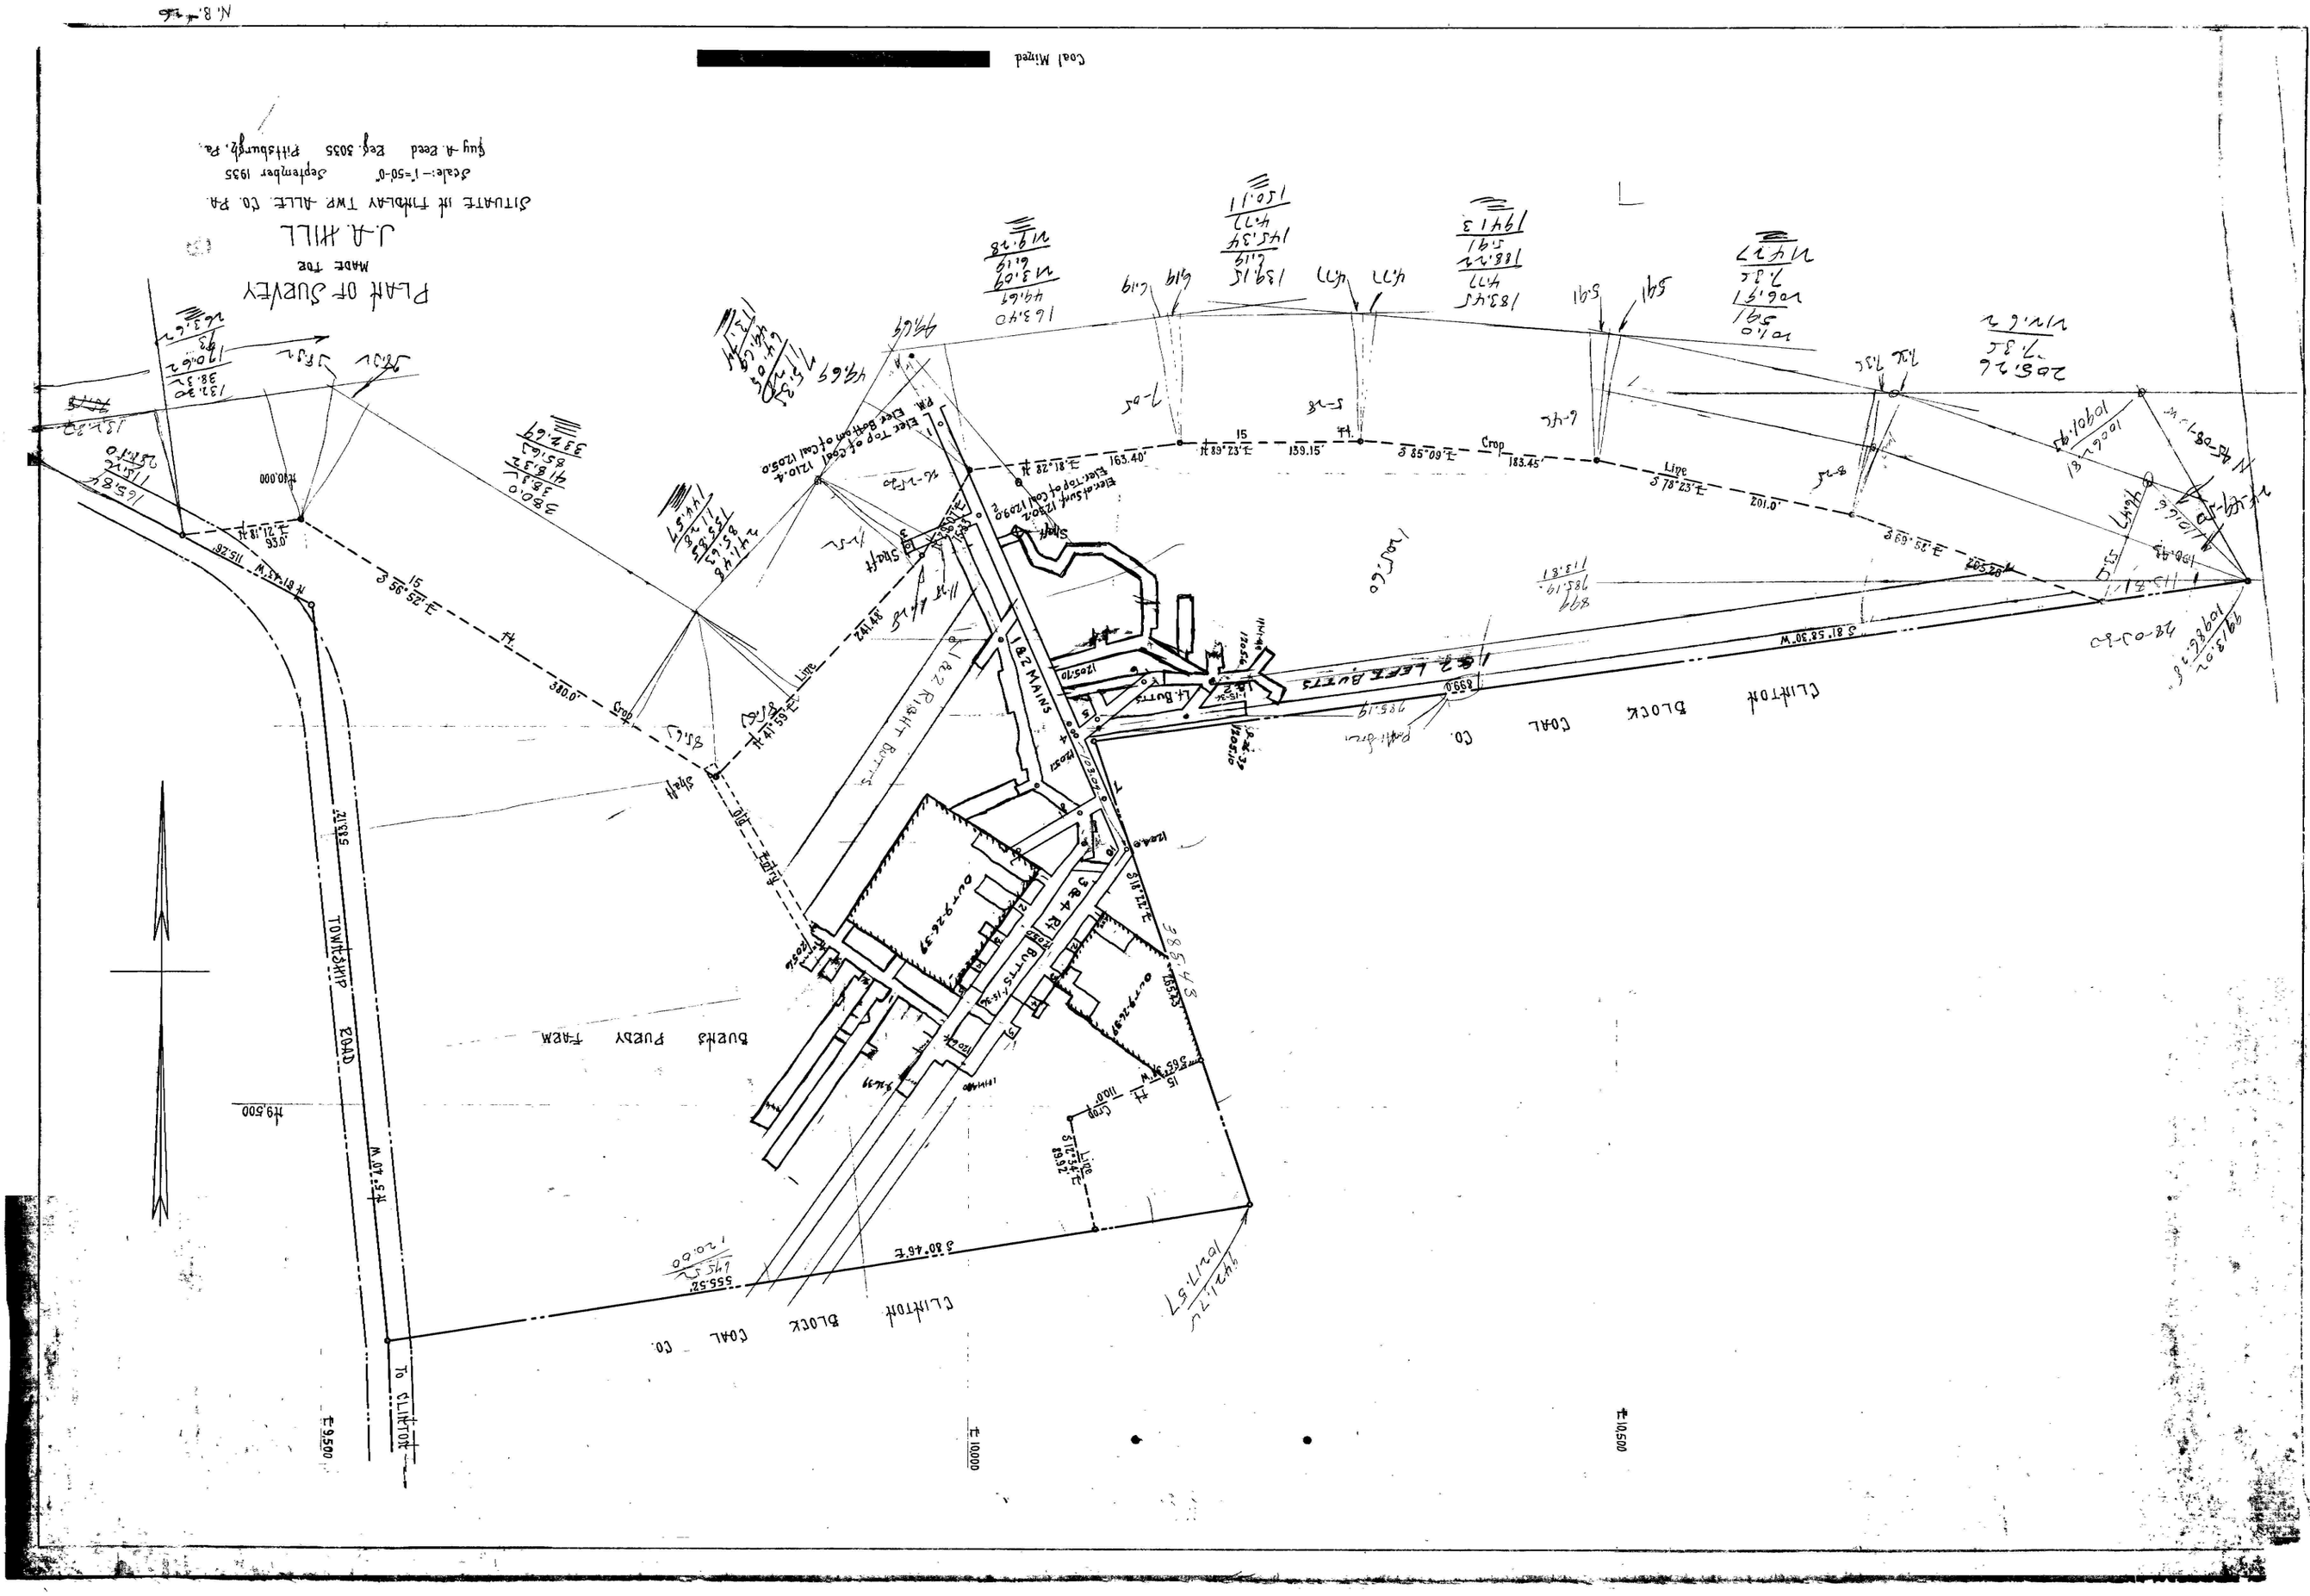
PLAN OF SURVEY
MADE FOR
J.A. HILL
Scale:- 1"=50'-0"
September 1935
Guy A. Reed Reg. 3035 Pittsburgh, Pa.
Coal Mined
CLINTON BLOCK COAL CO.
TOWNSHIP ROAD
STATE
To CLINTON
BURNS PUBLY FARM
1&2 MAINS
1&2 LEFT BUTTS
1&2 RIGHT BUTTS
3&4 RT BUTTS
Shaft
Elev. Top of Coal 1210.4
Elev. Bottom of Coal 1205.0
Elev. at surf. 1290.2
Elev. Top of Coal 1209.2
Crop
Line
S 80°46'E
S 81°52'30"W
N 85°40'W
N 81°42'W
N 46°08'30"W
S 25°35'E
S 55°13'W
S 25°35'E
S 23°39'E
S 60°58'E
S 52°28'E
