
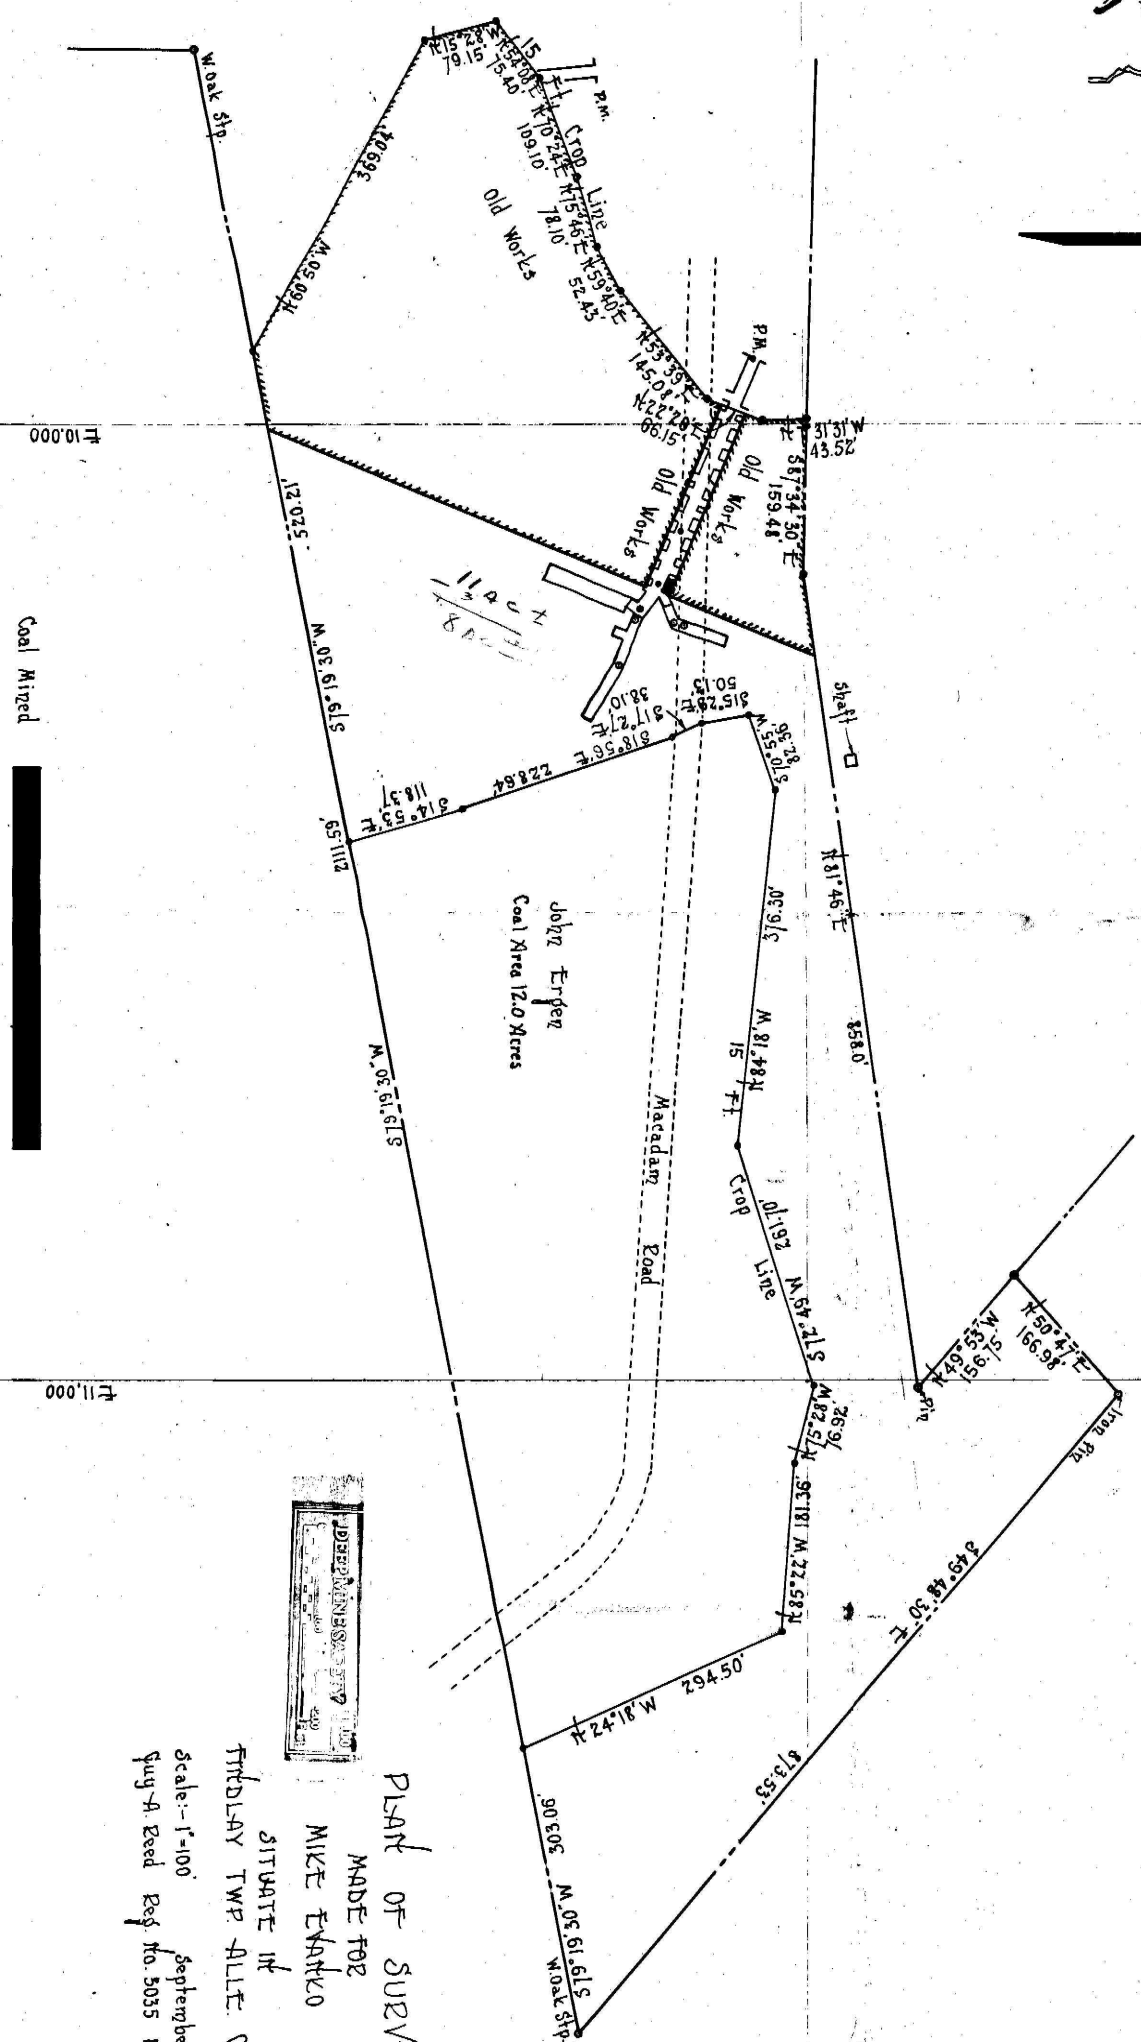


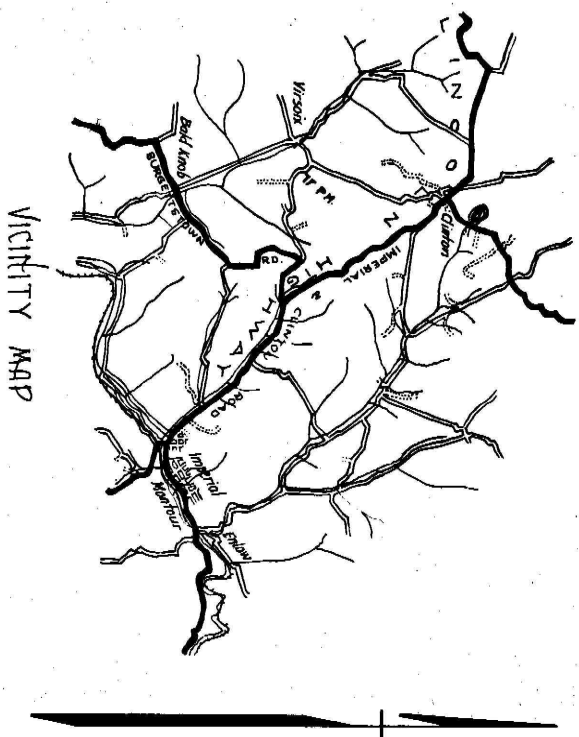

PLAN OF SURVEY
MADE FOR
SITUATE IN
Scale: 1"=100'
September 1934

MIKE FRANKO

SITUATE IN

FINDLAY TWP. ALLE. CO. PA

Scale:- 1"=100'
September 1934.

Guy A. Reed Reg. No. 5035 Pgh., Pa.