


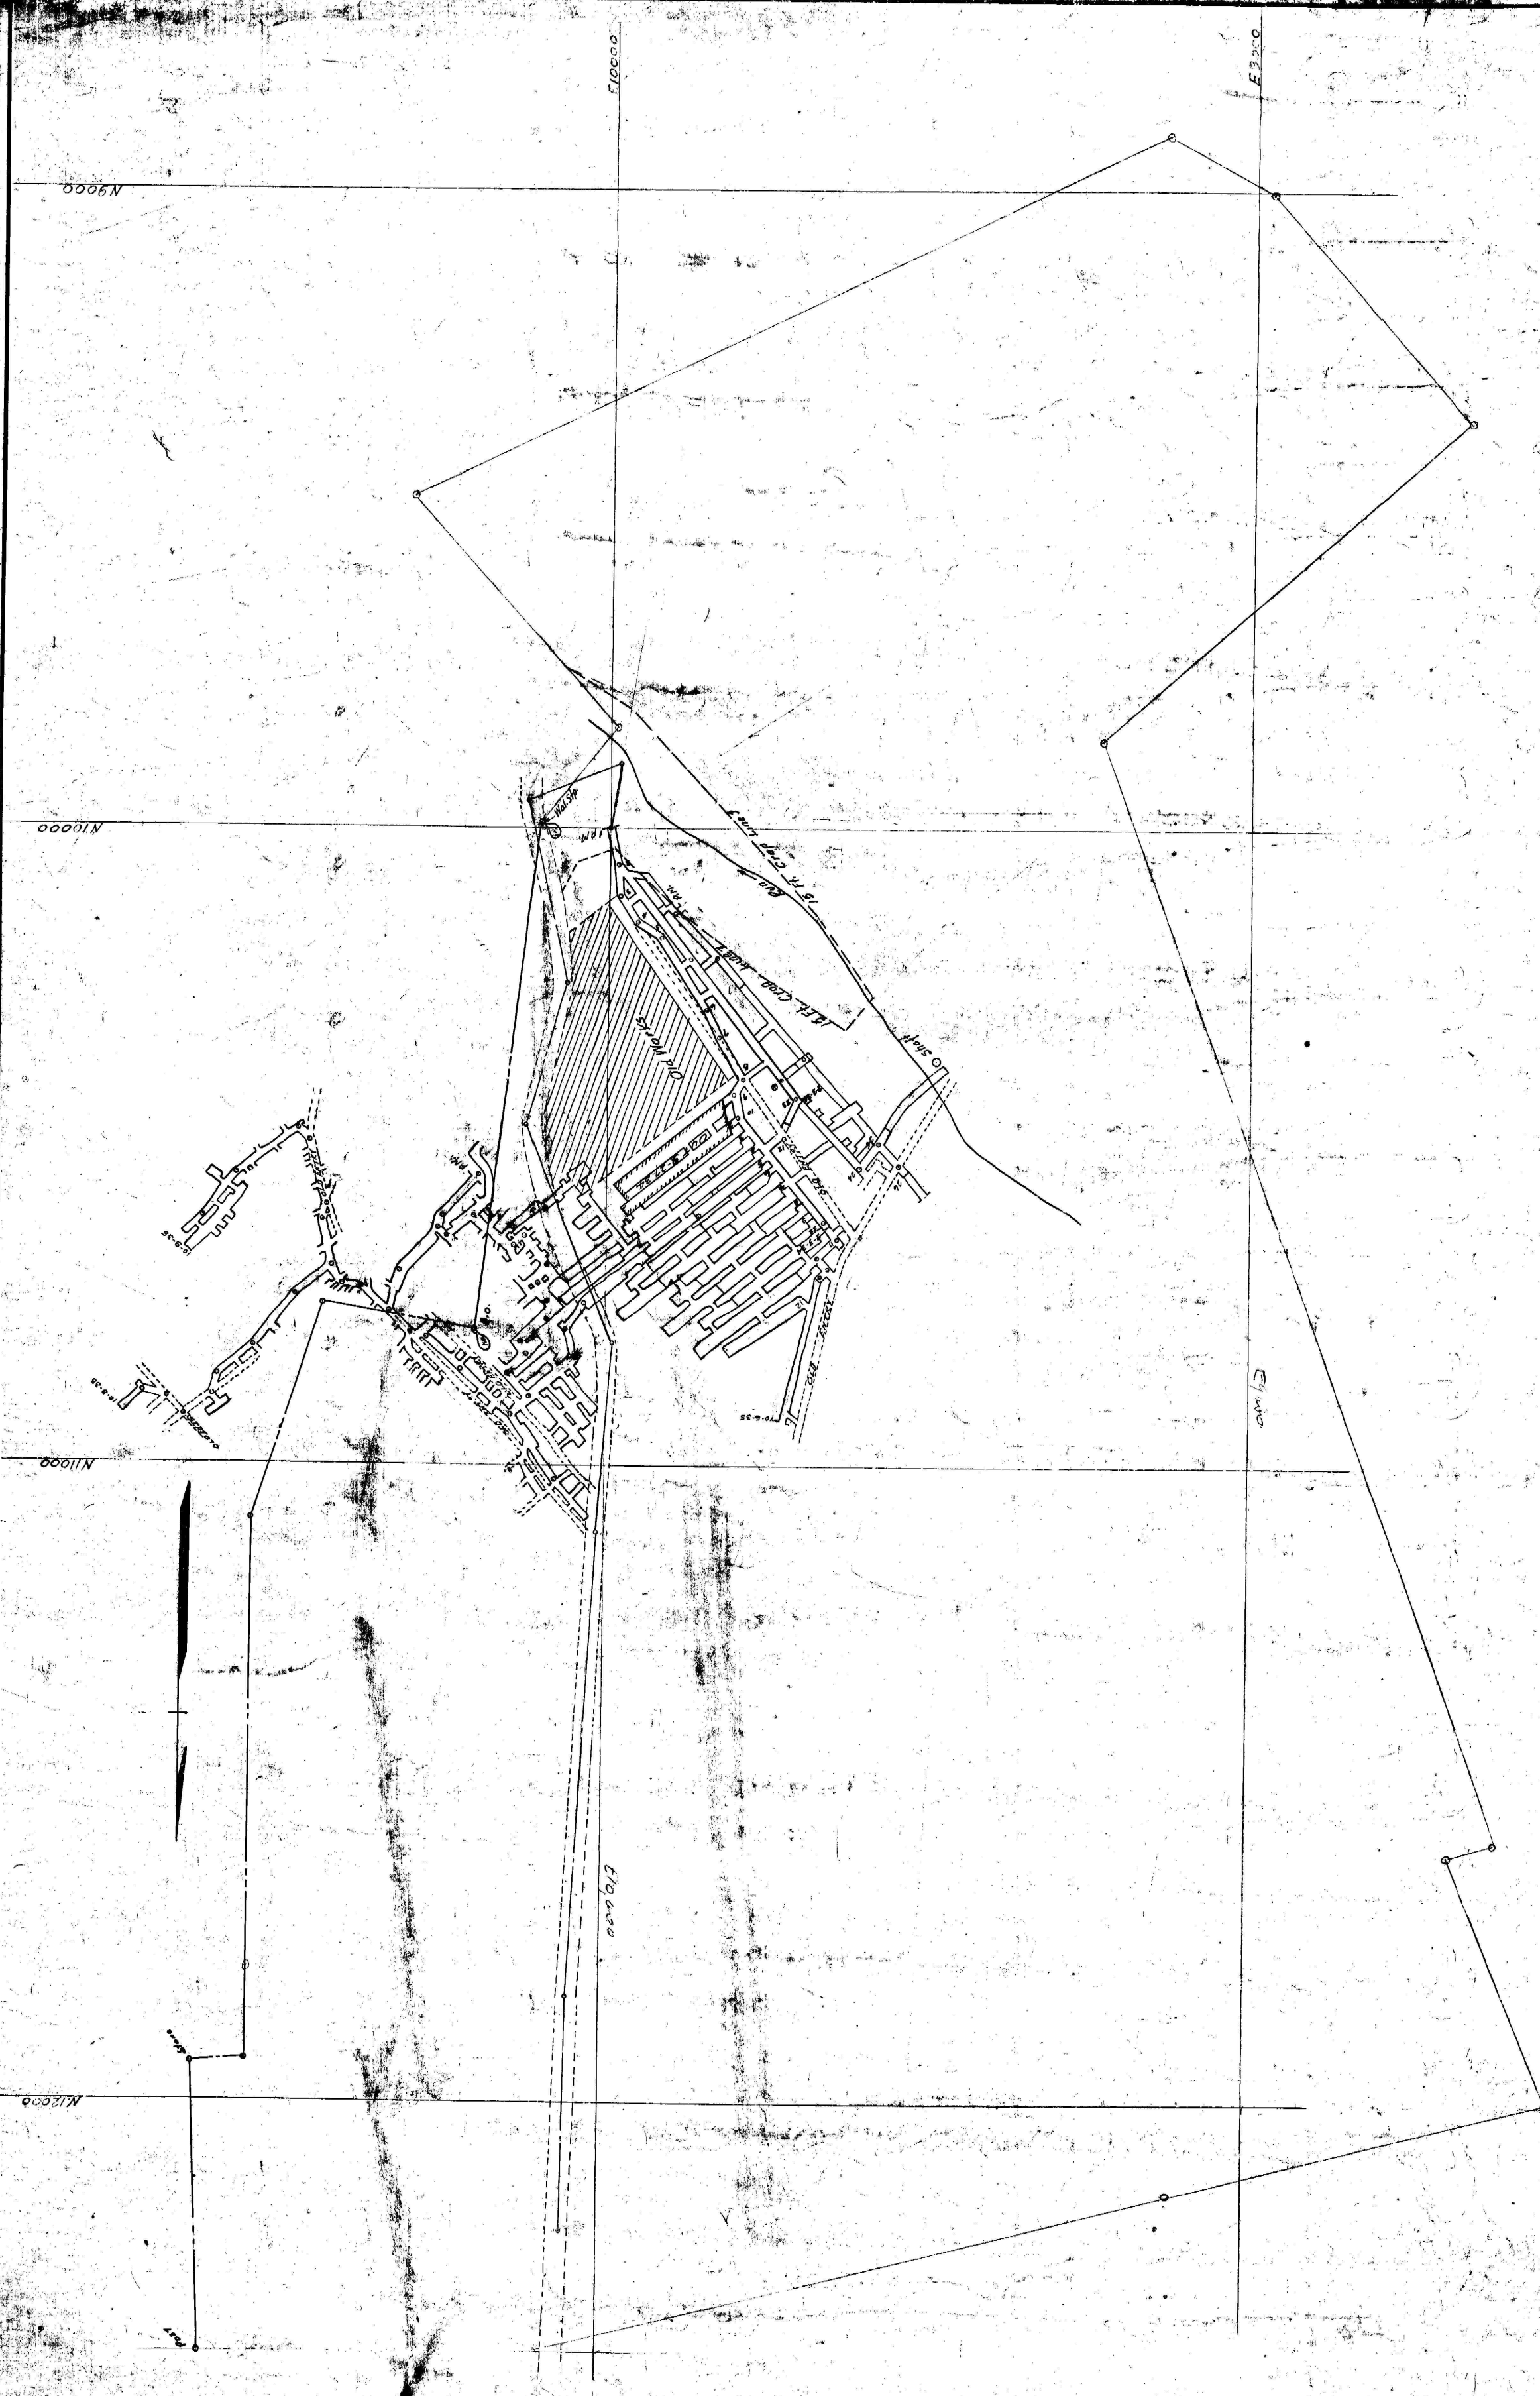

NESBIT MINE
PLAN OF SURVEY
MADE FOR
BLACK DIAMOND COAL CO.
SOUTH FAYETTE TWP. ALLE. CO. PA.
SCALE 1"=100' DET. 1934 E. A. REED, REG. NO. 3035
PITTSBURGH, PA.

