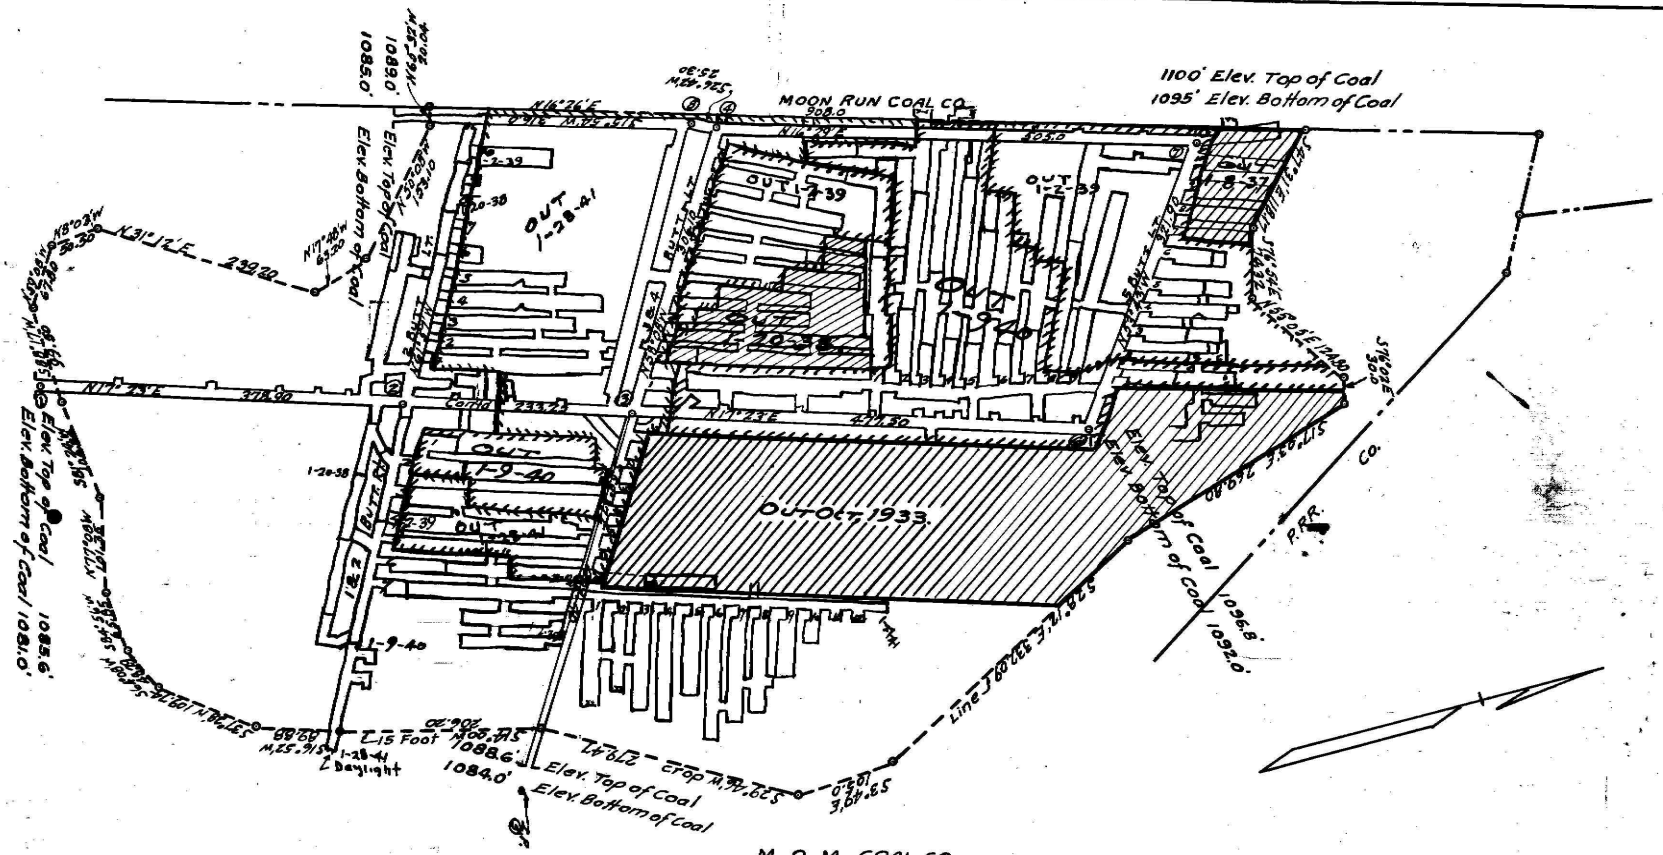

Coal Mined

No. 84

N.B. 475