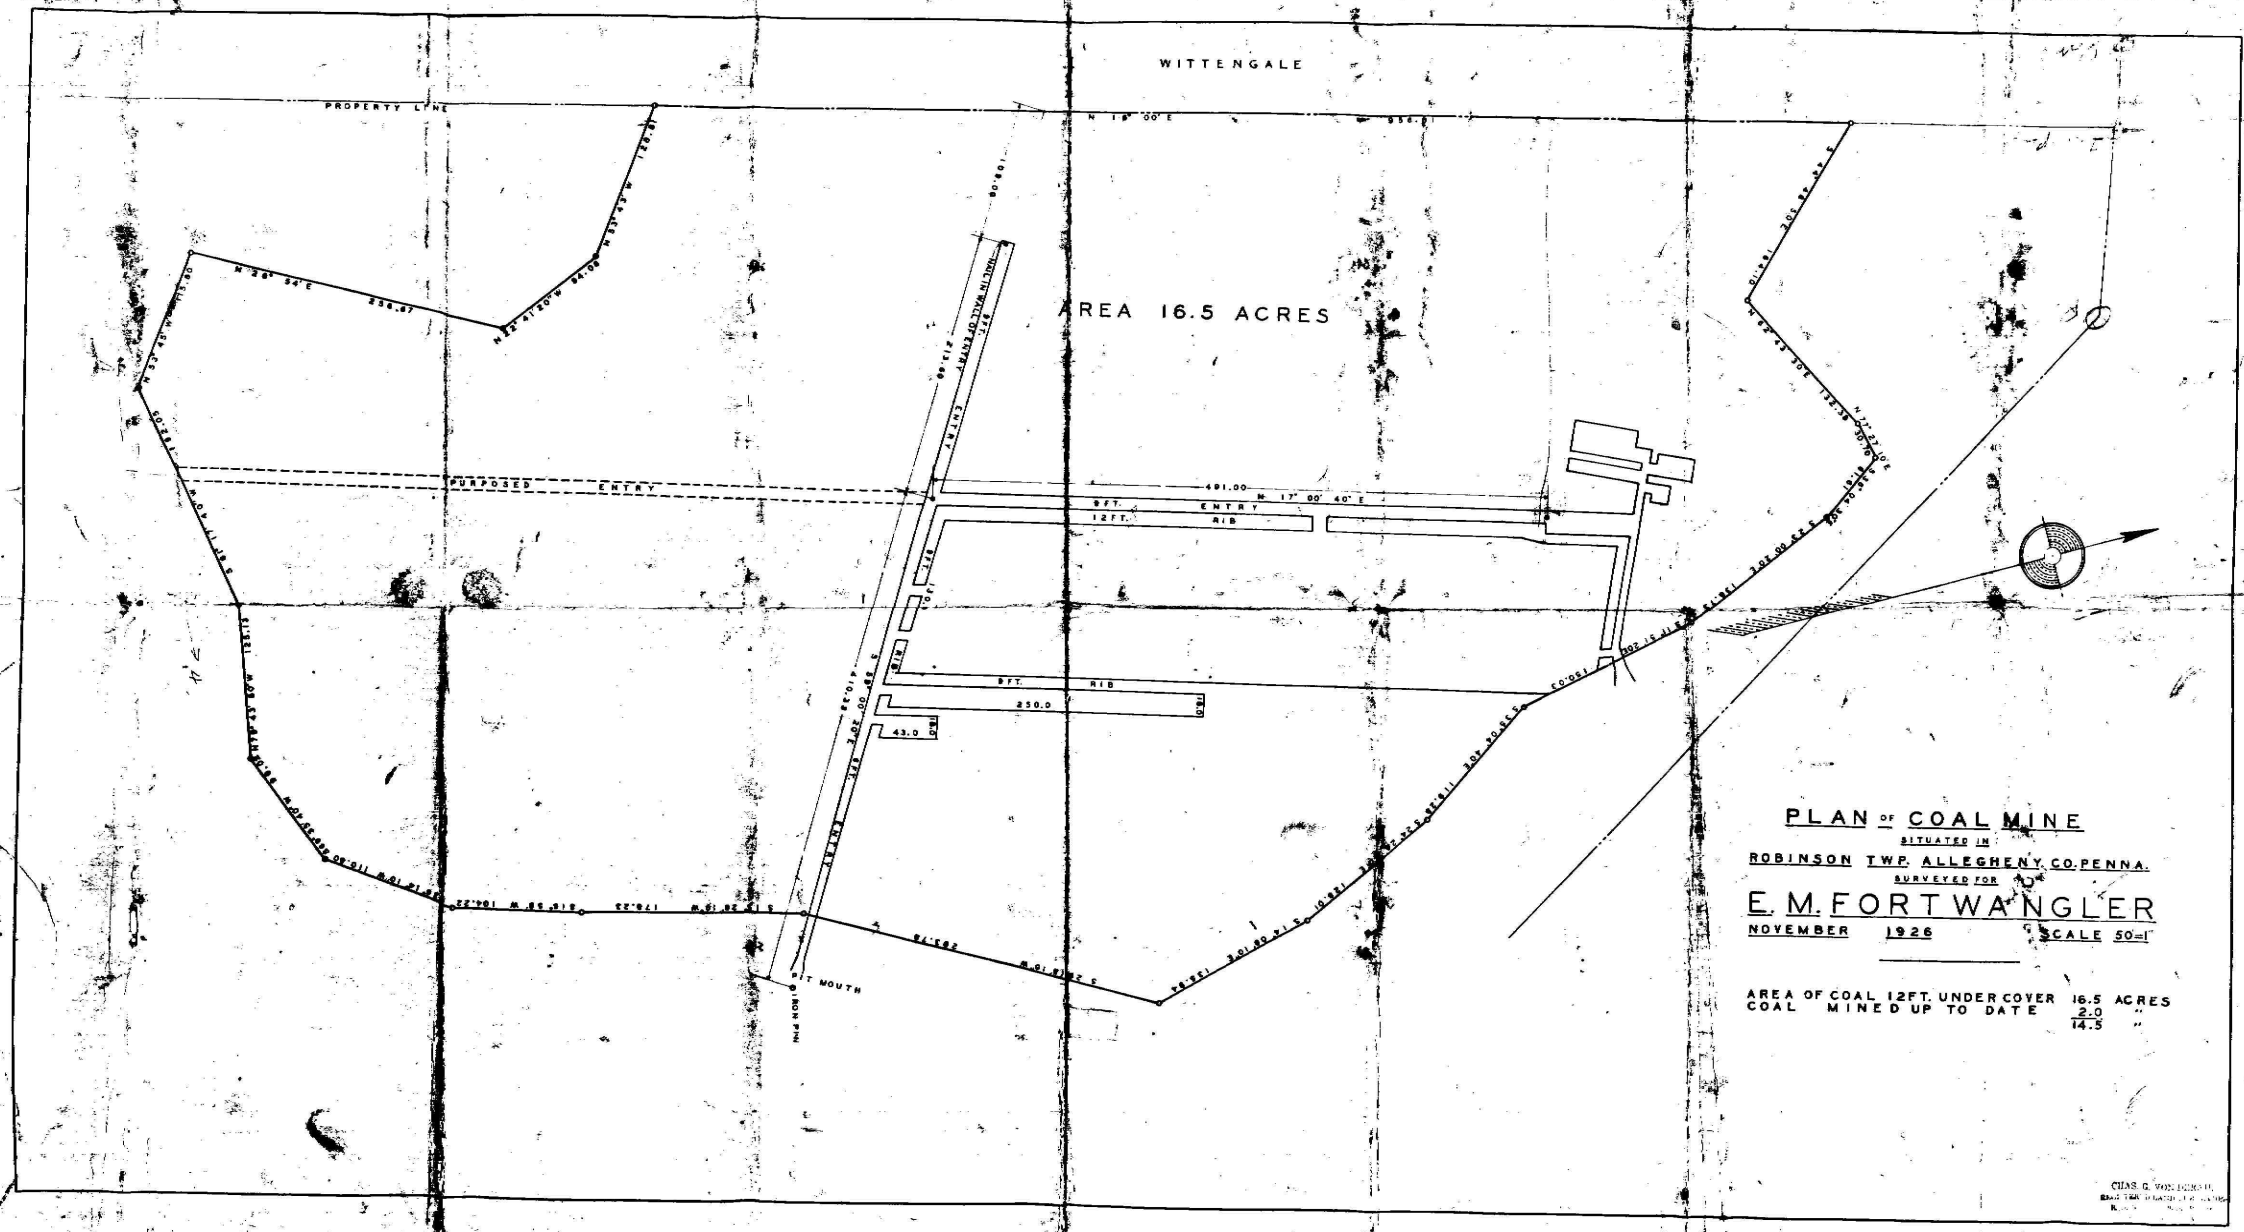
WITTENGALE
PROPERTY LINE
N 18° 00' E
AREA 16.5 ACRES
PURPOSED ENTRY
491.00
N 17° 00' 40" E
9 FT.
12 FT.
ENTRY
RIB
9 FT. RIB
250.0
43.0
PIT MOUTH
PLAN OF COAL MINE
SITUATED IN
ROBINSON TWP. ALLEGHENY CO. PENNA.
SURVEYED FOR
E. M. FORTWANGLER
NOVEMBER 1926
SCALE 50=1'
AREA OF COAL 12 FT. UNDER COVER 16.5 ACRES
COAL MINED UP TO DATE 2.0 "
14.5 "