


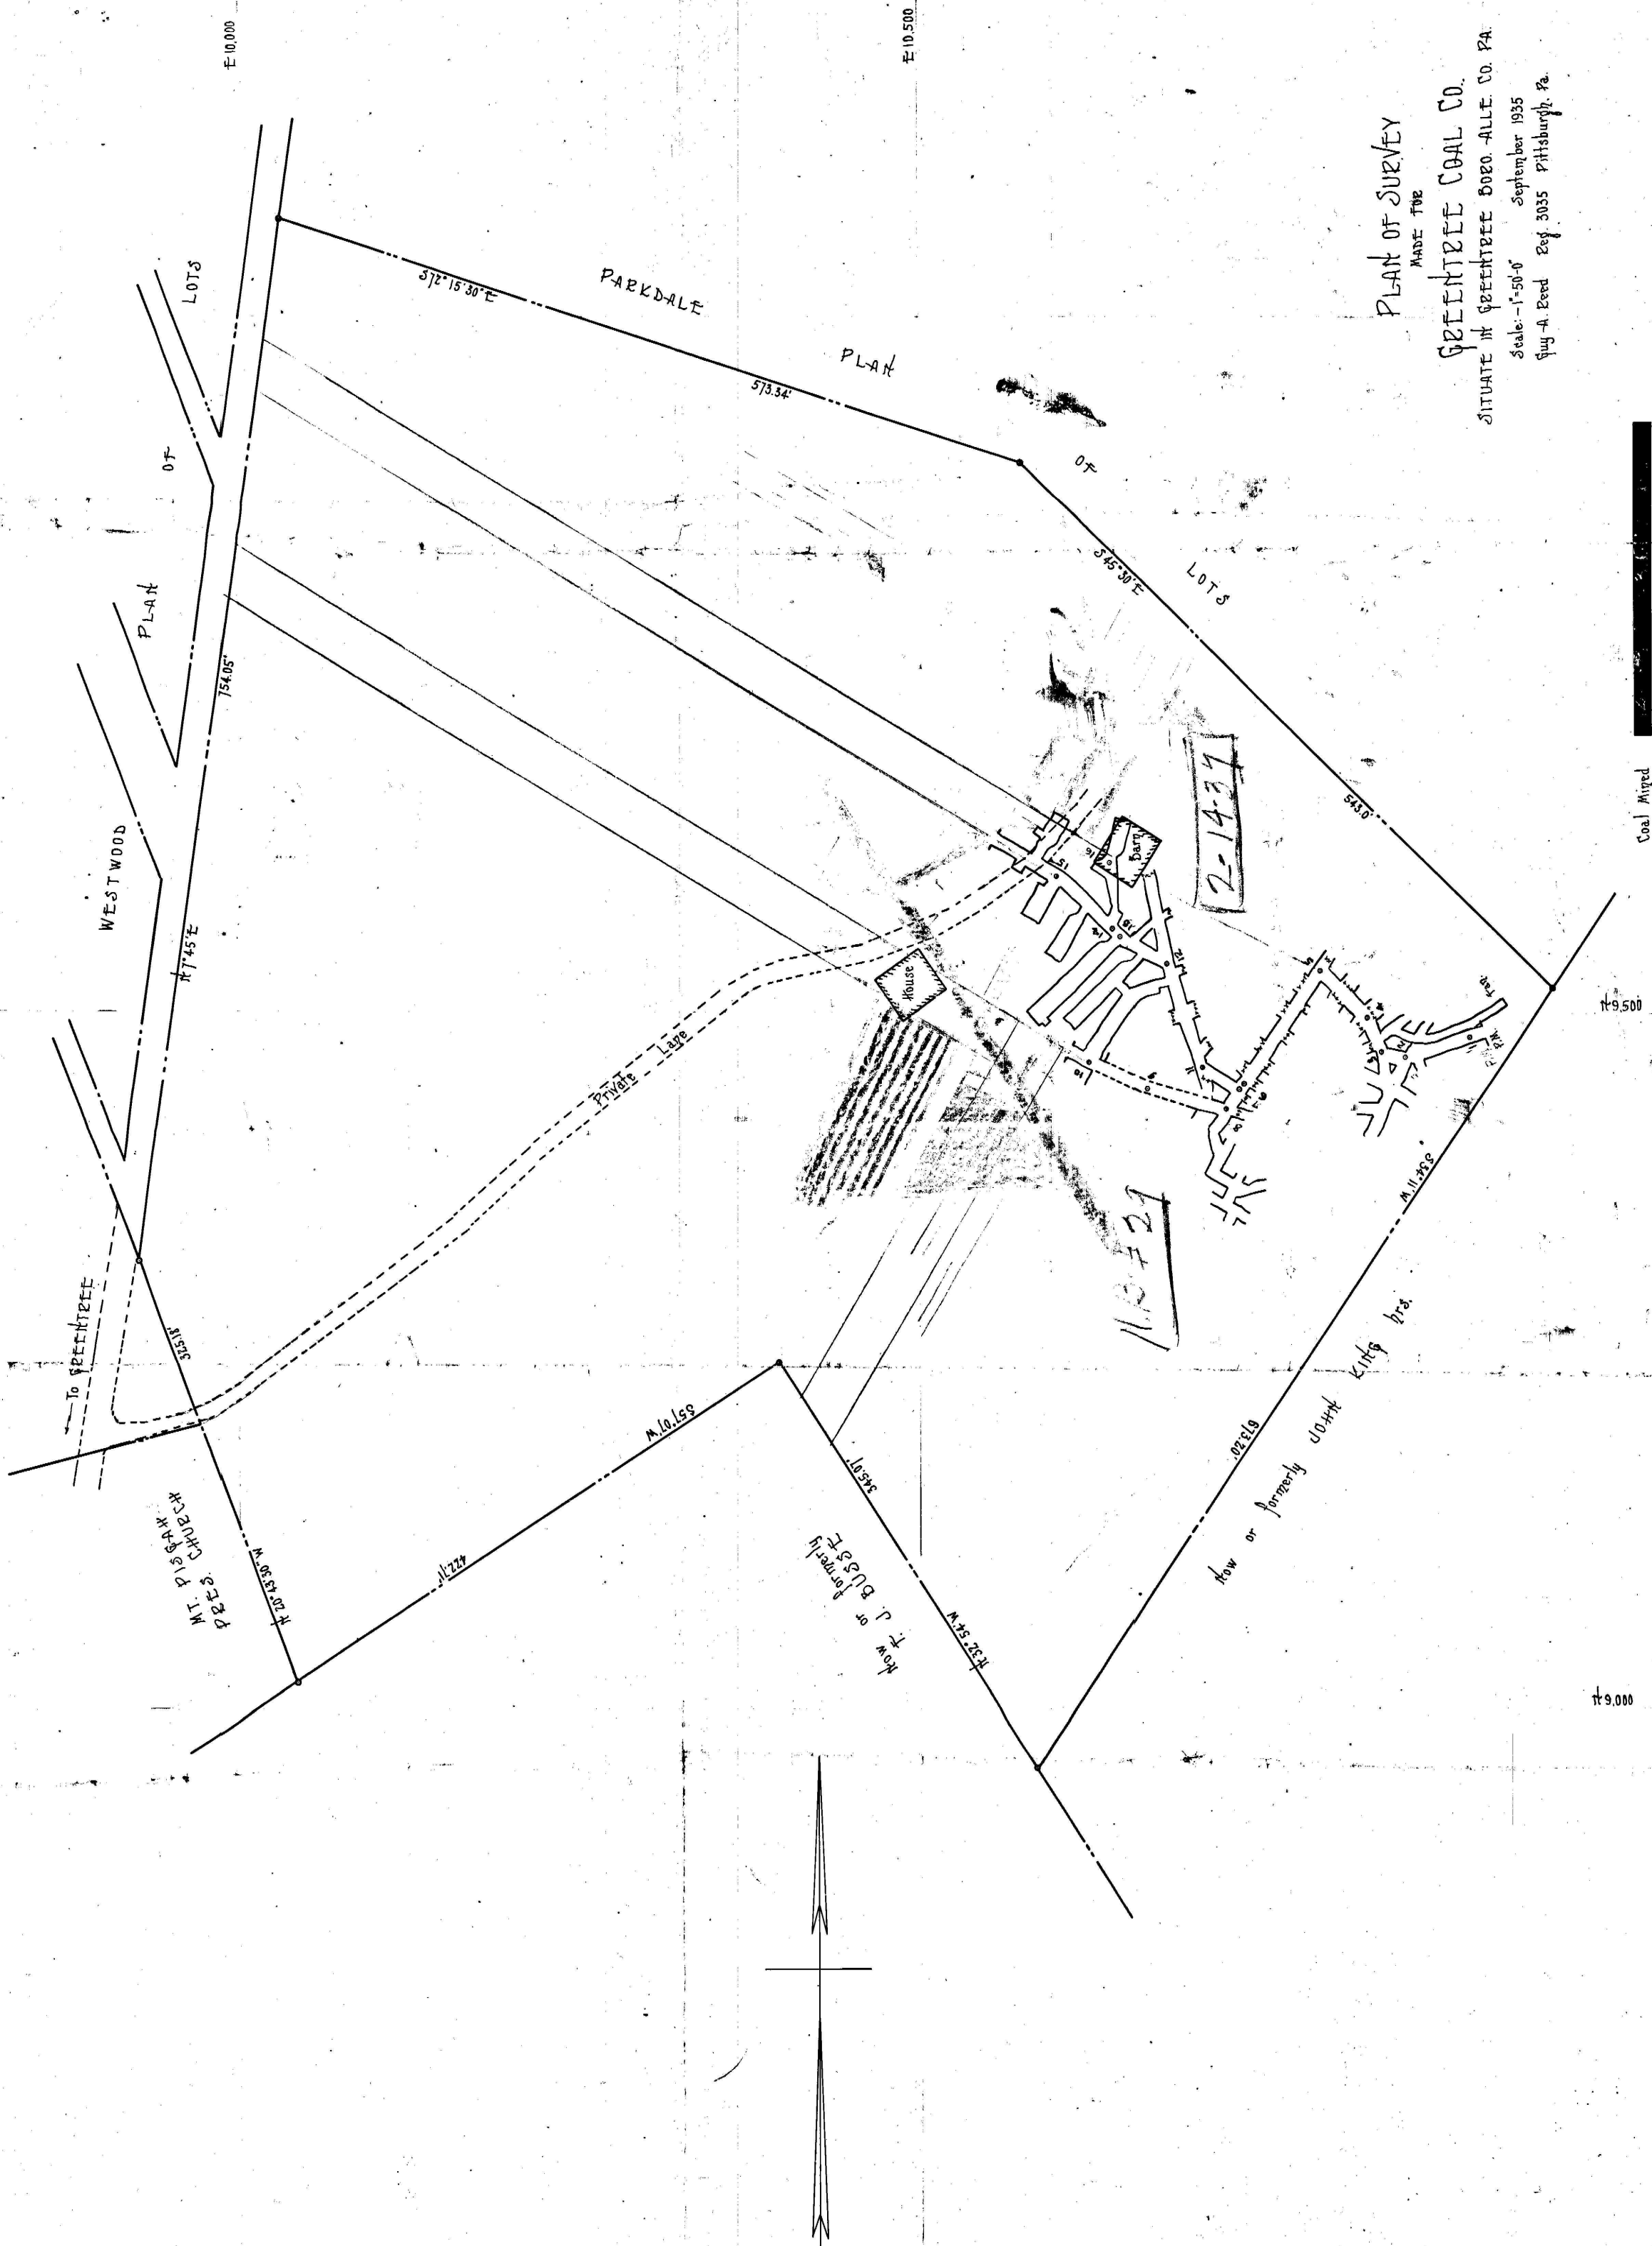

PLAN OF SURVEY
MADE FOR
GREENTREE COAL CO.
SITUATE IN GREENTREE BORO. ALLE. CO. PA.
Guy A. Reed Reg. 3035 Pittsburgh, Pa.