

Handwritten:
 15/11/35
 J. C. W.

H. C. WOLSTONCROFT



PITTSBURGH COAL CO.

M. WALKER, a.l.

I. Mc F. RITGWALT, et al.

*Coal mined
 to June 21-1937*

X Abandoned Well

 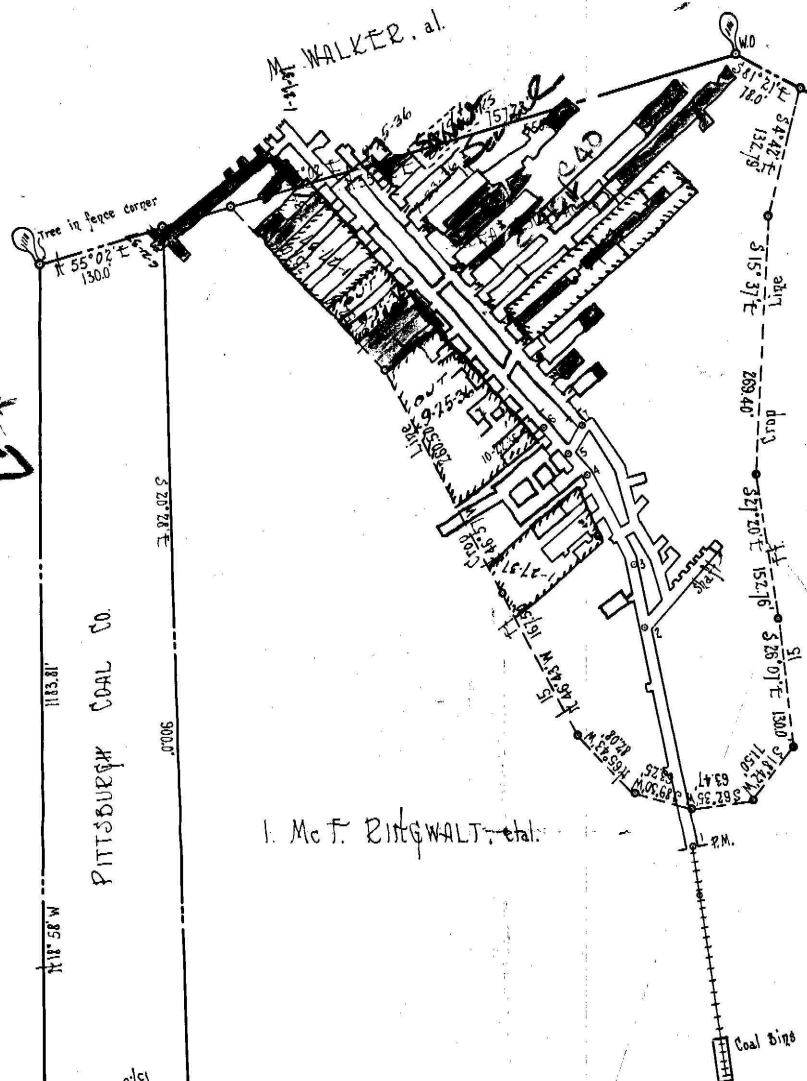

PLAN OF SURVEY
 MADE FOR
 AUSTRIAN-AMERICAN COAL CO.
 SITUATE IN COLLIER TWP ALLE., CO. PA.
 Scale: 1"=100' October 1935
 Guy - A. Reed - Reg. 3035 - Pittsburgh, Pa.