


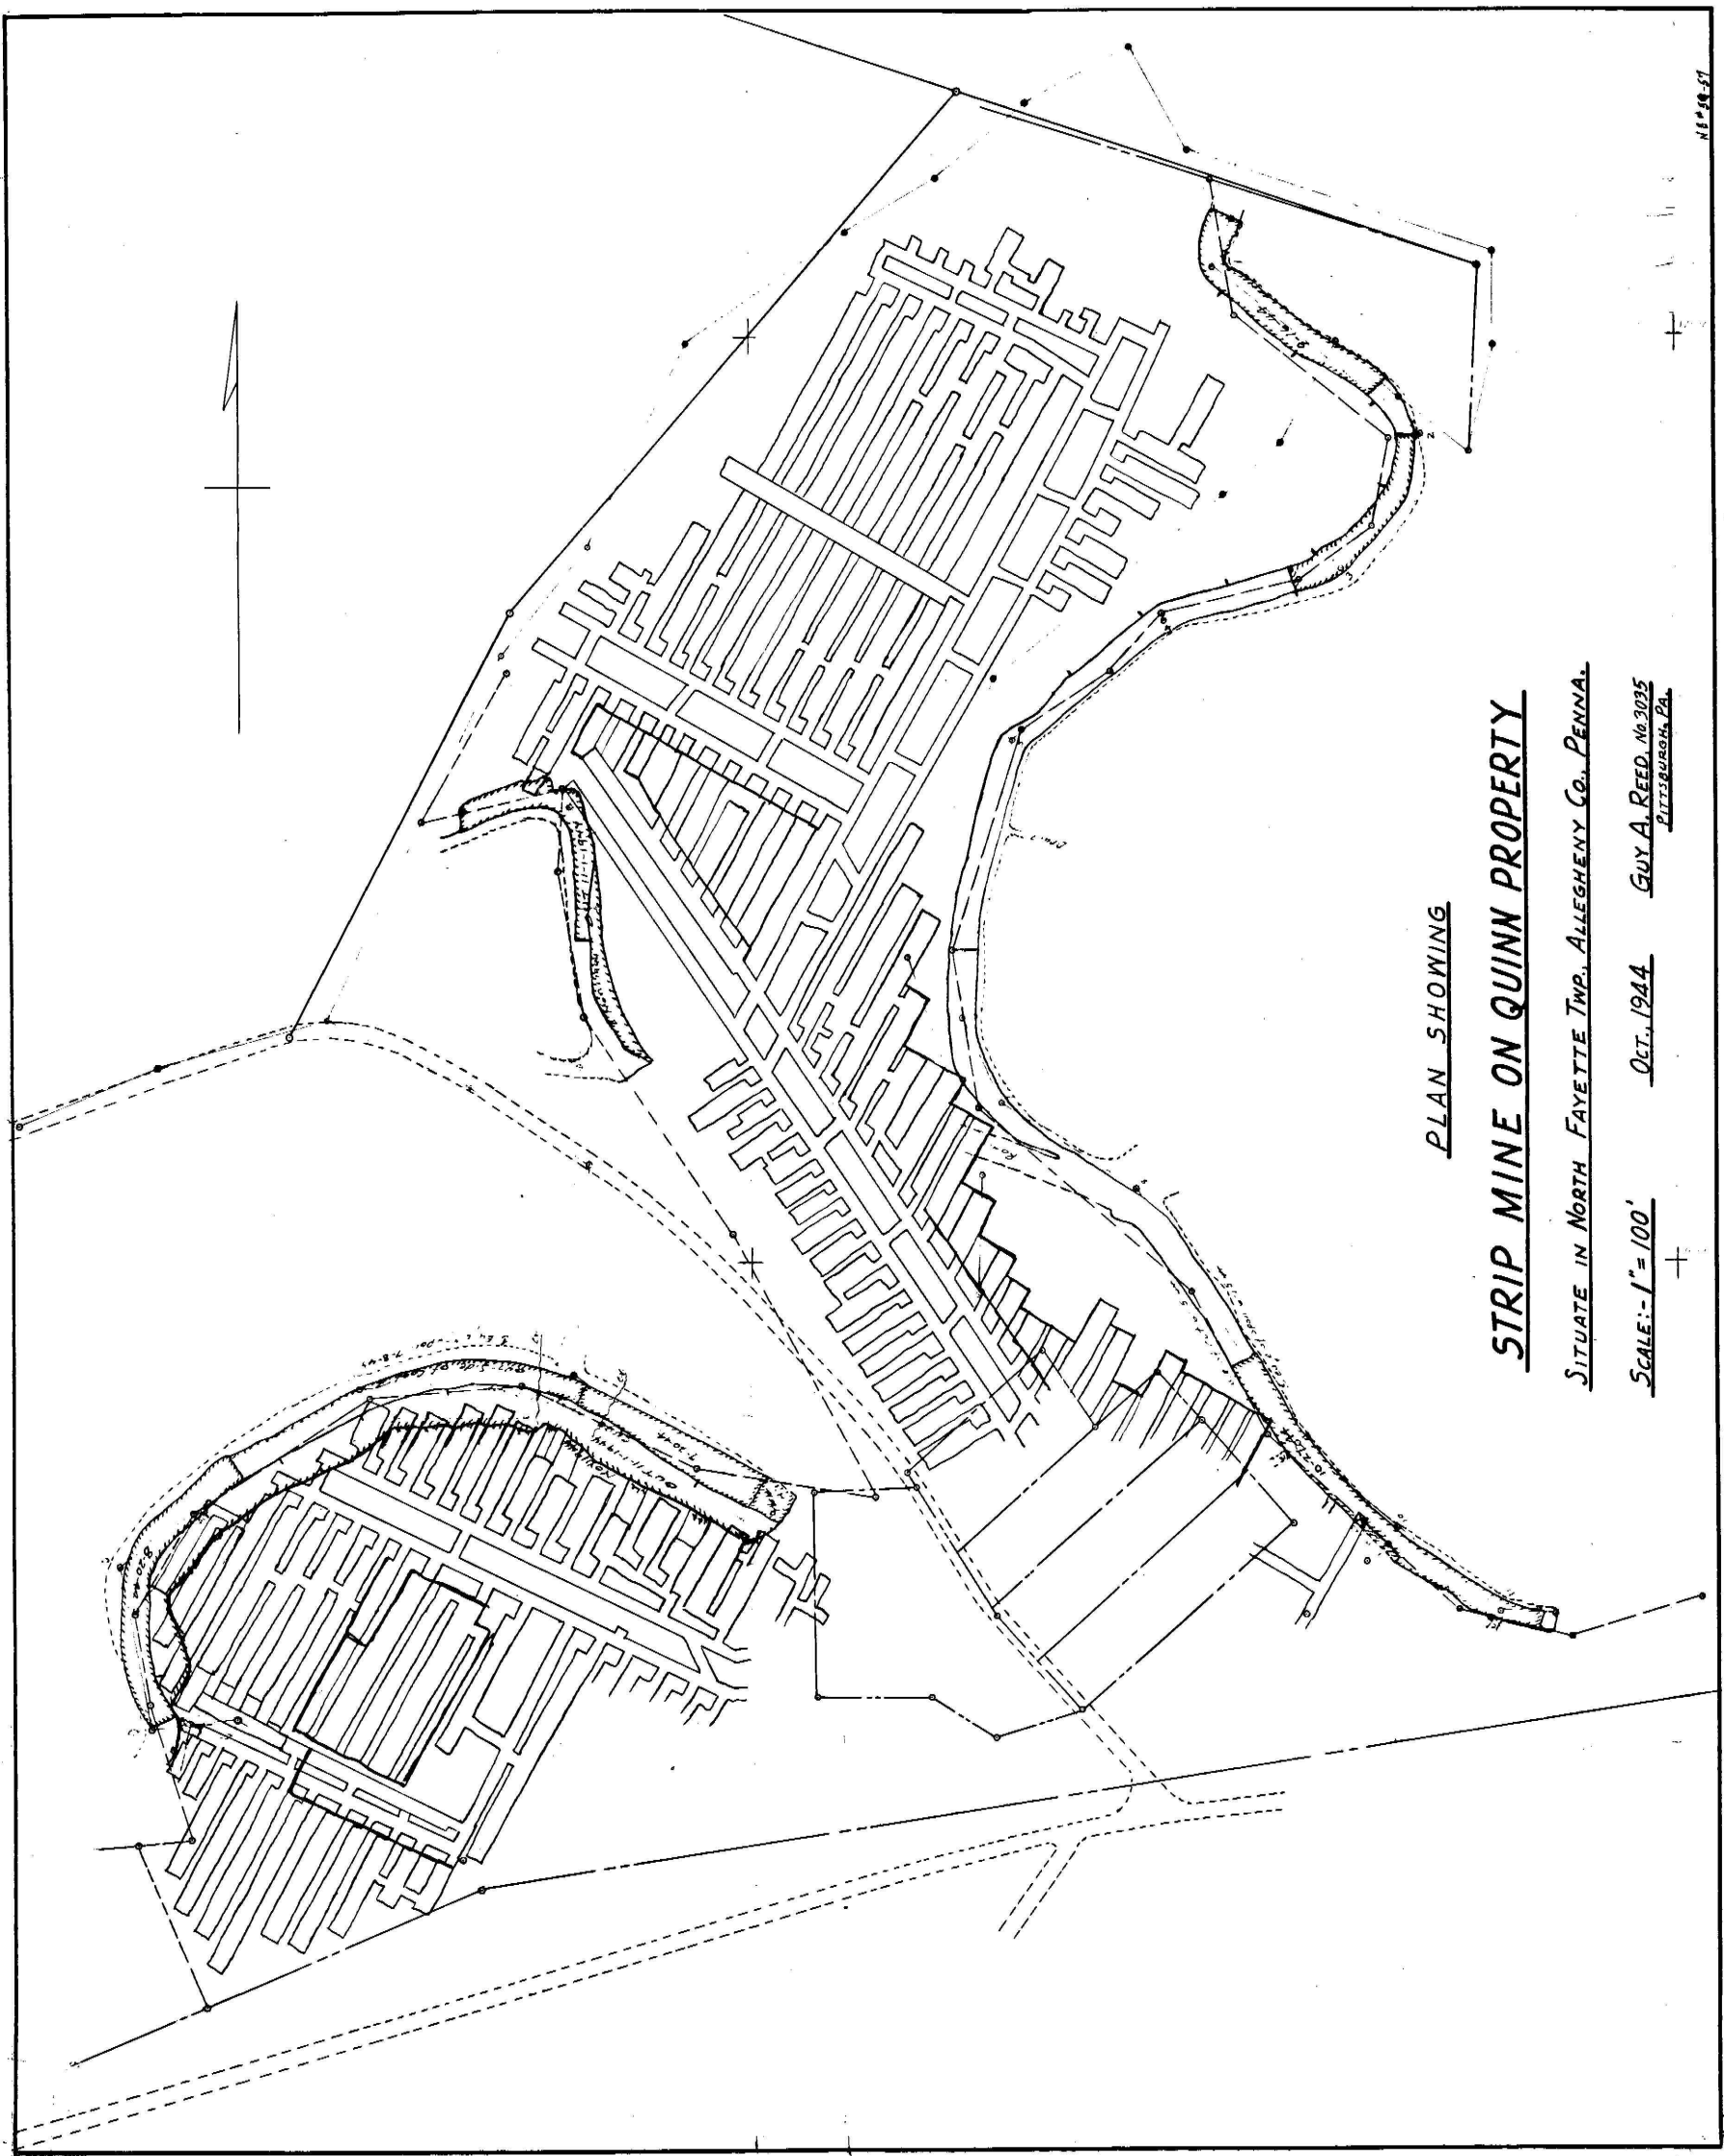

PLAN SHOWING

STRIP MINE ON QUINN PROPERTY

SITUATE IN NORTH FAYETTE TWP., ALLEGHENY CO., PENNA.

SCALE: 1" = 100'

OCT., 1944

GUY A. REED, No. 3035
PITTSBURGH, PA.

11-10-57