



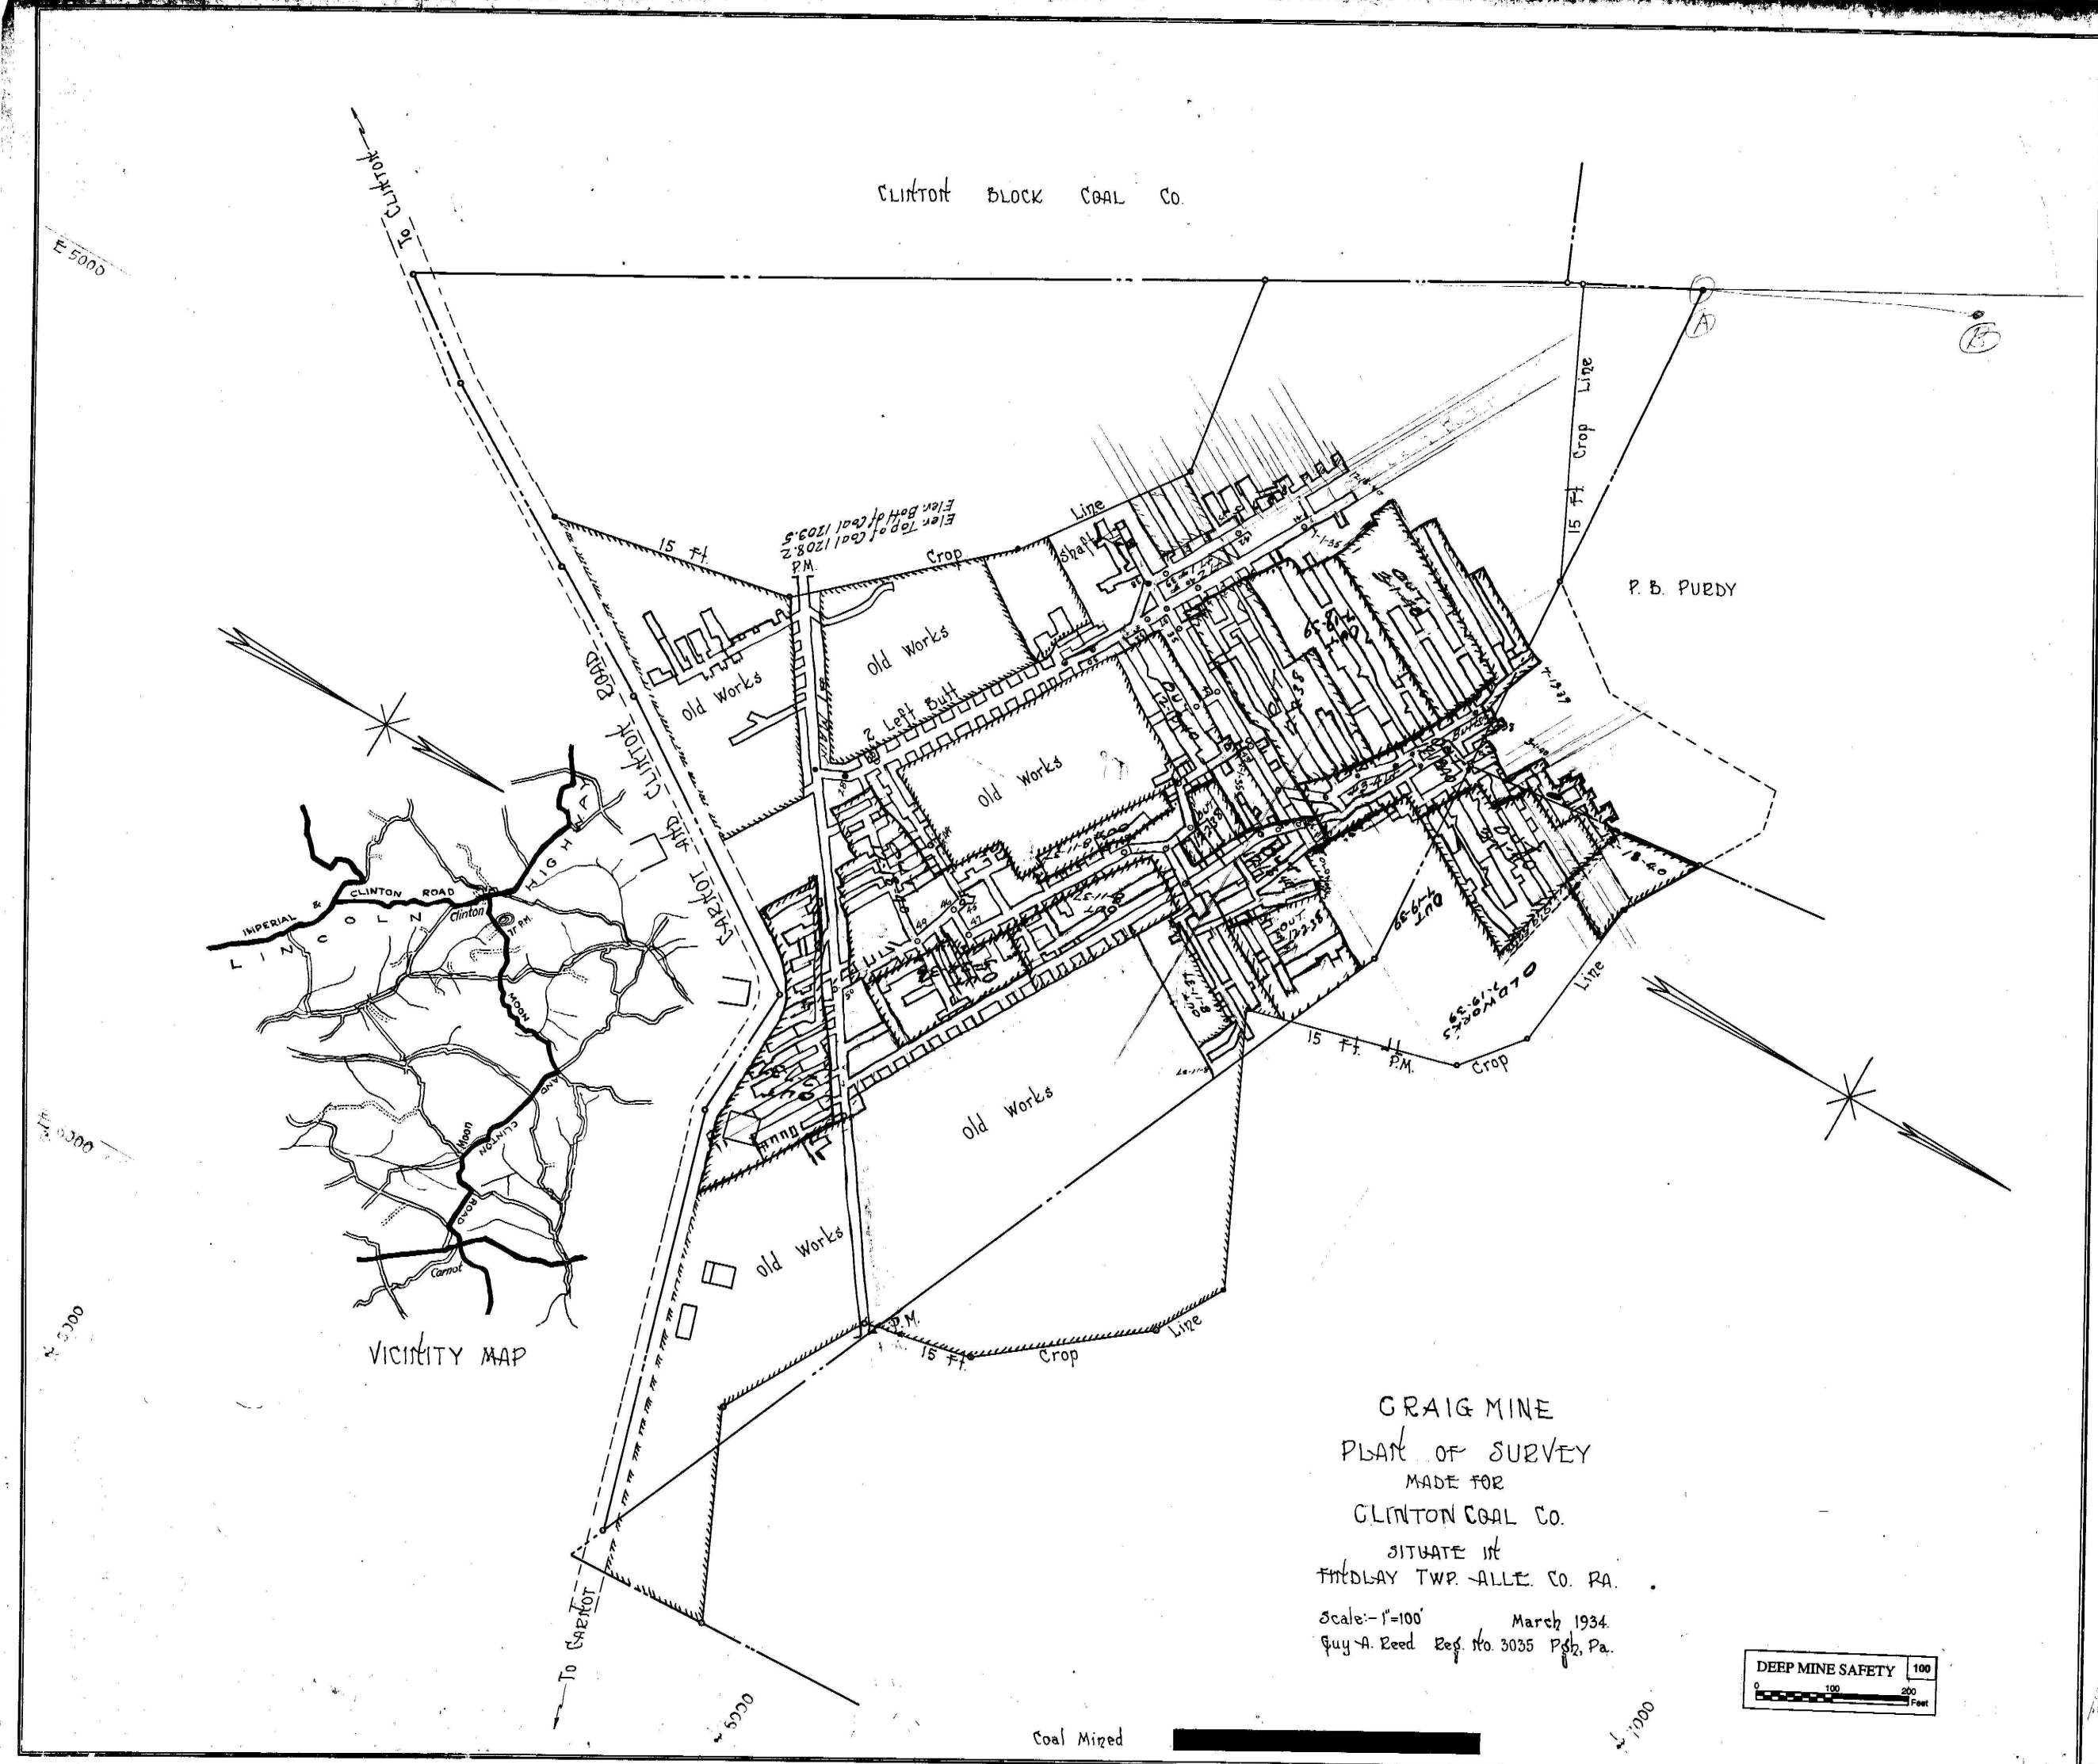


CLINTON BLOCK COAL CO.

P. B. PURDY

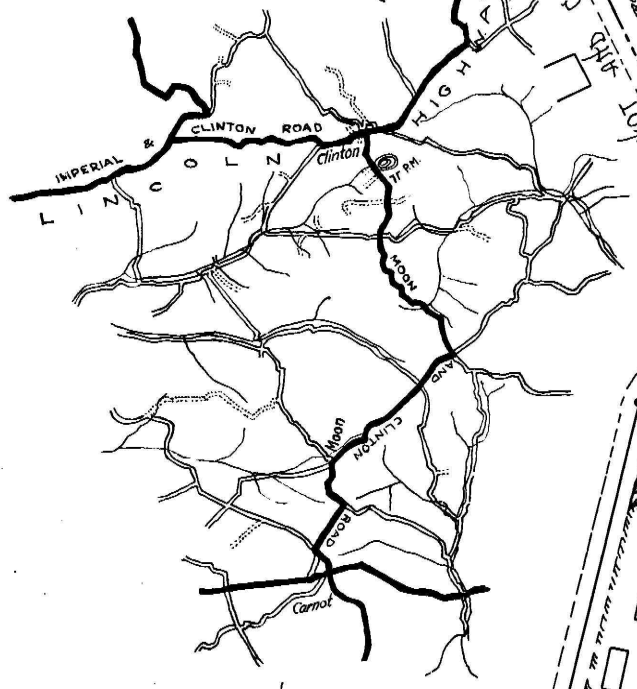

VICINITY MAP

CRAIG MINE
 PLAN OF SURVEY
 MADE FOR
 CLINTON COAL CO.
 SITUATE IN
 FREDLAY TWP. ALLE. CO. PA.
 Scale: 1"=100' March 1934
 Guy A. Reed Reg. No. 3035 Pgs. Pa.

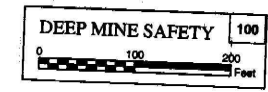

Coal Mined