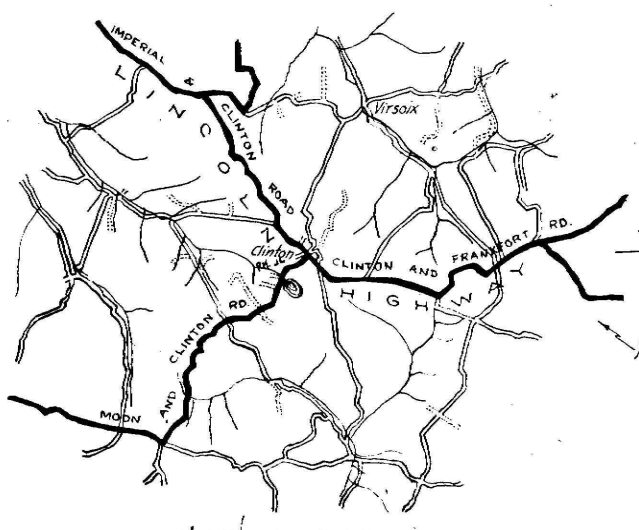

VICINITY MAP

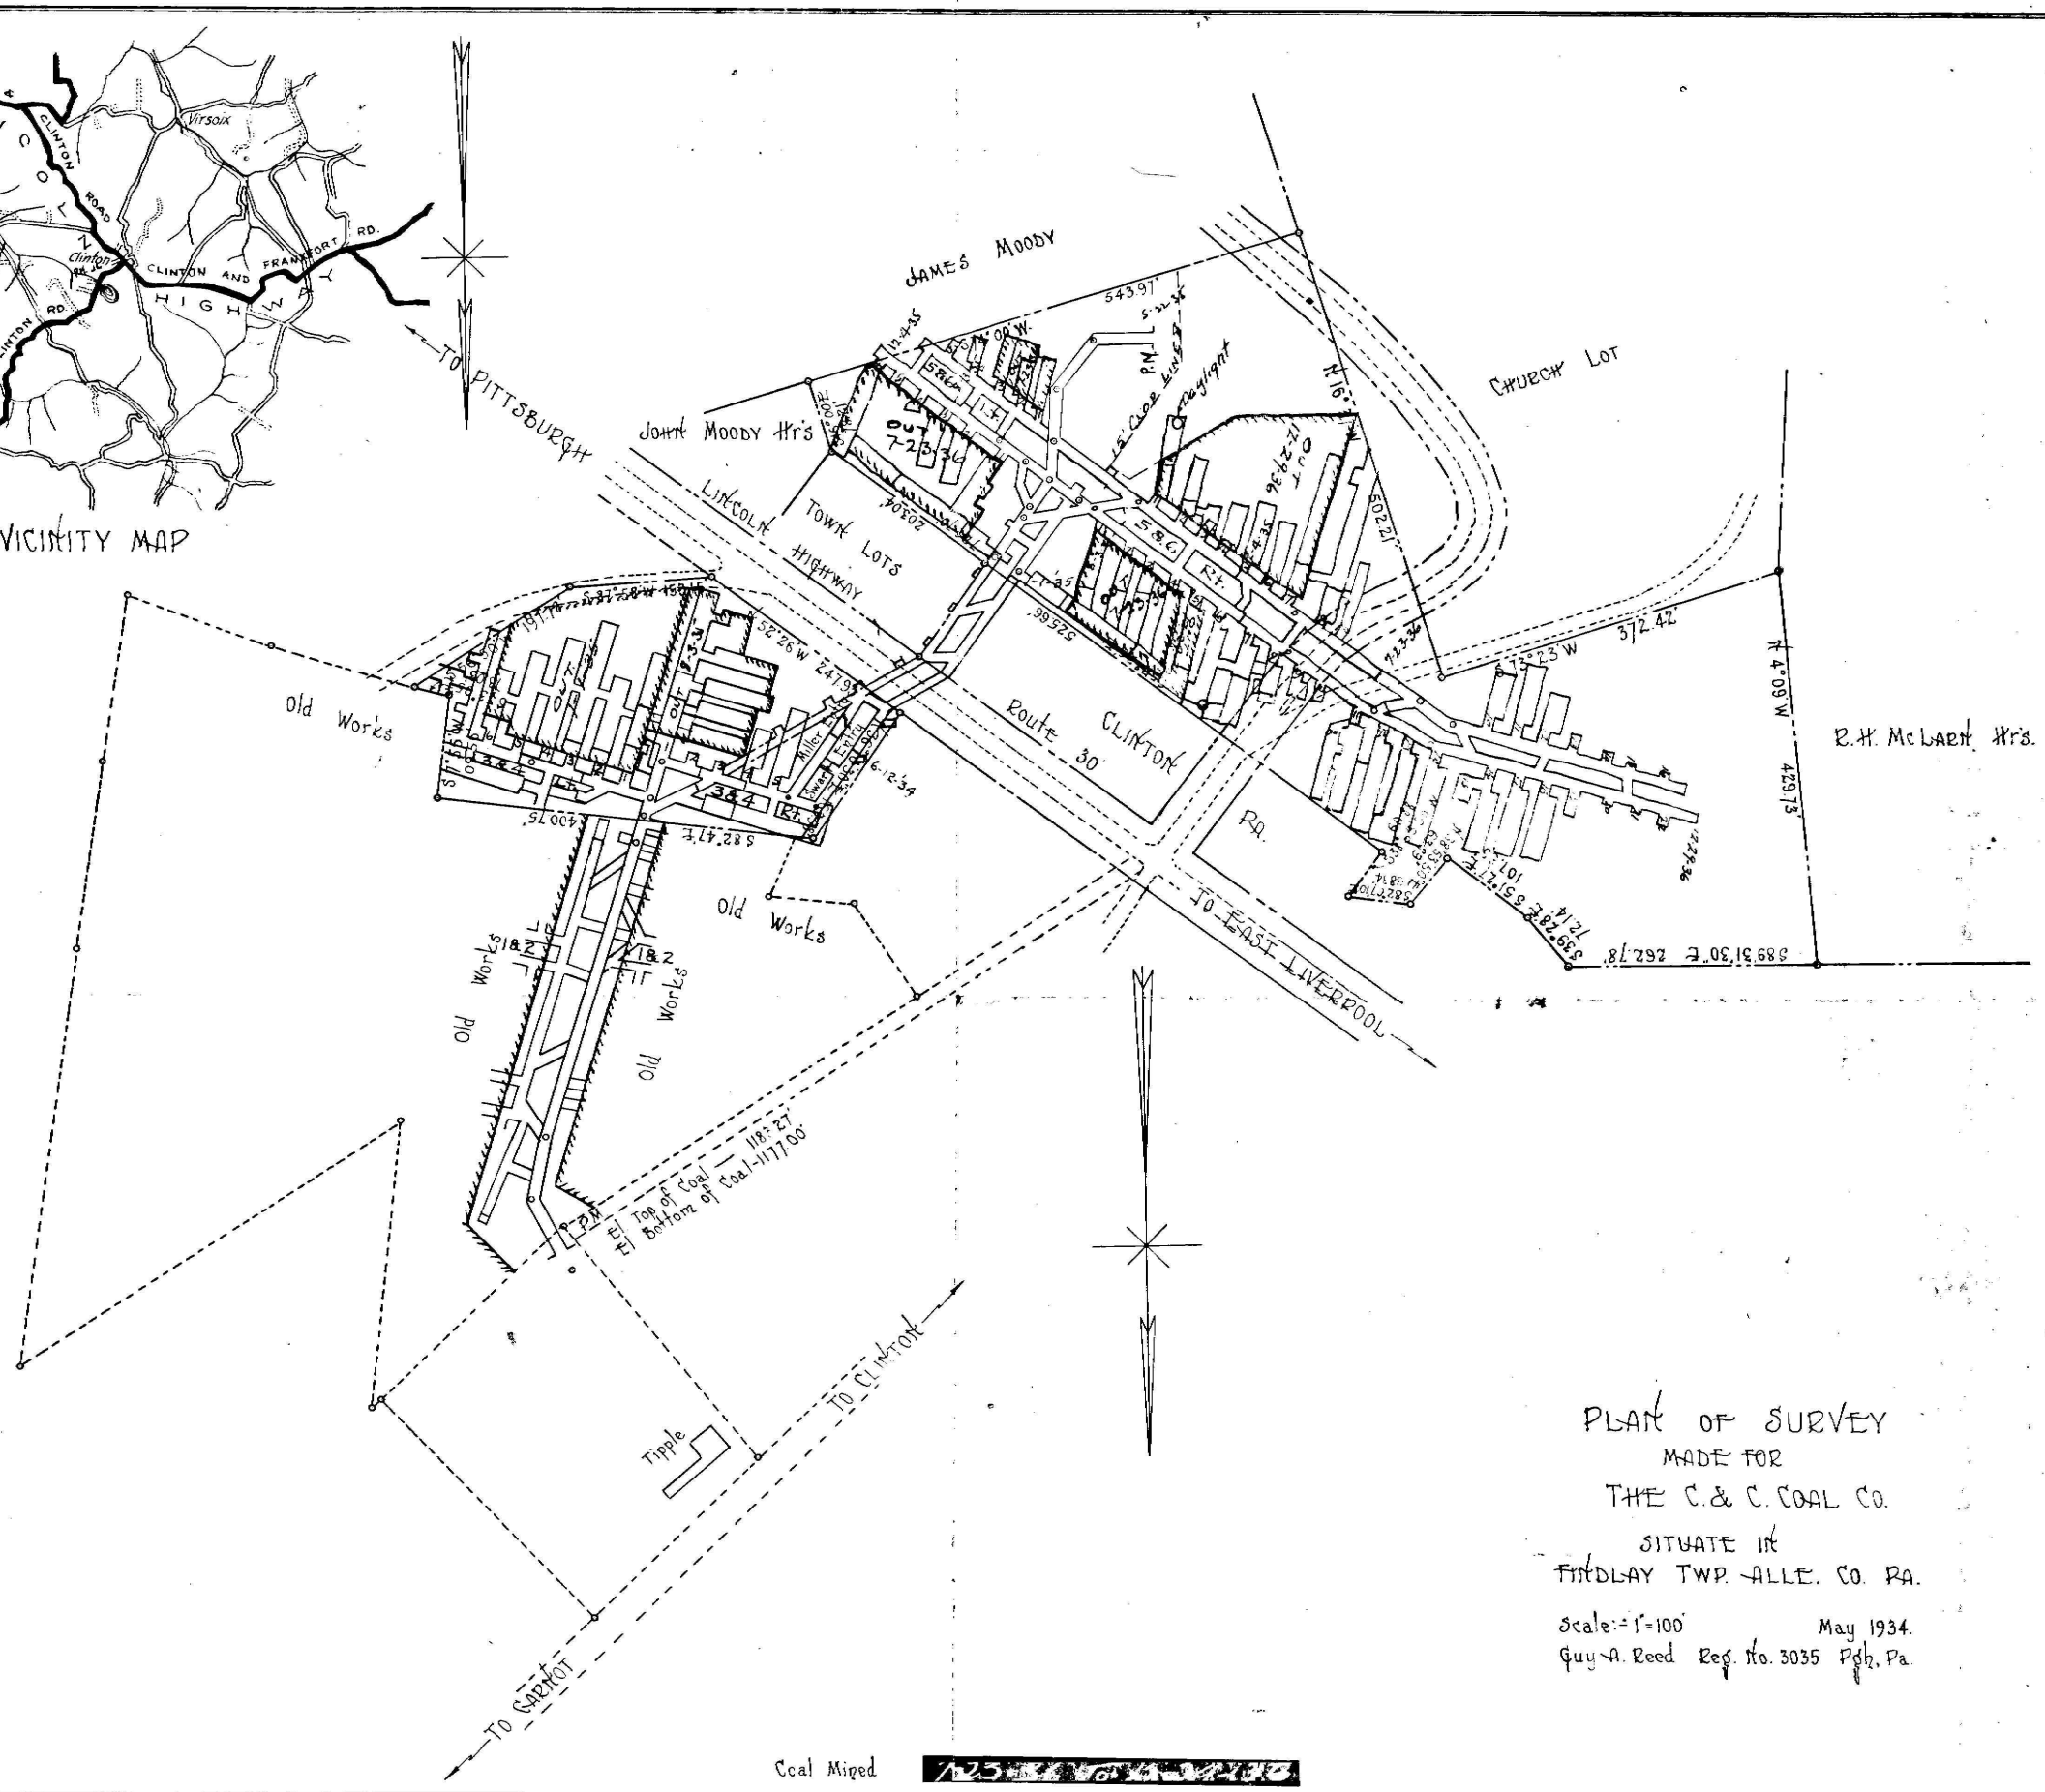

PLAN OF SURVEY
MADE FOR
THE C. & C. COAL CO.
SITUATE IN
FINDLAY TWP. ALLE. CO. PA.

Scale:- 1"=100' May 1934.
Guy A. Reed Reg. No. 3035 Pgh. Pa.

Coal Mined