


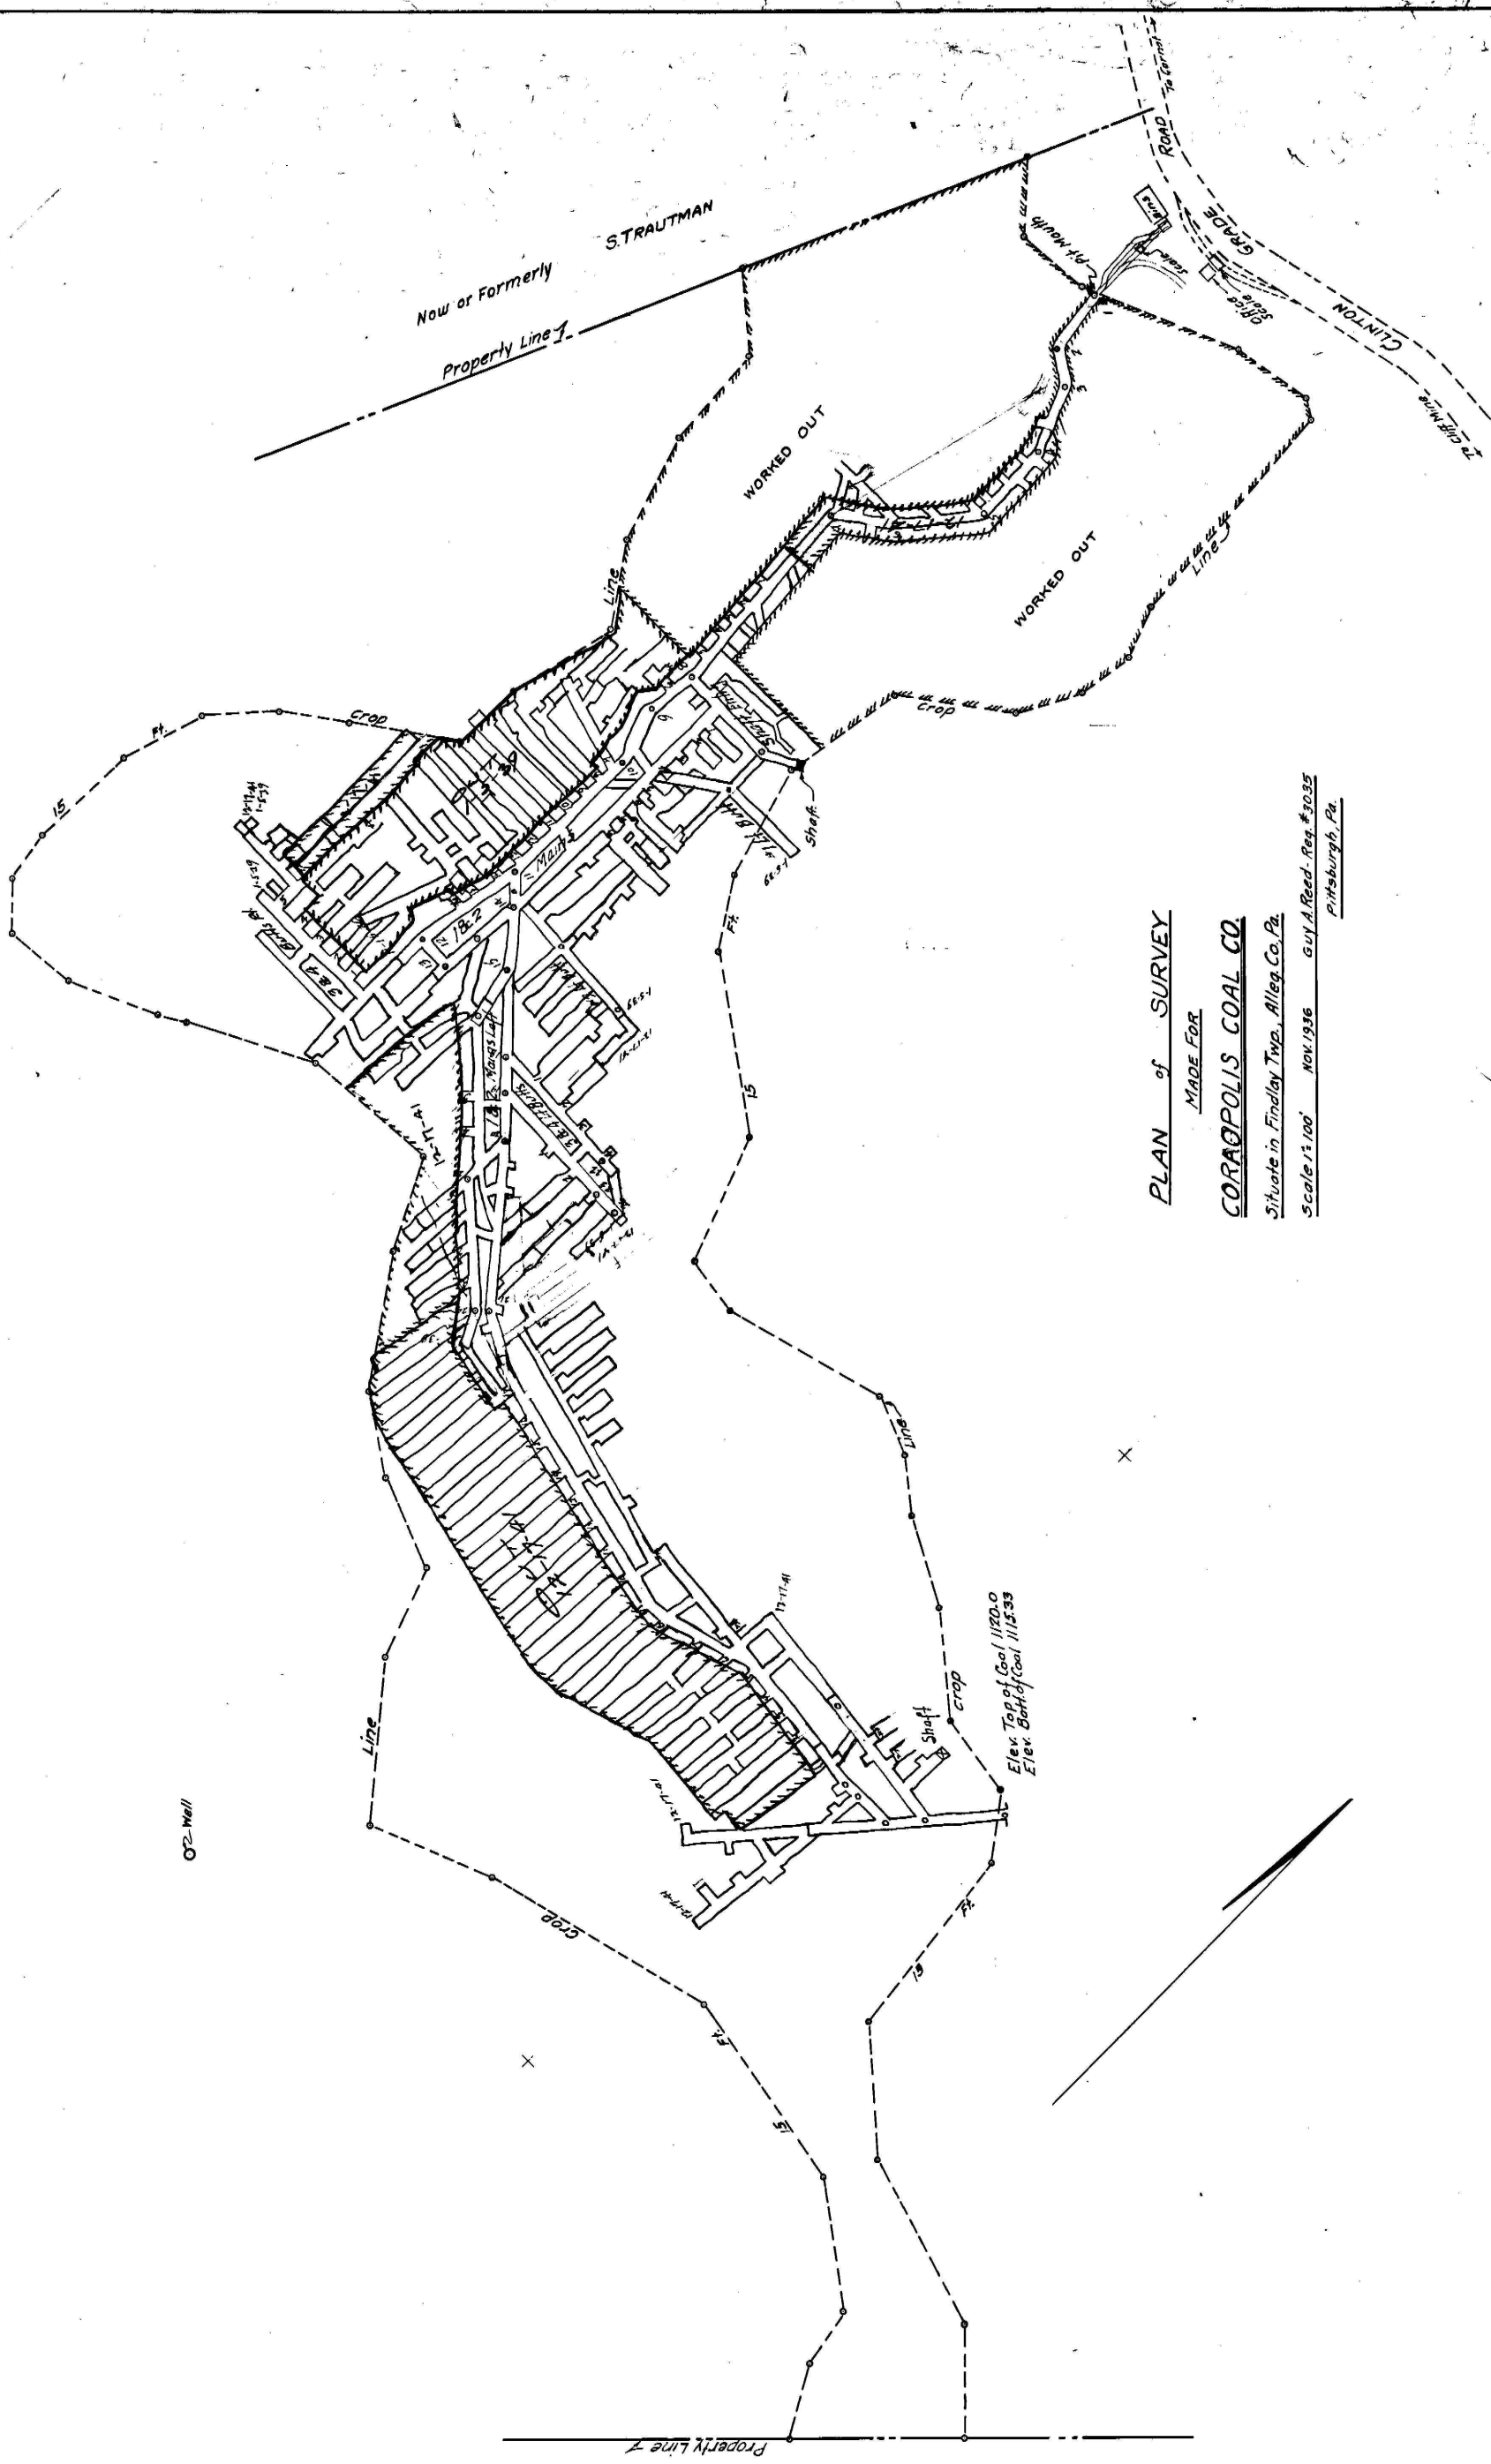

PLAN of SURVEY

MADE FOR

CORACOPOLIS COAL CO.

Situate in Findlay Twp., Alleg. Co., Pa.

Scale 1"=100' NOV. 1936 GUY A. REED, REG. #3035

Pittsburgh, Pa.

COAL MINED

N.A. #23-36

85

85