


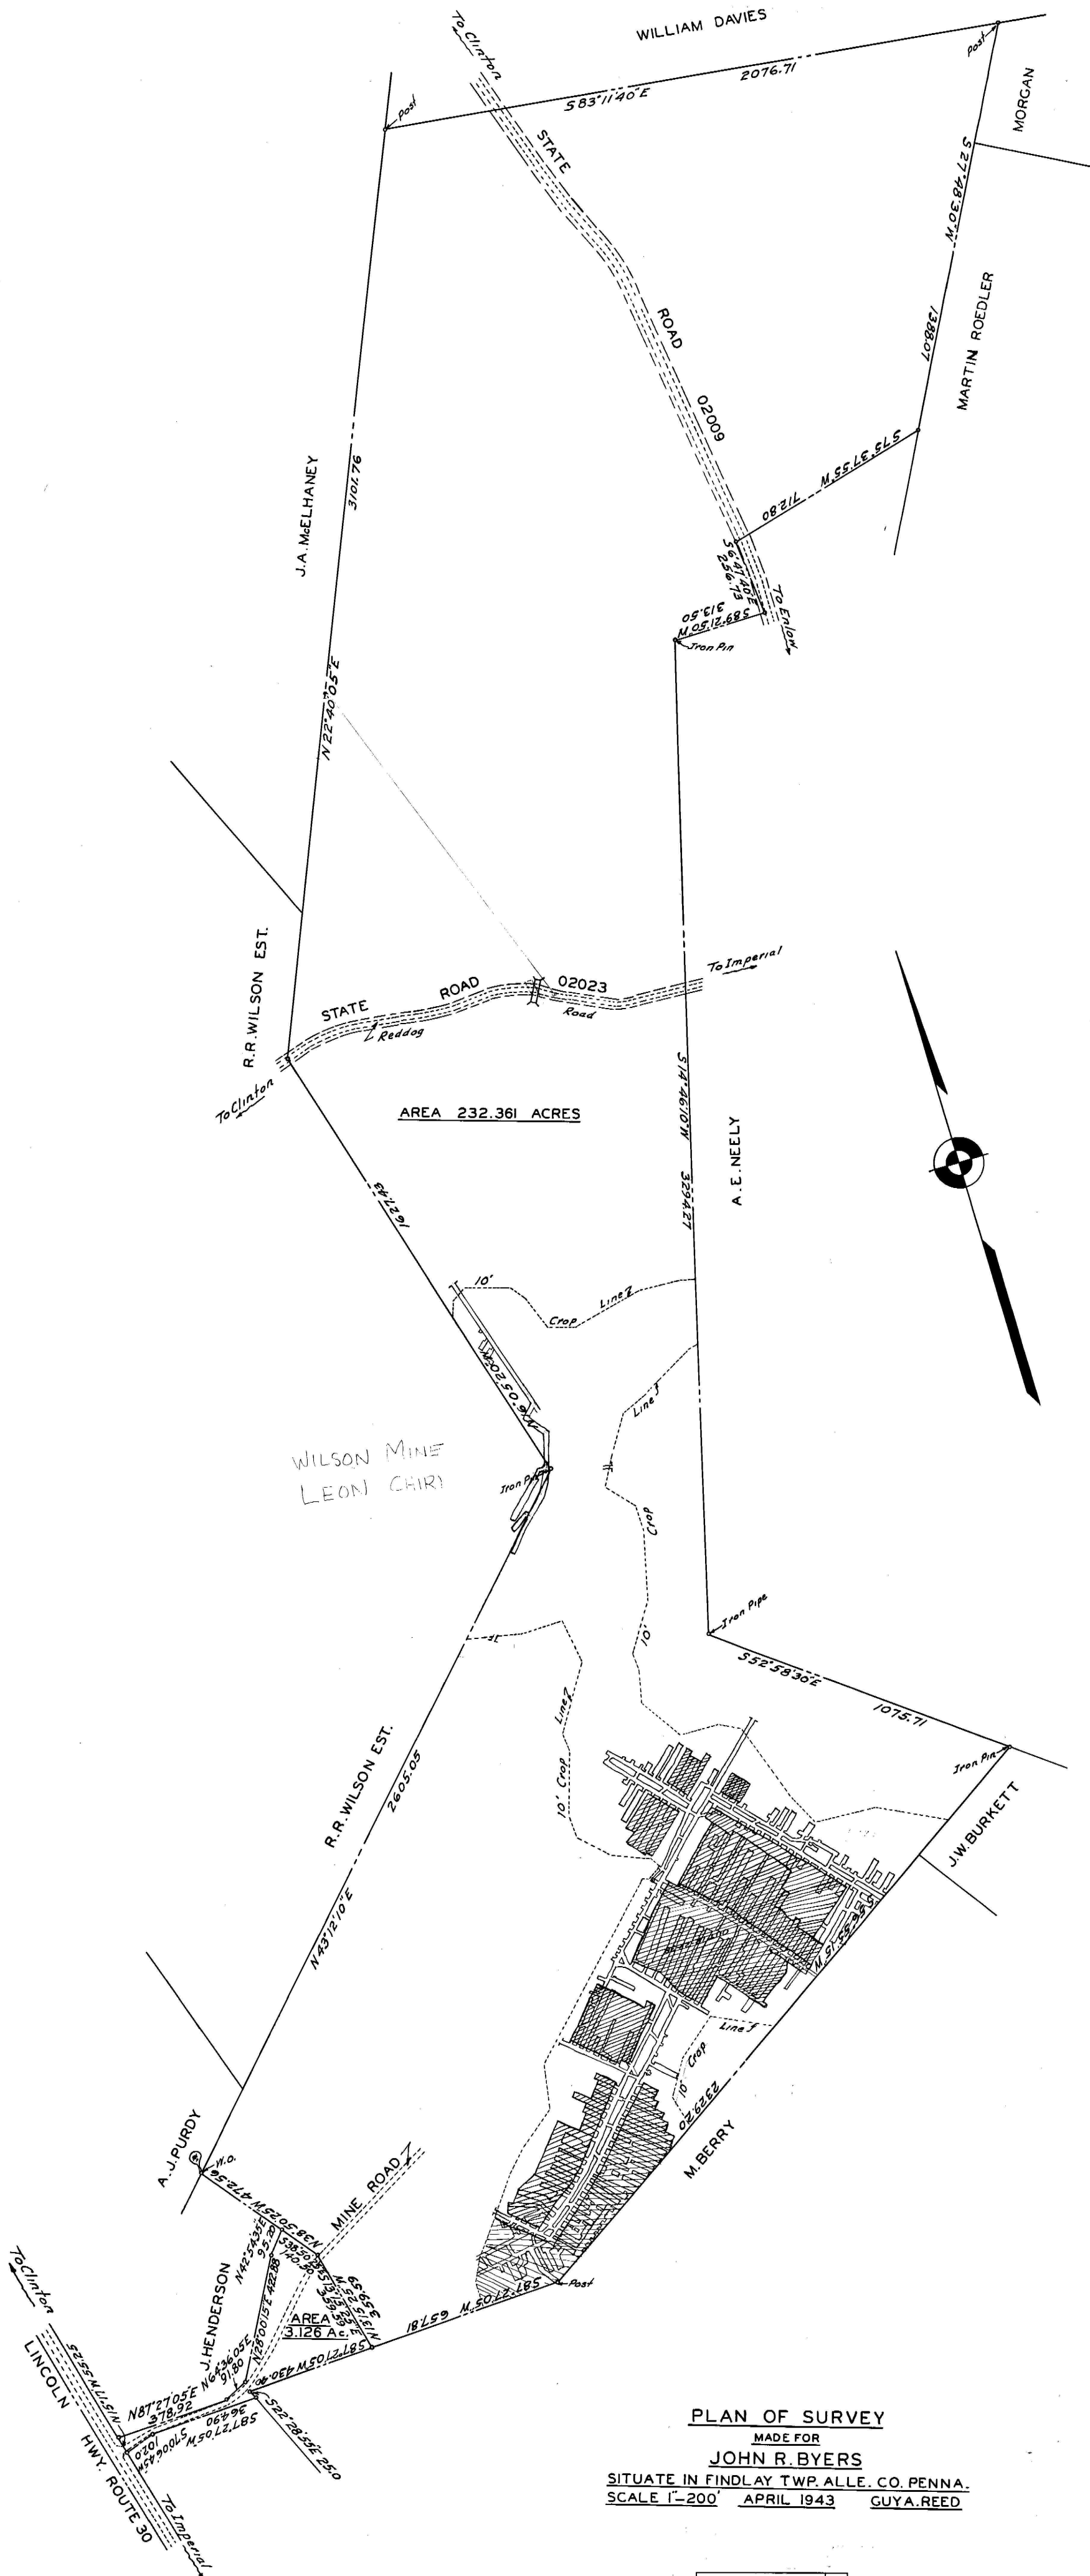

PLAN OF SURVEY
 MADE FOR
 JOHN R. BYERS
 SITUATE IN FINDLAY TWP. ALLE. CO. PENNA.
 SCALE 1"=200' APRIL 1943 GUYA. REED

