


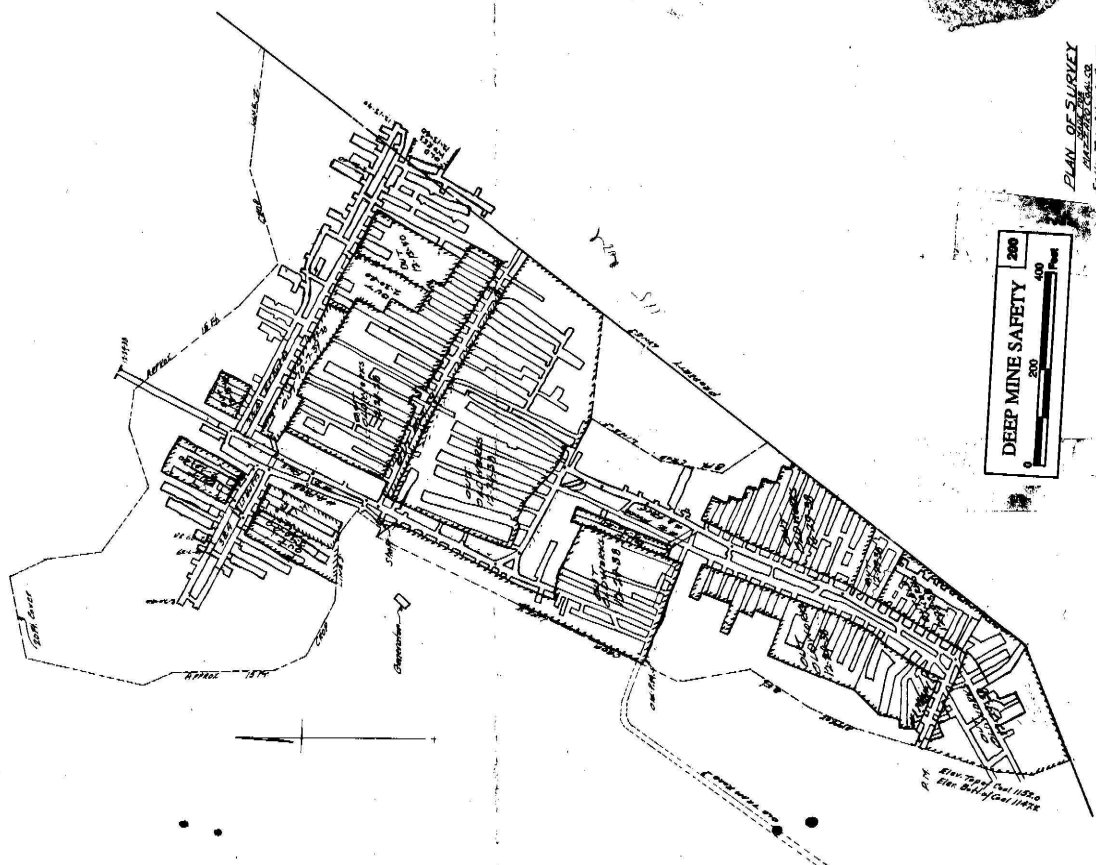

DEEP MINE SAFETY

200
100
0

Feet

PLAN OF SURVEY

