

BECCARIA TOWNSHIP
CLEARFIELD COUNTY
PERMIT NUMBER - 128-1
"D"-OR LOWER FREEPORT SEAM

Combes Coal Co.
Horseman's Dr.
Combes of Mine
12-12-66
Chas. H. Buck, P.E.


UNITED STATES
DEPARTMENT OF THE INTERIOR
GEOLOGICAL SURVEY

STATE OF PENNSYLVANIA
REPRESENTED BY THE
DEPARTMENT OF INTERNAL AFFAIRS
TOPOGRAPHIC AND GEOLOGIC SURVEY

PENNSYLVANIA
ALTOONA QUADRANGLE
(1800000 FT SOUTH)



CH Birdseye Chief Topographic Engineer
Frank Sutton Topographic Engineer in charge
Topography by J. Gayetty W.S. Beames and F.M. Schilling
Control by E.L. McNair A.H. Thompson J.L. Lenovitz
Pennsylvania State Highway Department and
Pennsylvania Railroad
S. eyed n 920

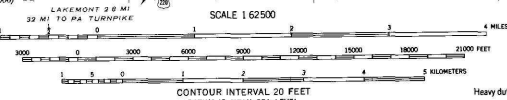

ROAD CLASSIFICATION
Heavy duty ——— Light duty ———
Medium duty ——— Unimproved dirt ———
U.S. Route ——— State F ———

ALTOONA PA
N 4030 - W 7815/15
1920

FOR SALE BY U.S. GEOLOGICAL SURVEY WASHINGTON D.C. 20242
A FOLDER DESCRIBING TOPOGRAPHIC MAPS AND SYMBOLS IS AVAILABLE ON REQUEST