


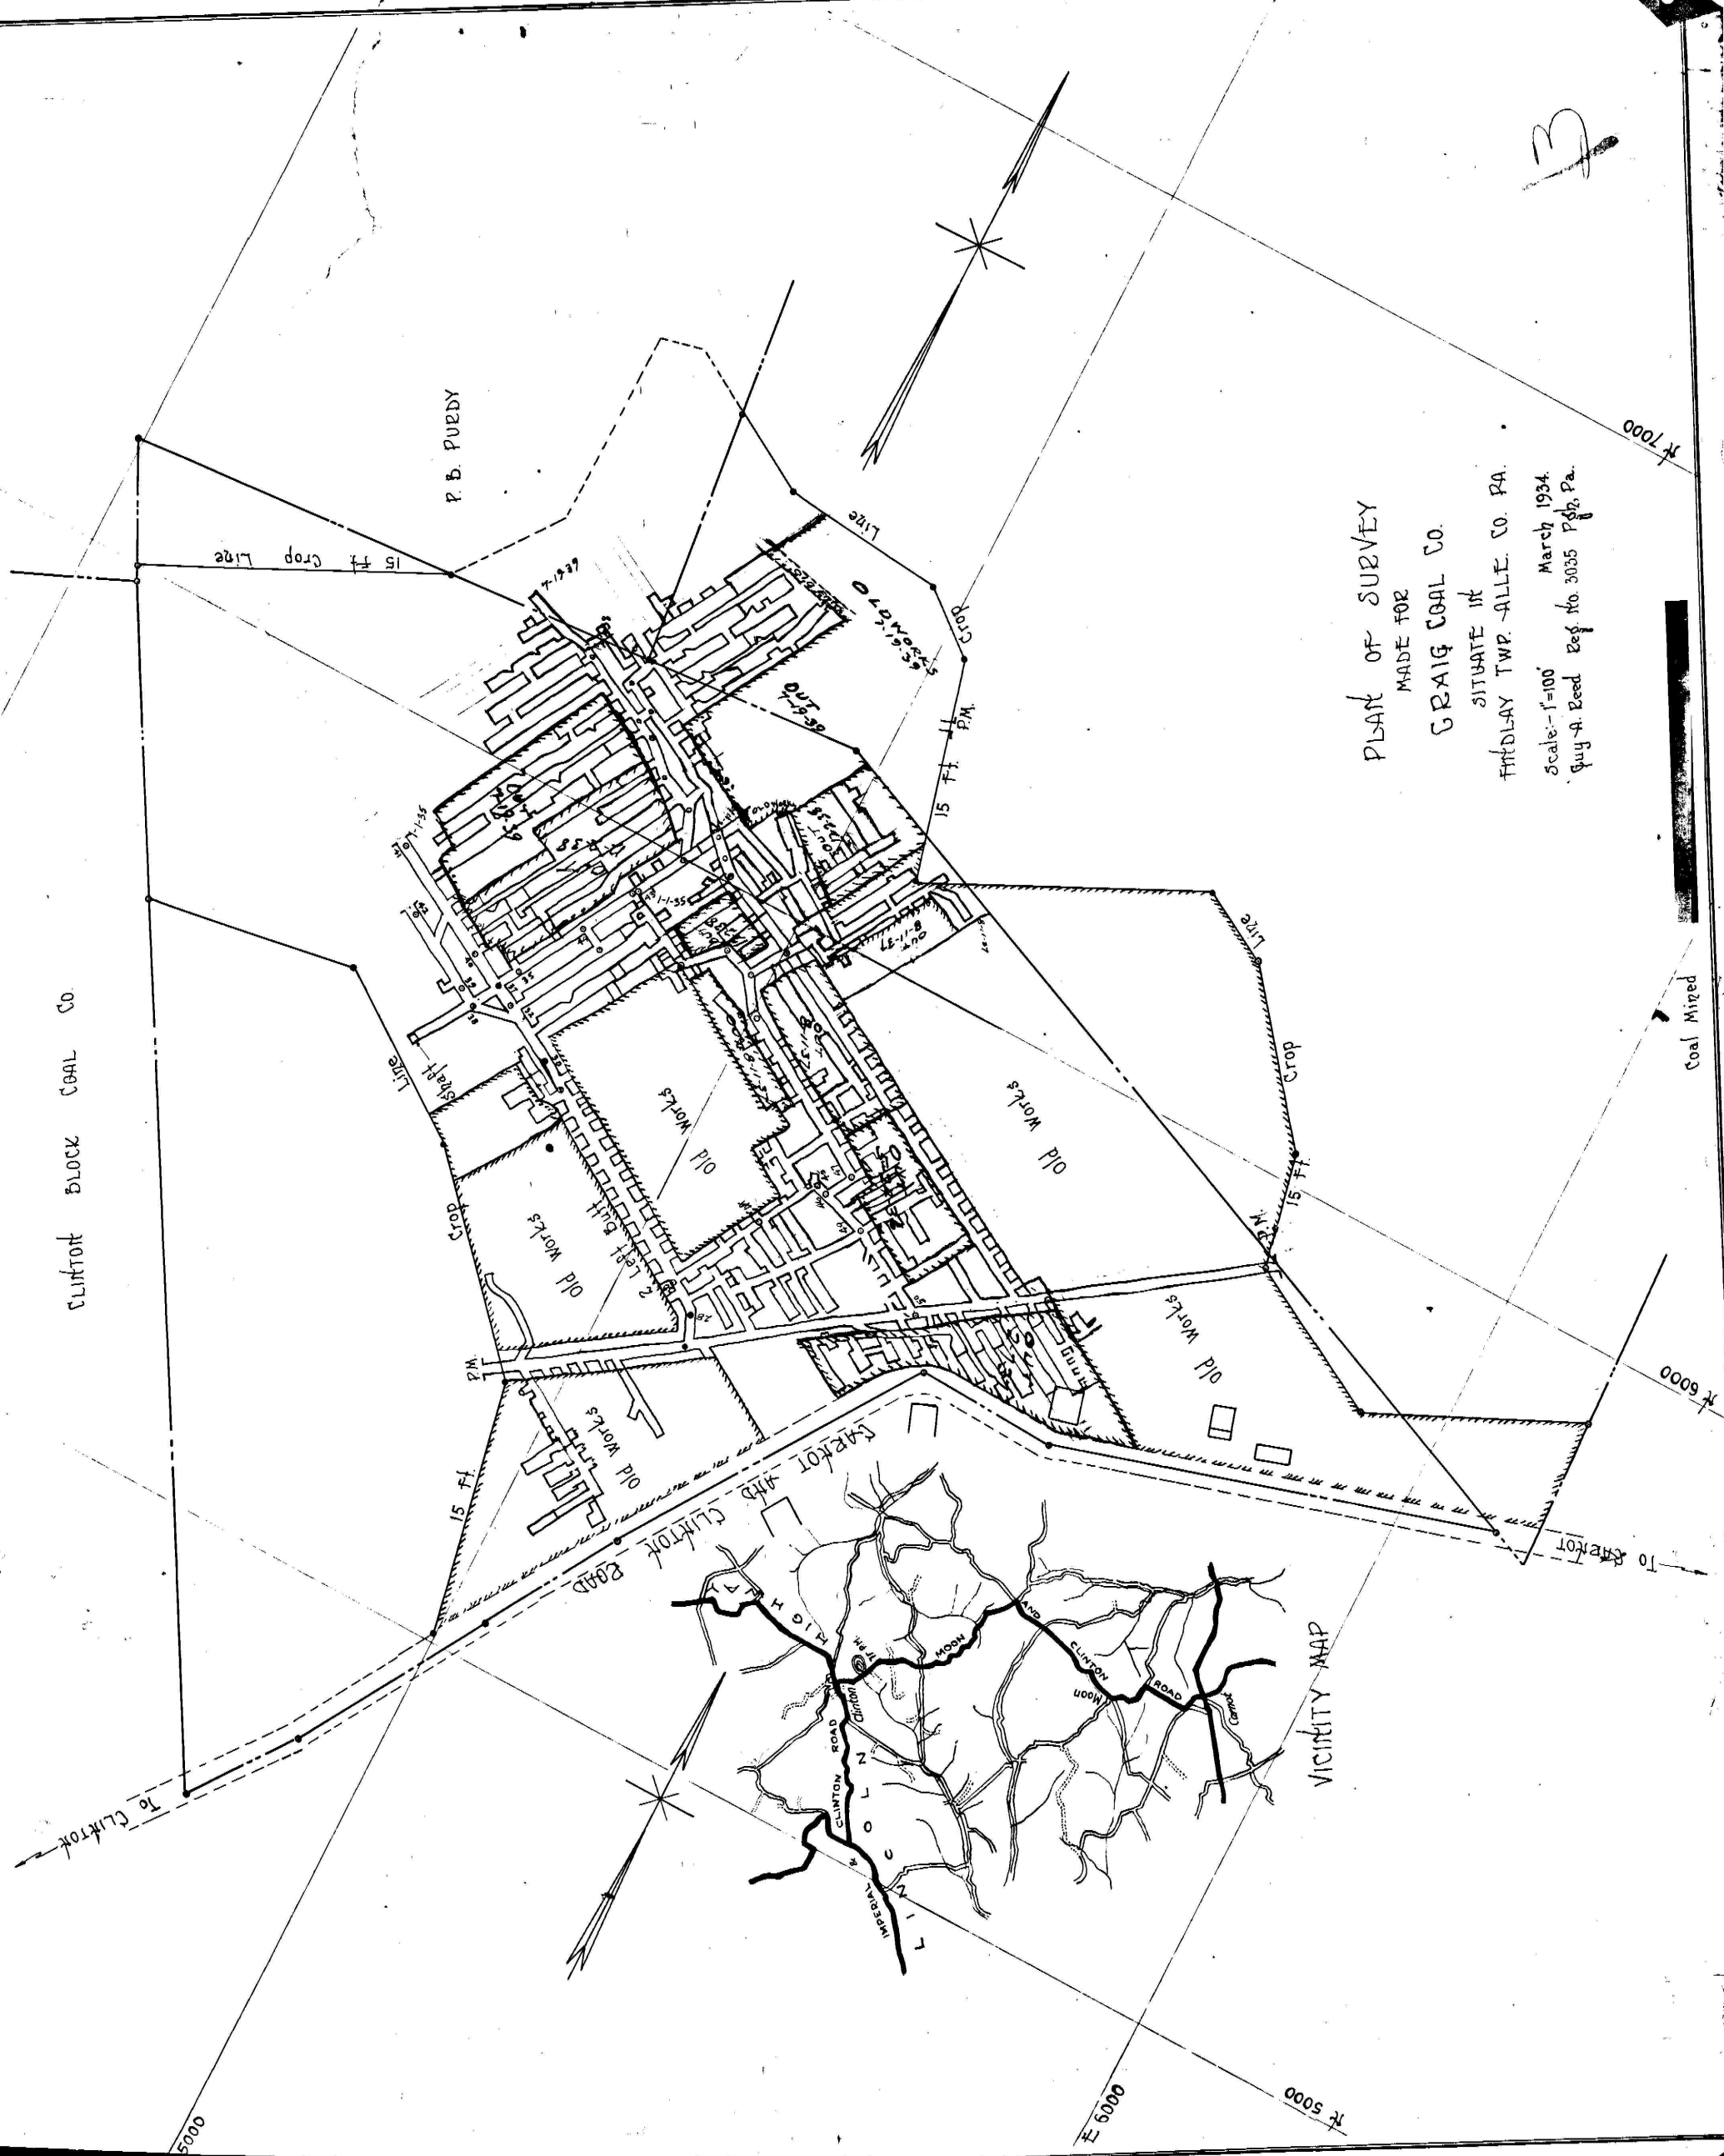

PLAN OF SURVEY
MADE FOR
CRAIG COAL CO.
SITUATE IN
FRIDLAY TWP. ALLE. CO. PA.
March 1934.
Scale: 1"=100'
Guy A. Reed Reg. No. 3035 Pgh. Pa.

coal mined