


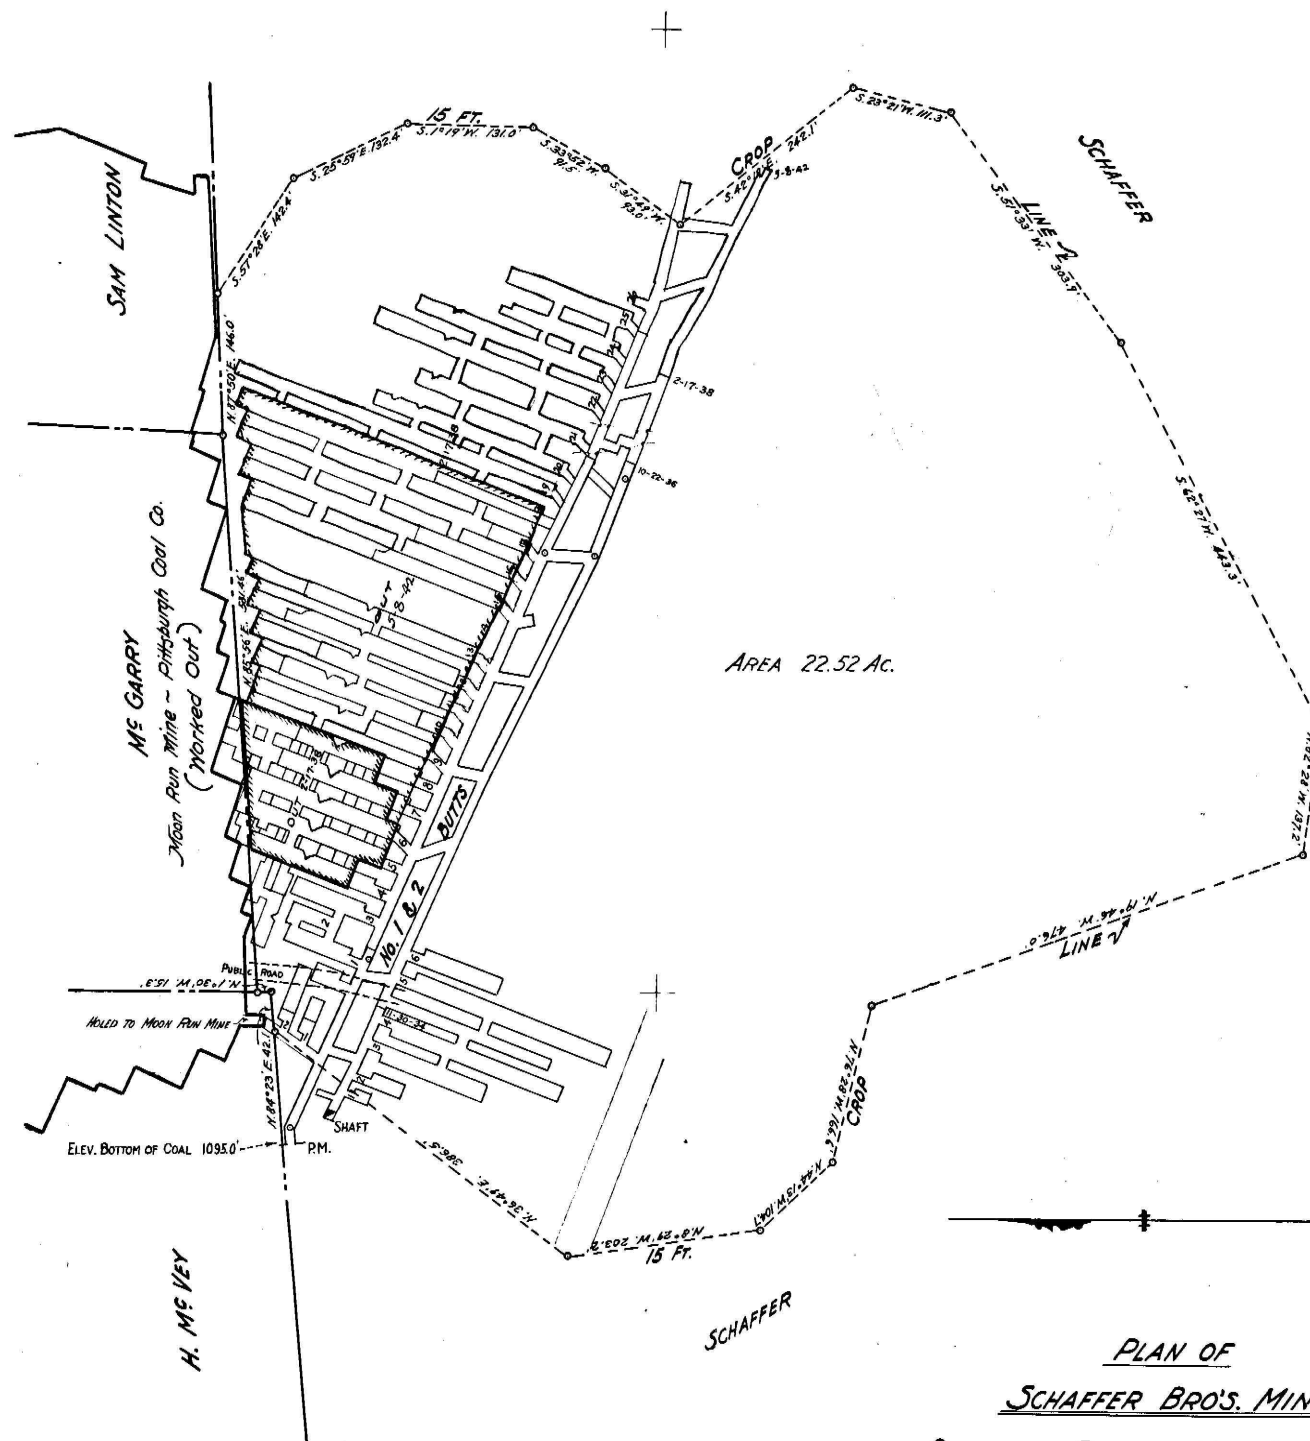

GOAL MINED - 5-8-4-L

PLAN OF
 SCHAFER BRO'S MINE
 SITUATE IN ROBINSON TWP.-ALLY. CO.-PA.
 SCALE 1"=100'
 OCT. 1936
 GUY A. REED-REG. 3035
 PITTSBURGH - PENN.