


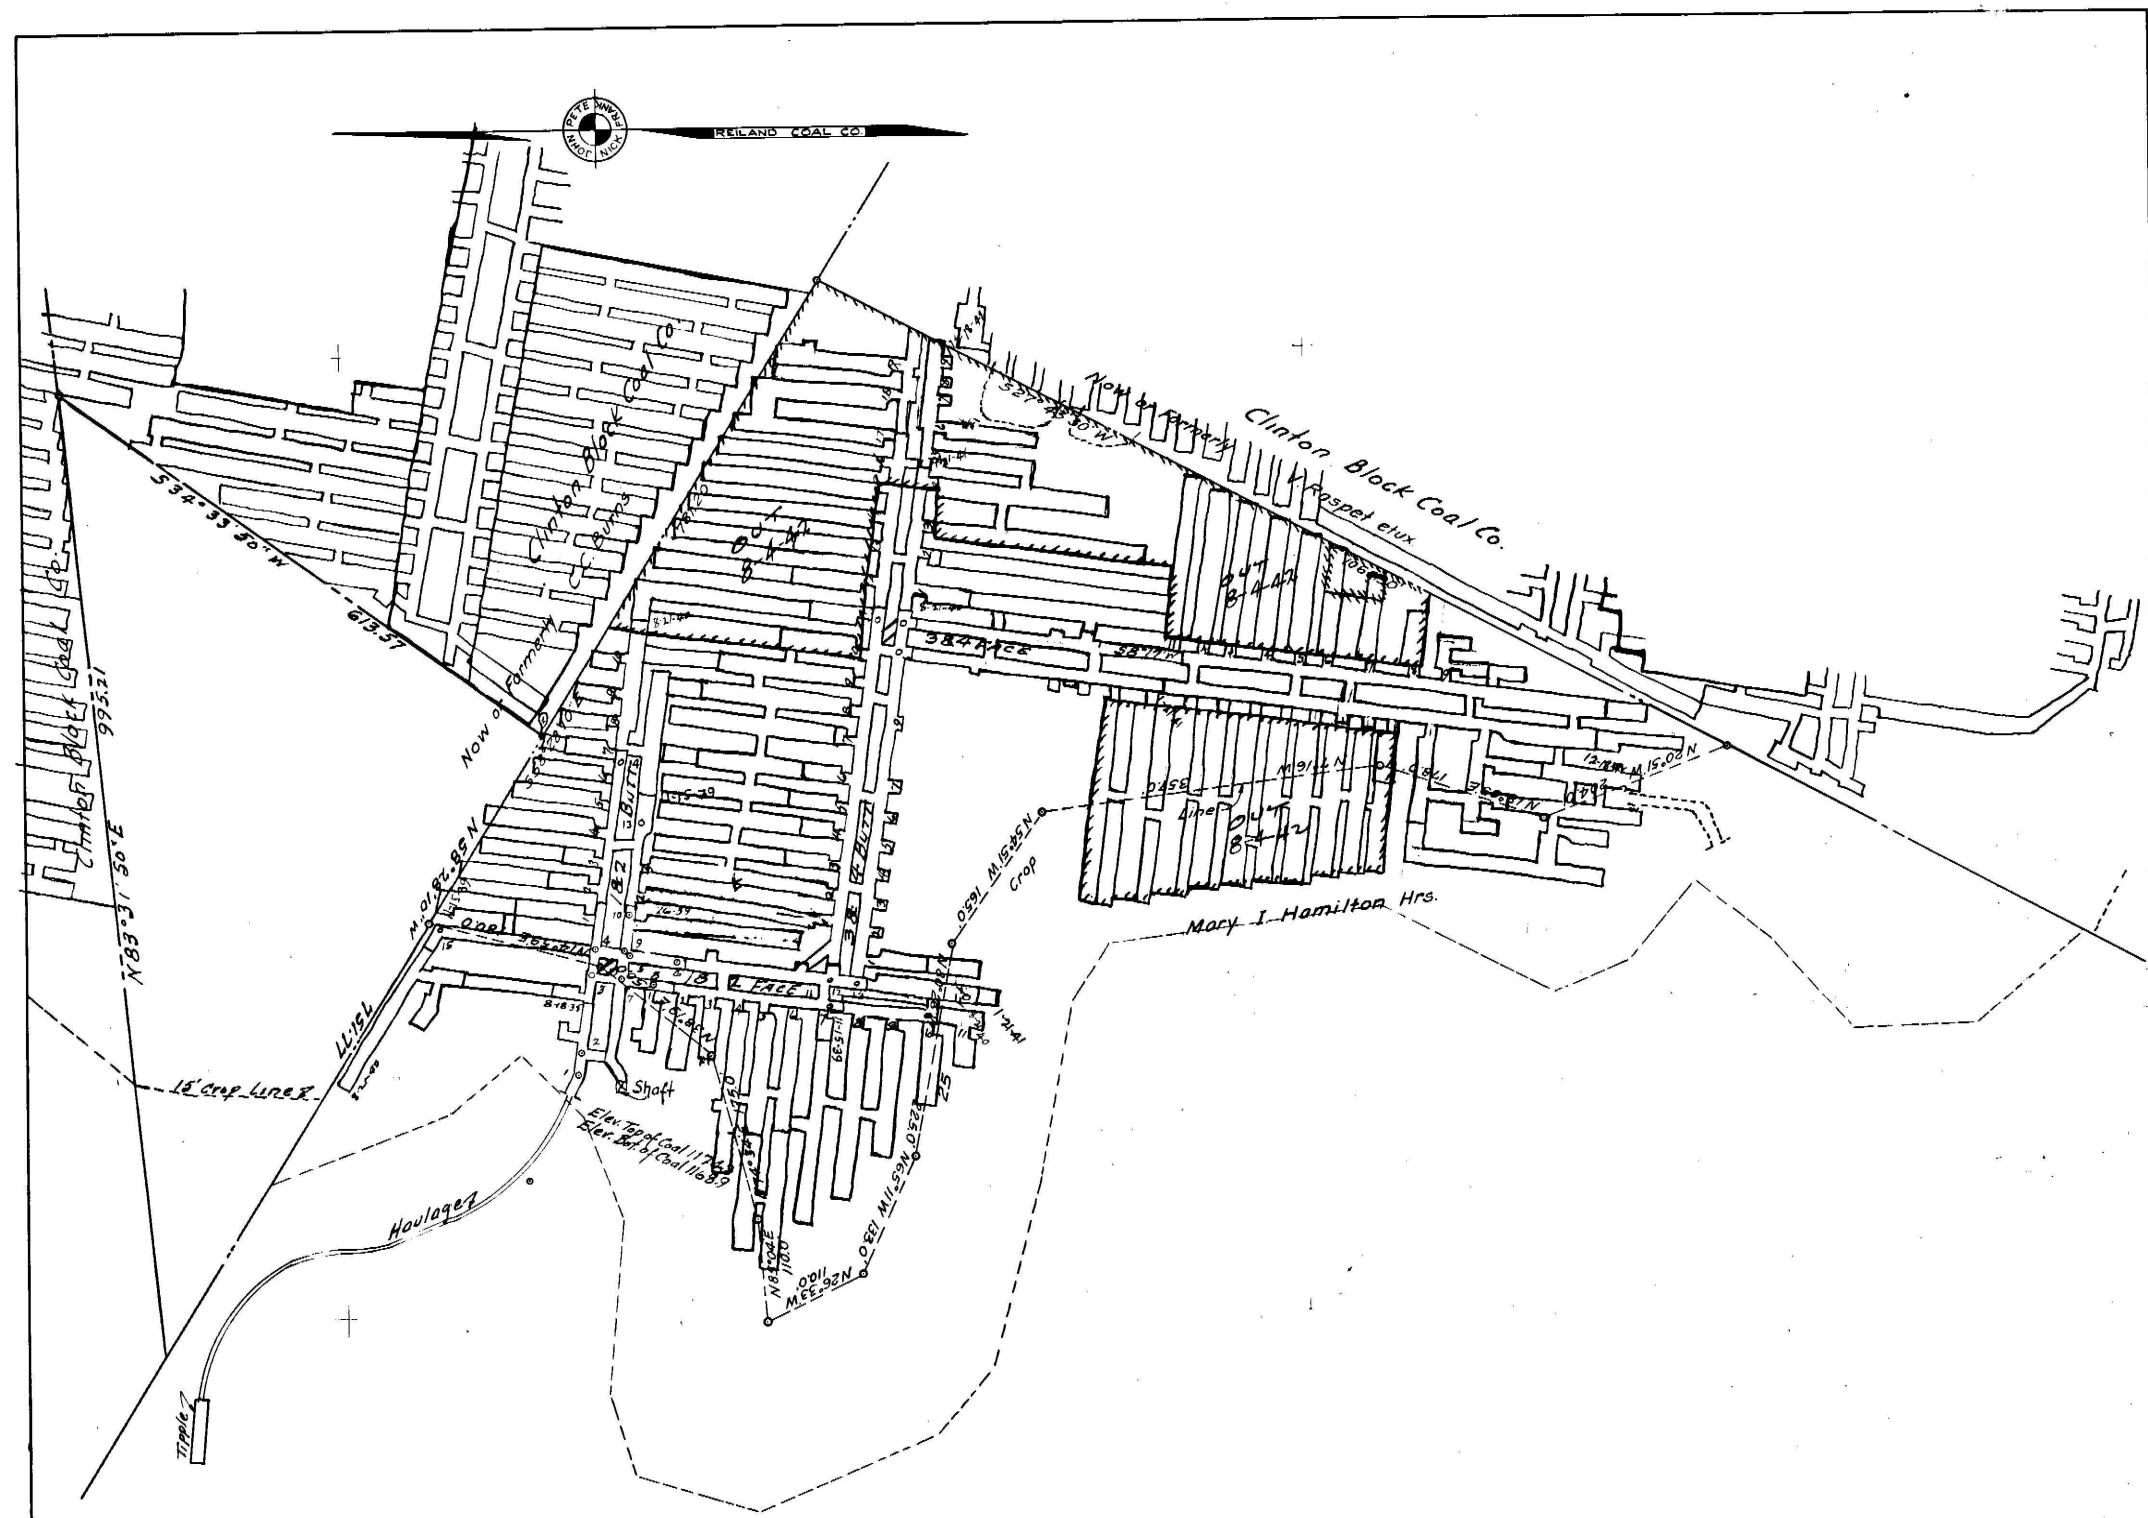

REILAND COAL CO.
 MINE NO. 2
 FINDLAY TWP. ALLE. CO. PA.
 SCALE 1"=100' APRIL 1938 GUY A. REED