


N.B. 21-45

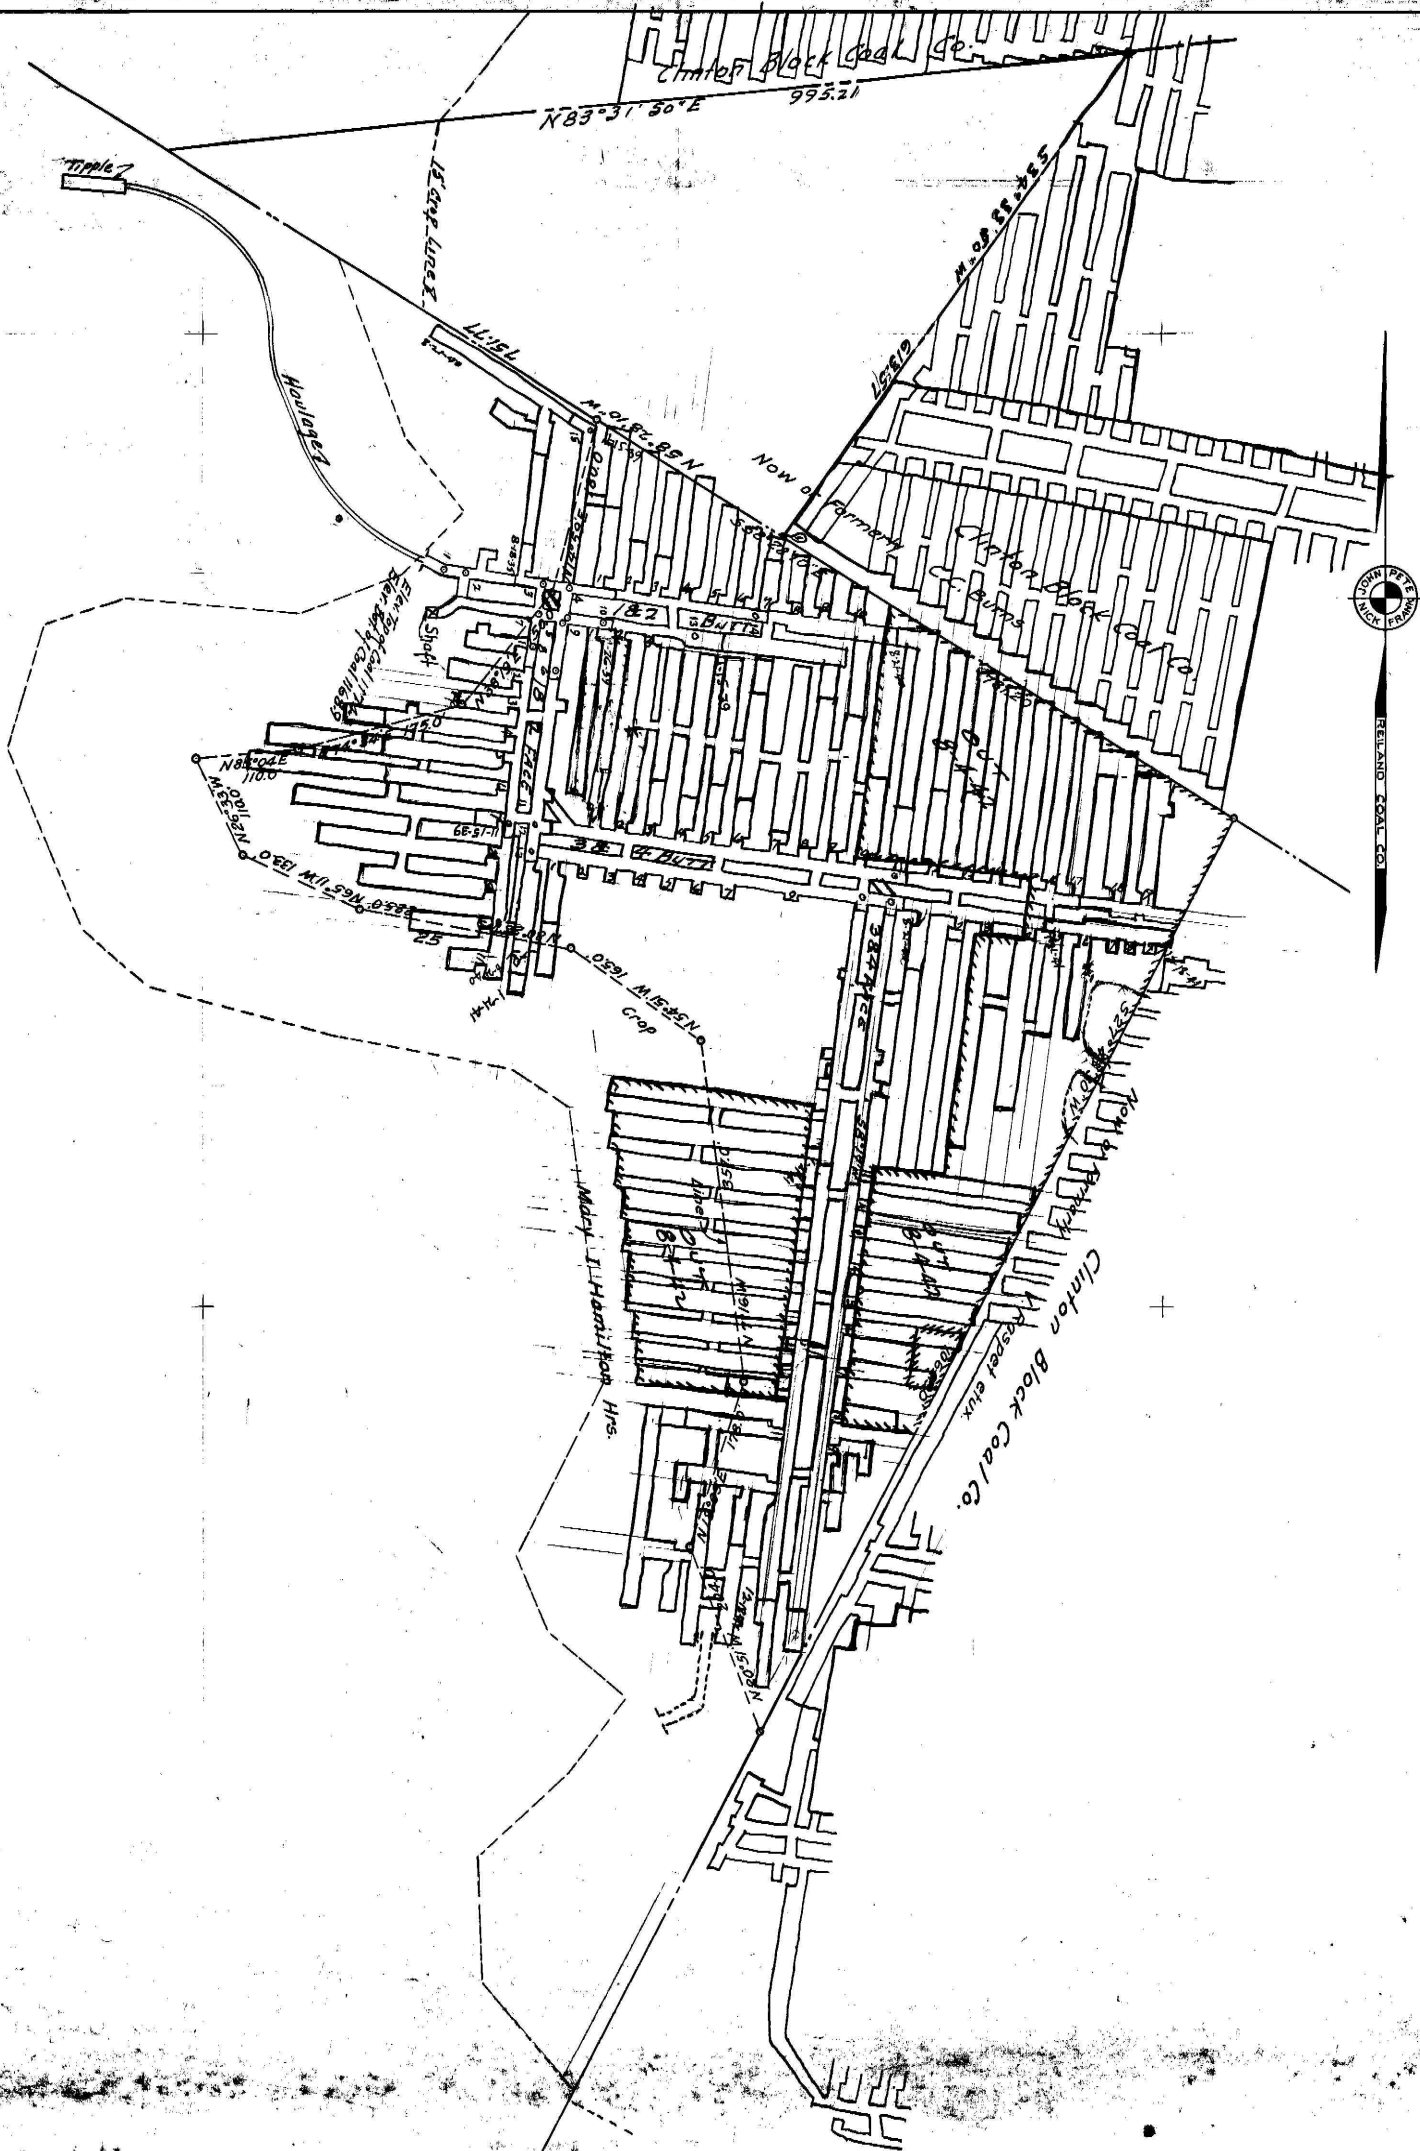

REILAND COAL CO.
MINE NO. 2
FINDLAY TWP. ALLE. CO. PA.
SCALE 1"=100' APRIL 1938 GUYA. REED

DEEP MINE SAFETY

0 100 200
Feet

100