


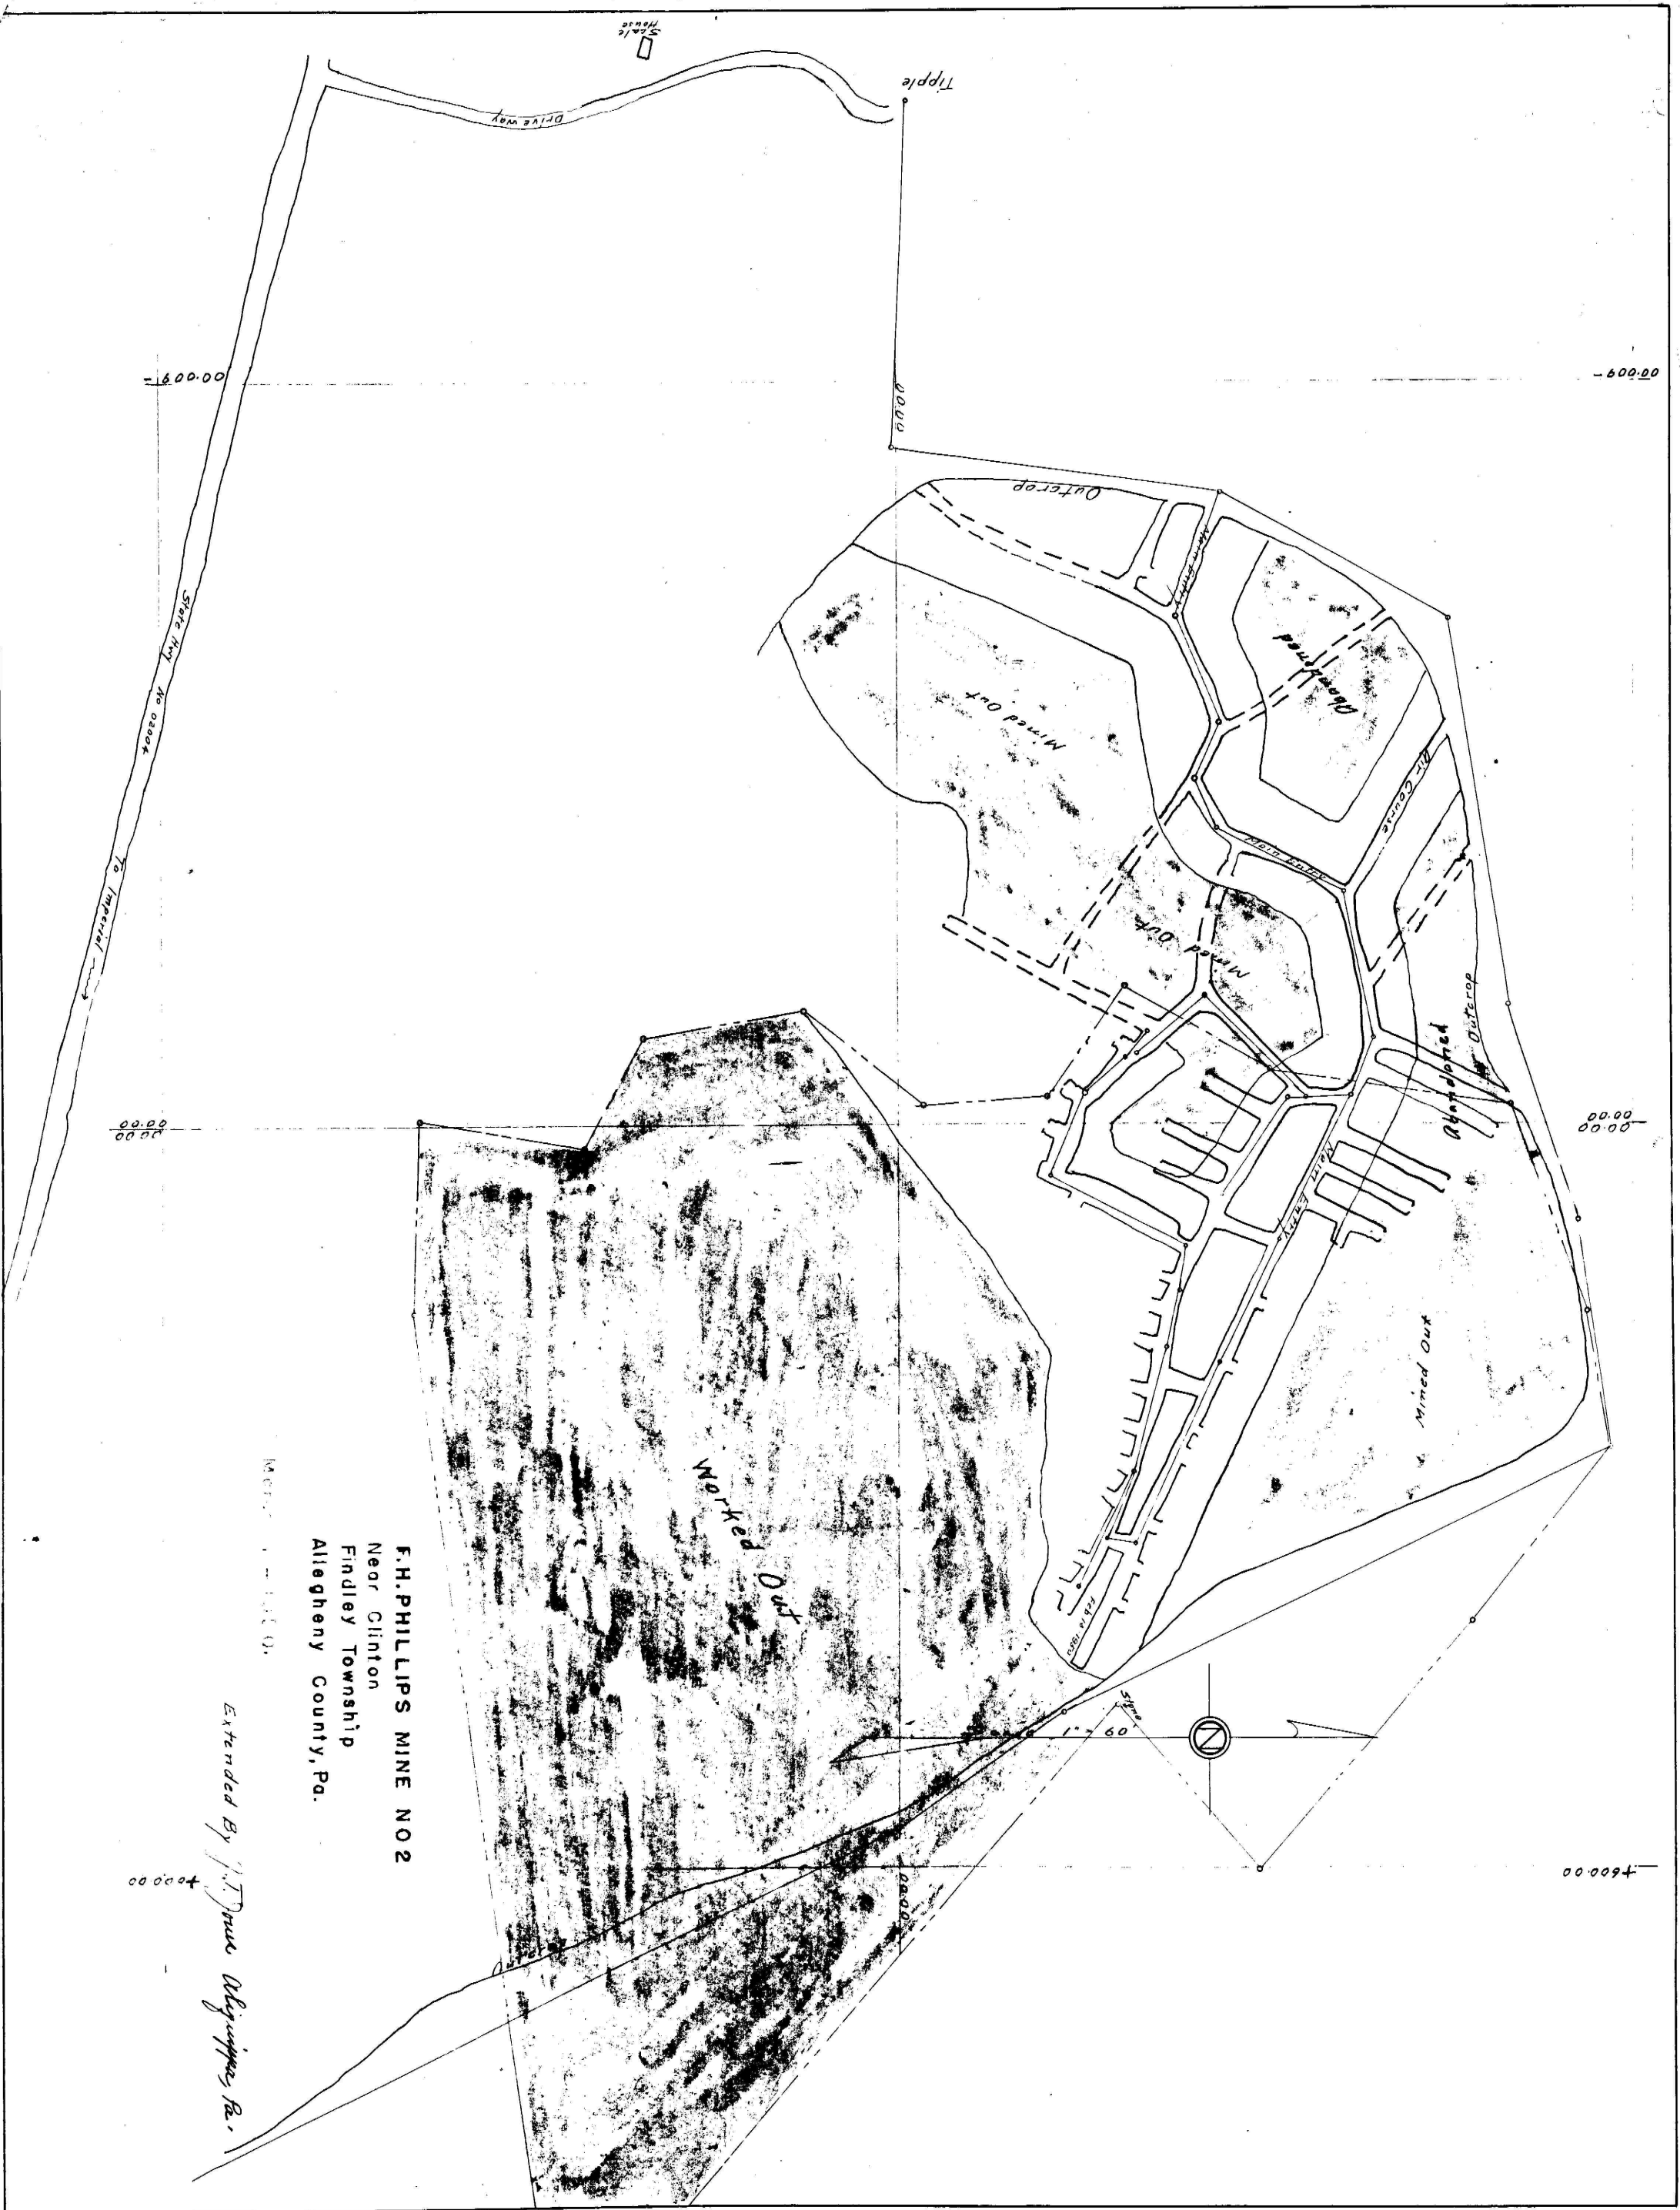

F.H. PHILLIPS MINE NO 2
Near Clinton
Findley Township
Allegheny County, Pa.

