


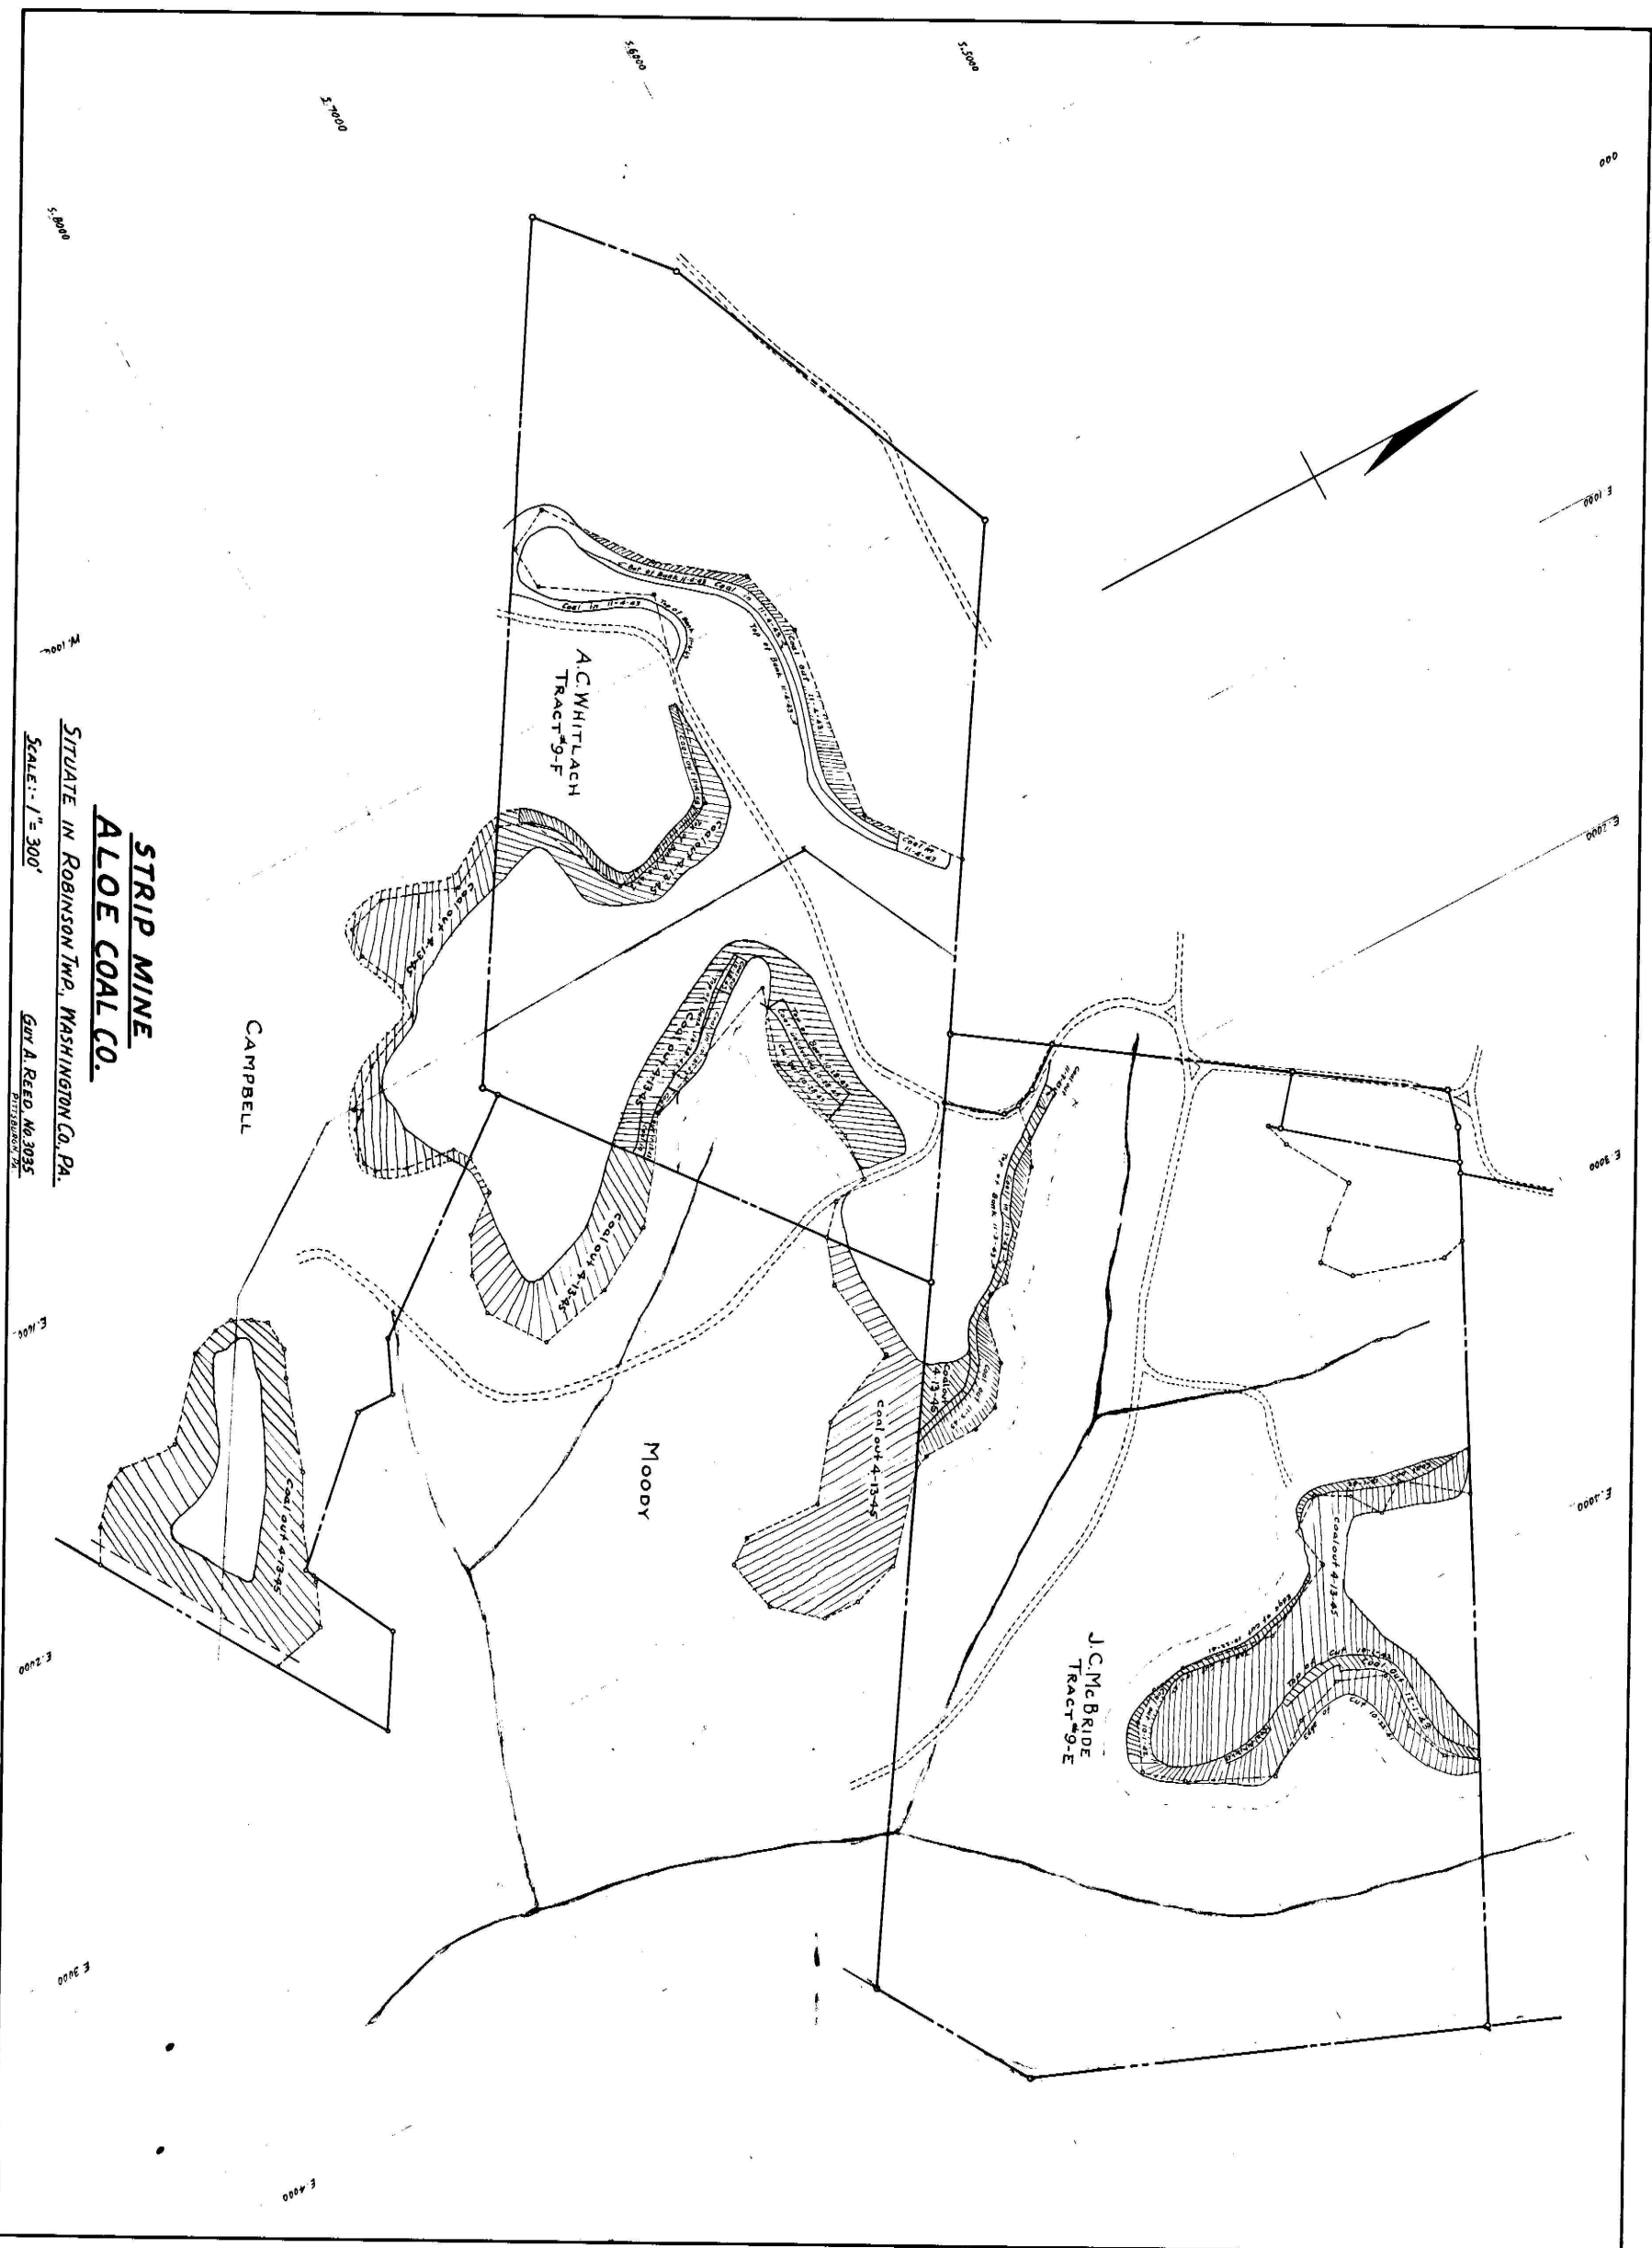

STRIP MINE
ALOE COAL CO.
SITUATE IN ROBINSON TWP, WASHINGTON CO, PA.
SCALE: 1" = 300'
GUY A. REED, NO. 3035
PITTSBURGH, PA.