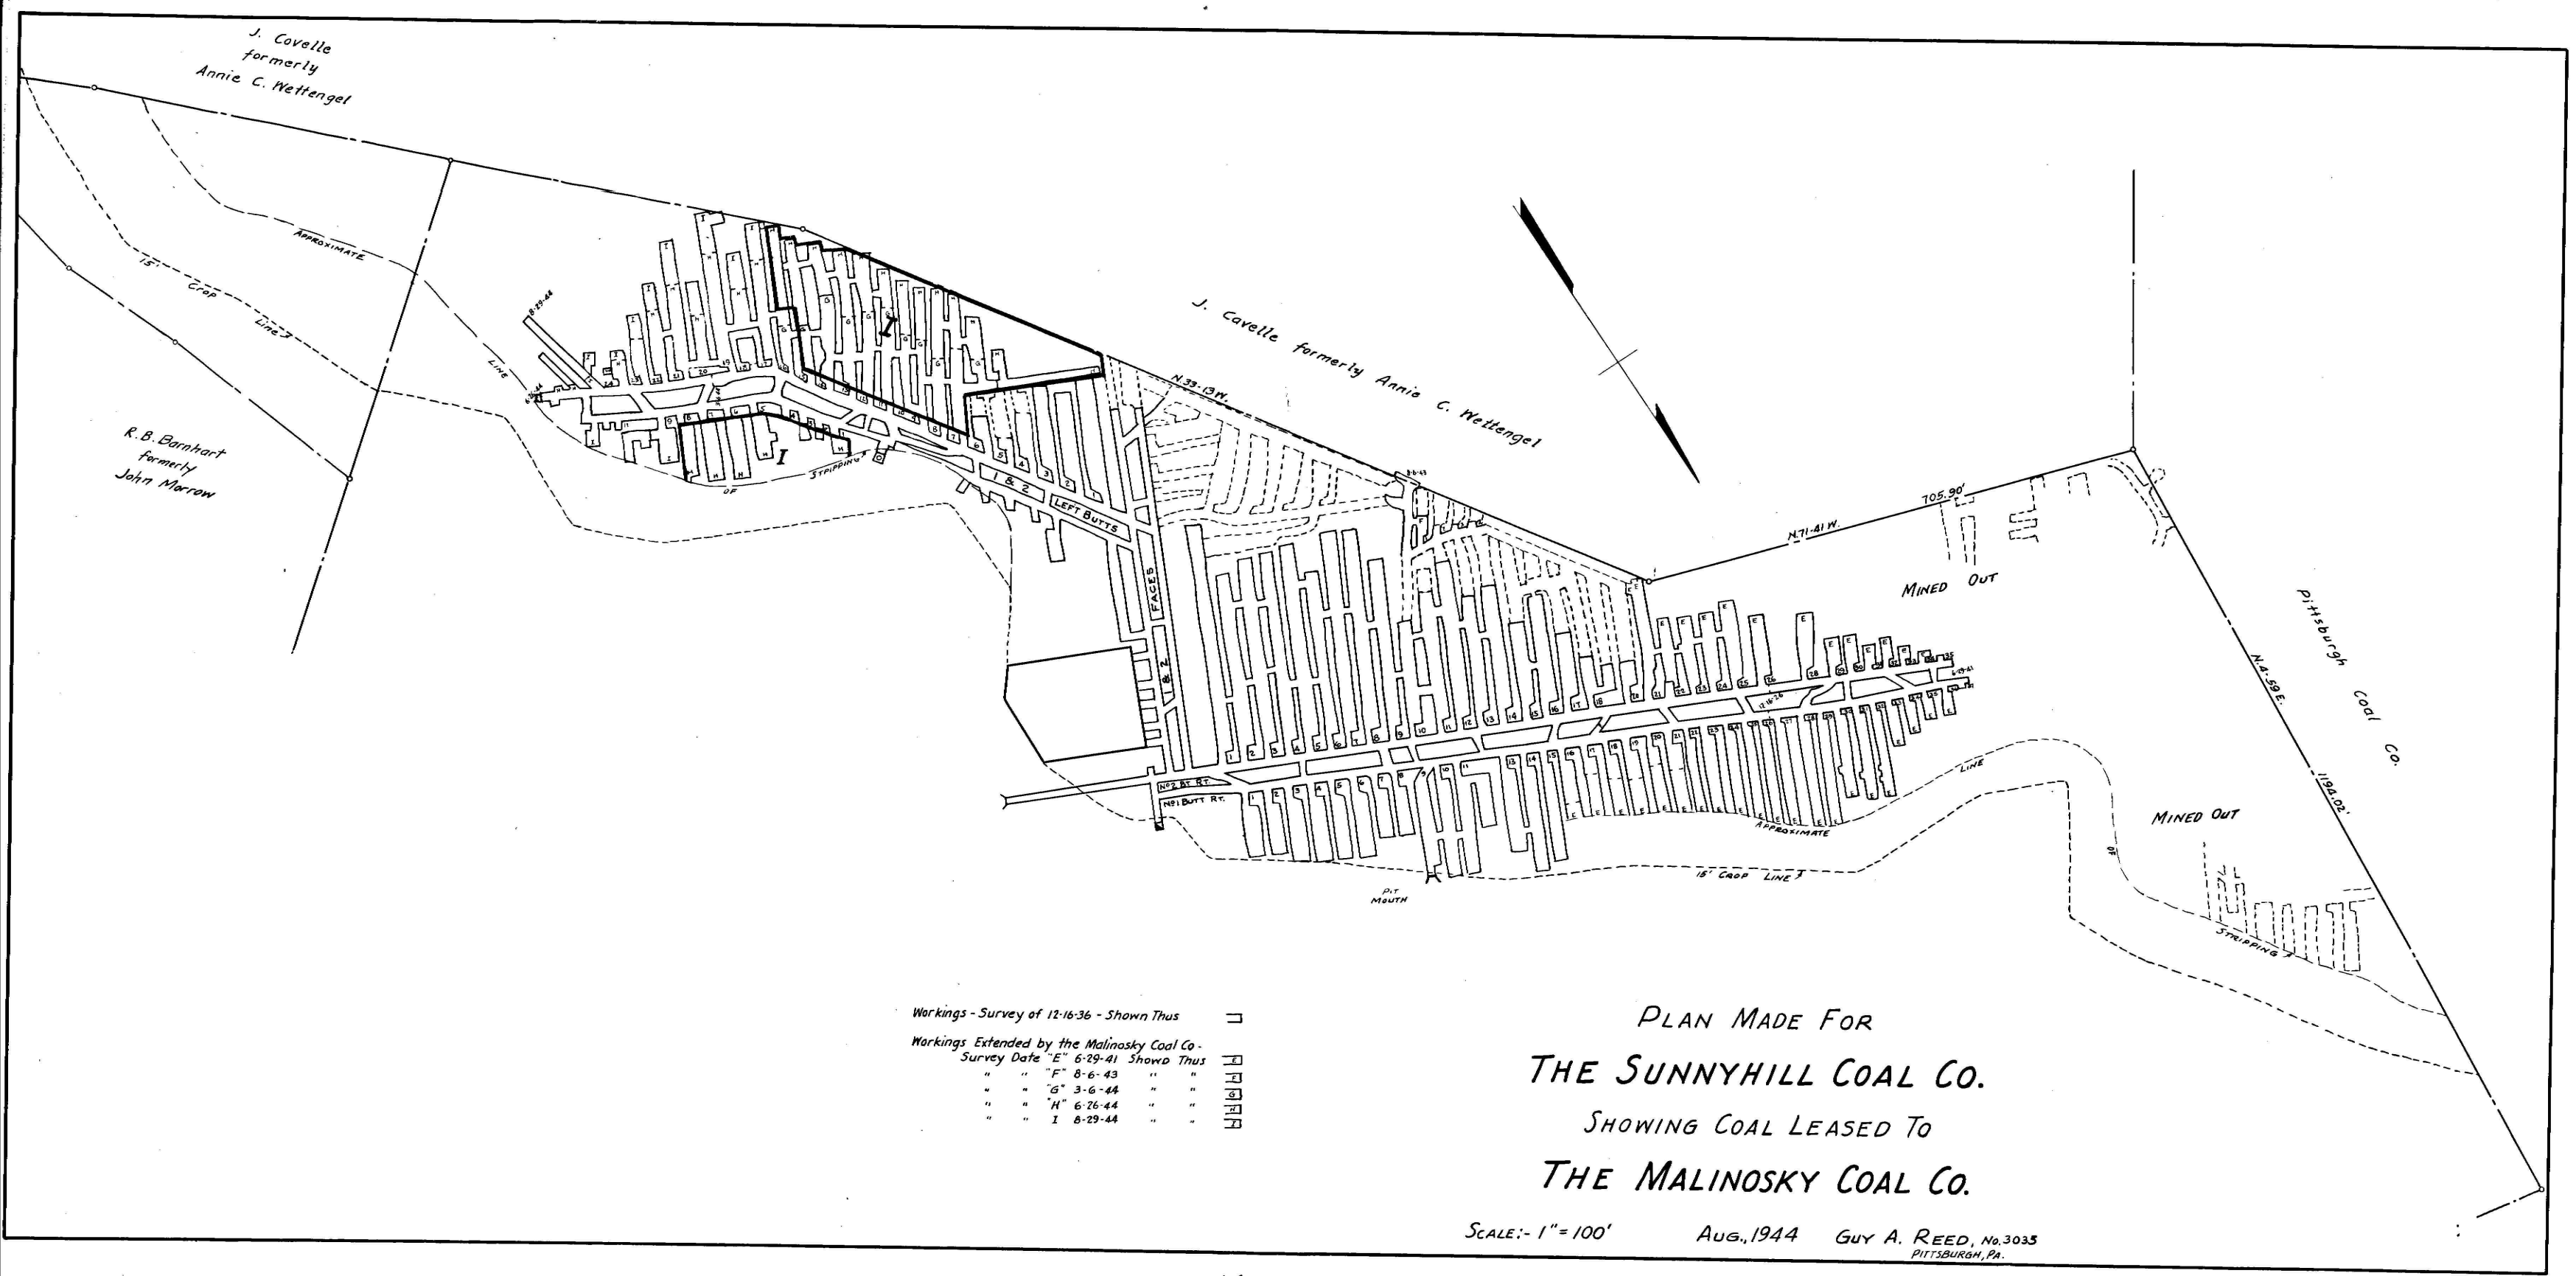
J. Covelle
formerly
Annie C. Wettengel
R. B. Barnhart
formerly
John Morrow
Approximate
15' Crop Line
J. Covelle formerly Annie C. Wettengel
N 33-13 W.
N 71-41 W.
705.90'
N 4-39 E.
1186.02'
Pittsburgh Coal Co.
Mined Out
Mined Out
Stripping
Stripping
Left Butts
Faces
No. 2 Bt. Rt.
No. 1 Butt Rt.
Pit Mouth
15' Crop Line
Approximate
Line
Workings - Survey of 12-16-36 - Shown Thus
Workings Extended by the Malinosky Coal Co -
Survey Date "E" 6-29-41 Shown Thus
" " "F" 8-6-43 " "
" " "G" 3-6-44 " "
" " "H" 6-26-44 " "
" " I 8-29-44 " "
Plan Made For
The Sunnyhill Coal Co.
Showing Coal Leased To
The Malinosky Coal Co.
Scale:- 1" = 100'
Aug., 1944
Guy A. Reed, No. 3033
Pittsburgh, Pa.