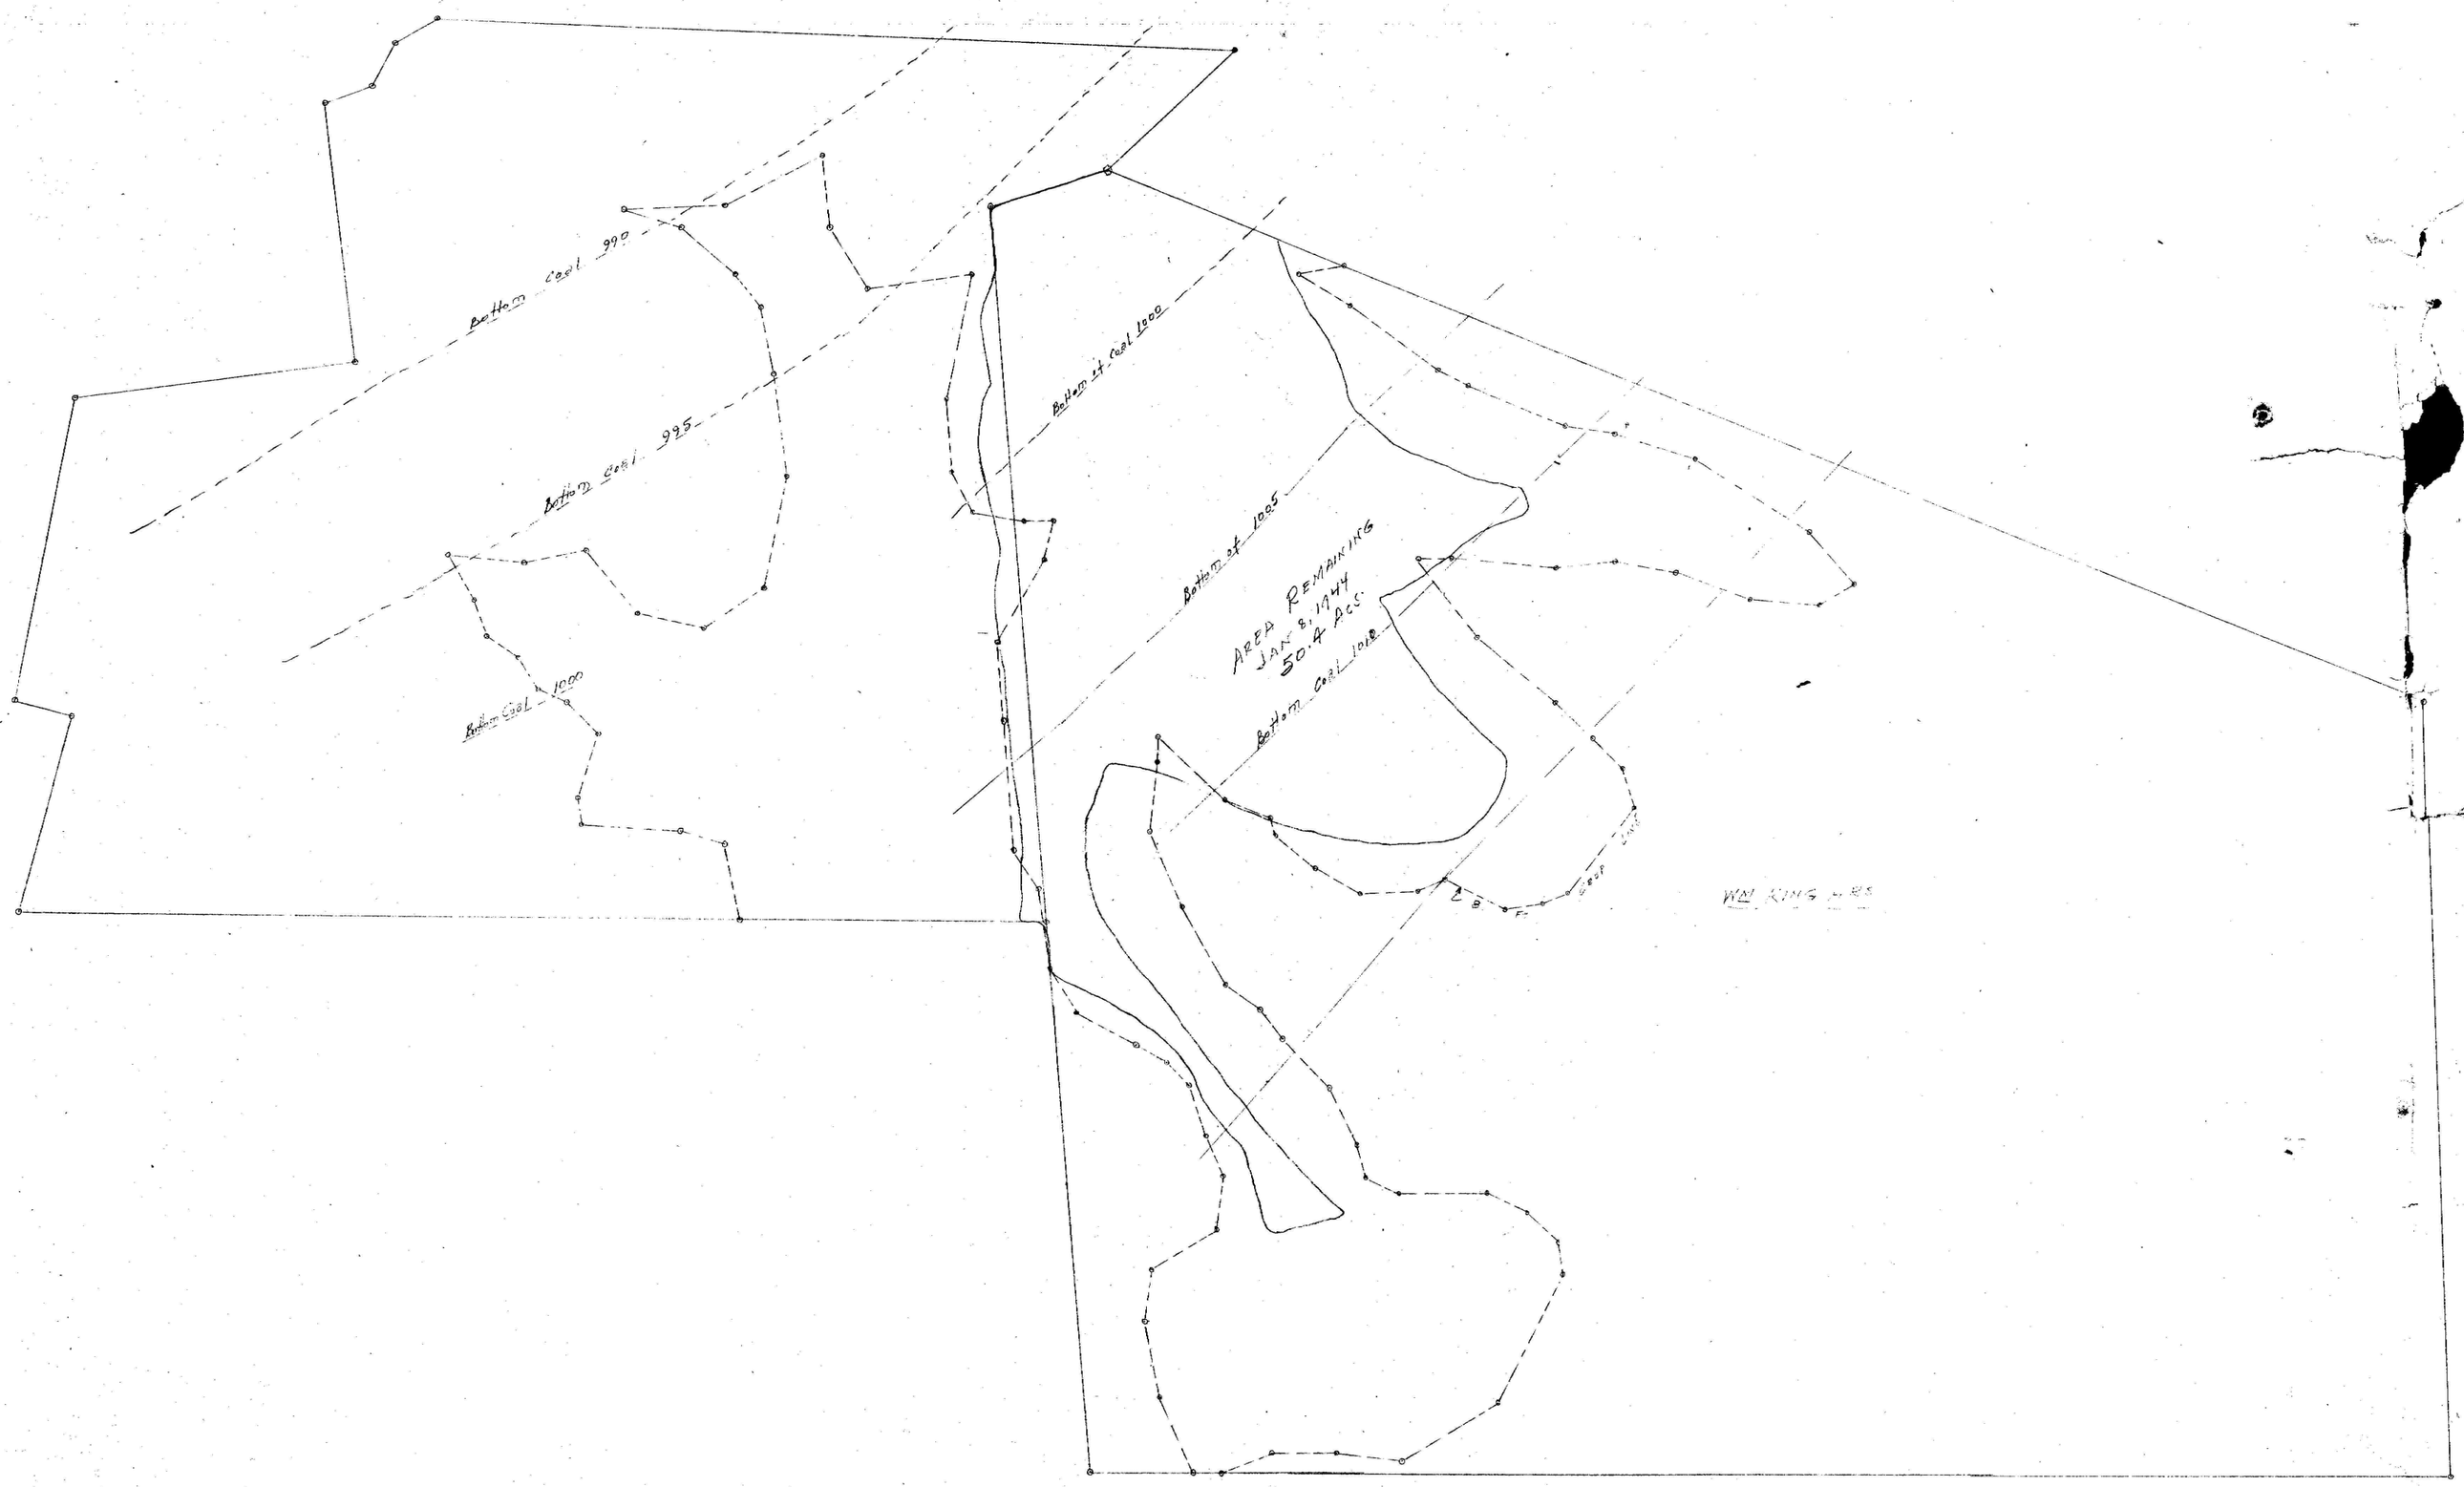

SUNNYHILL COAL CO.
KING FARM
Scale 1" = 200'
Guy H. Reed
Pittsburgh, Pa.