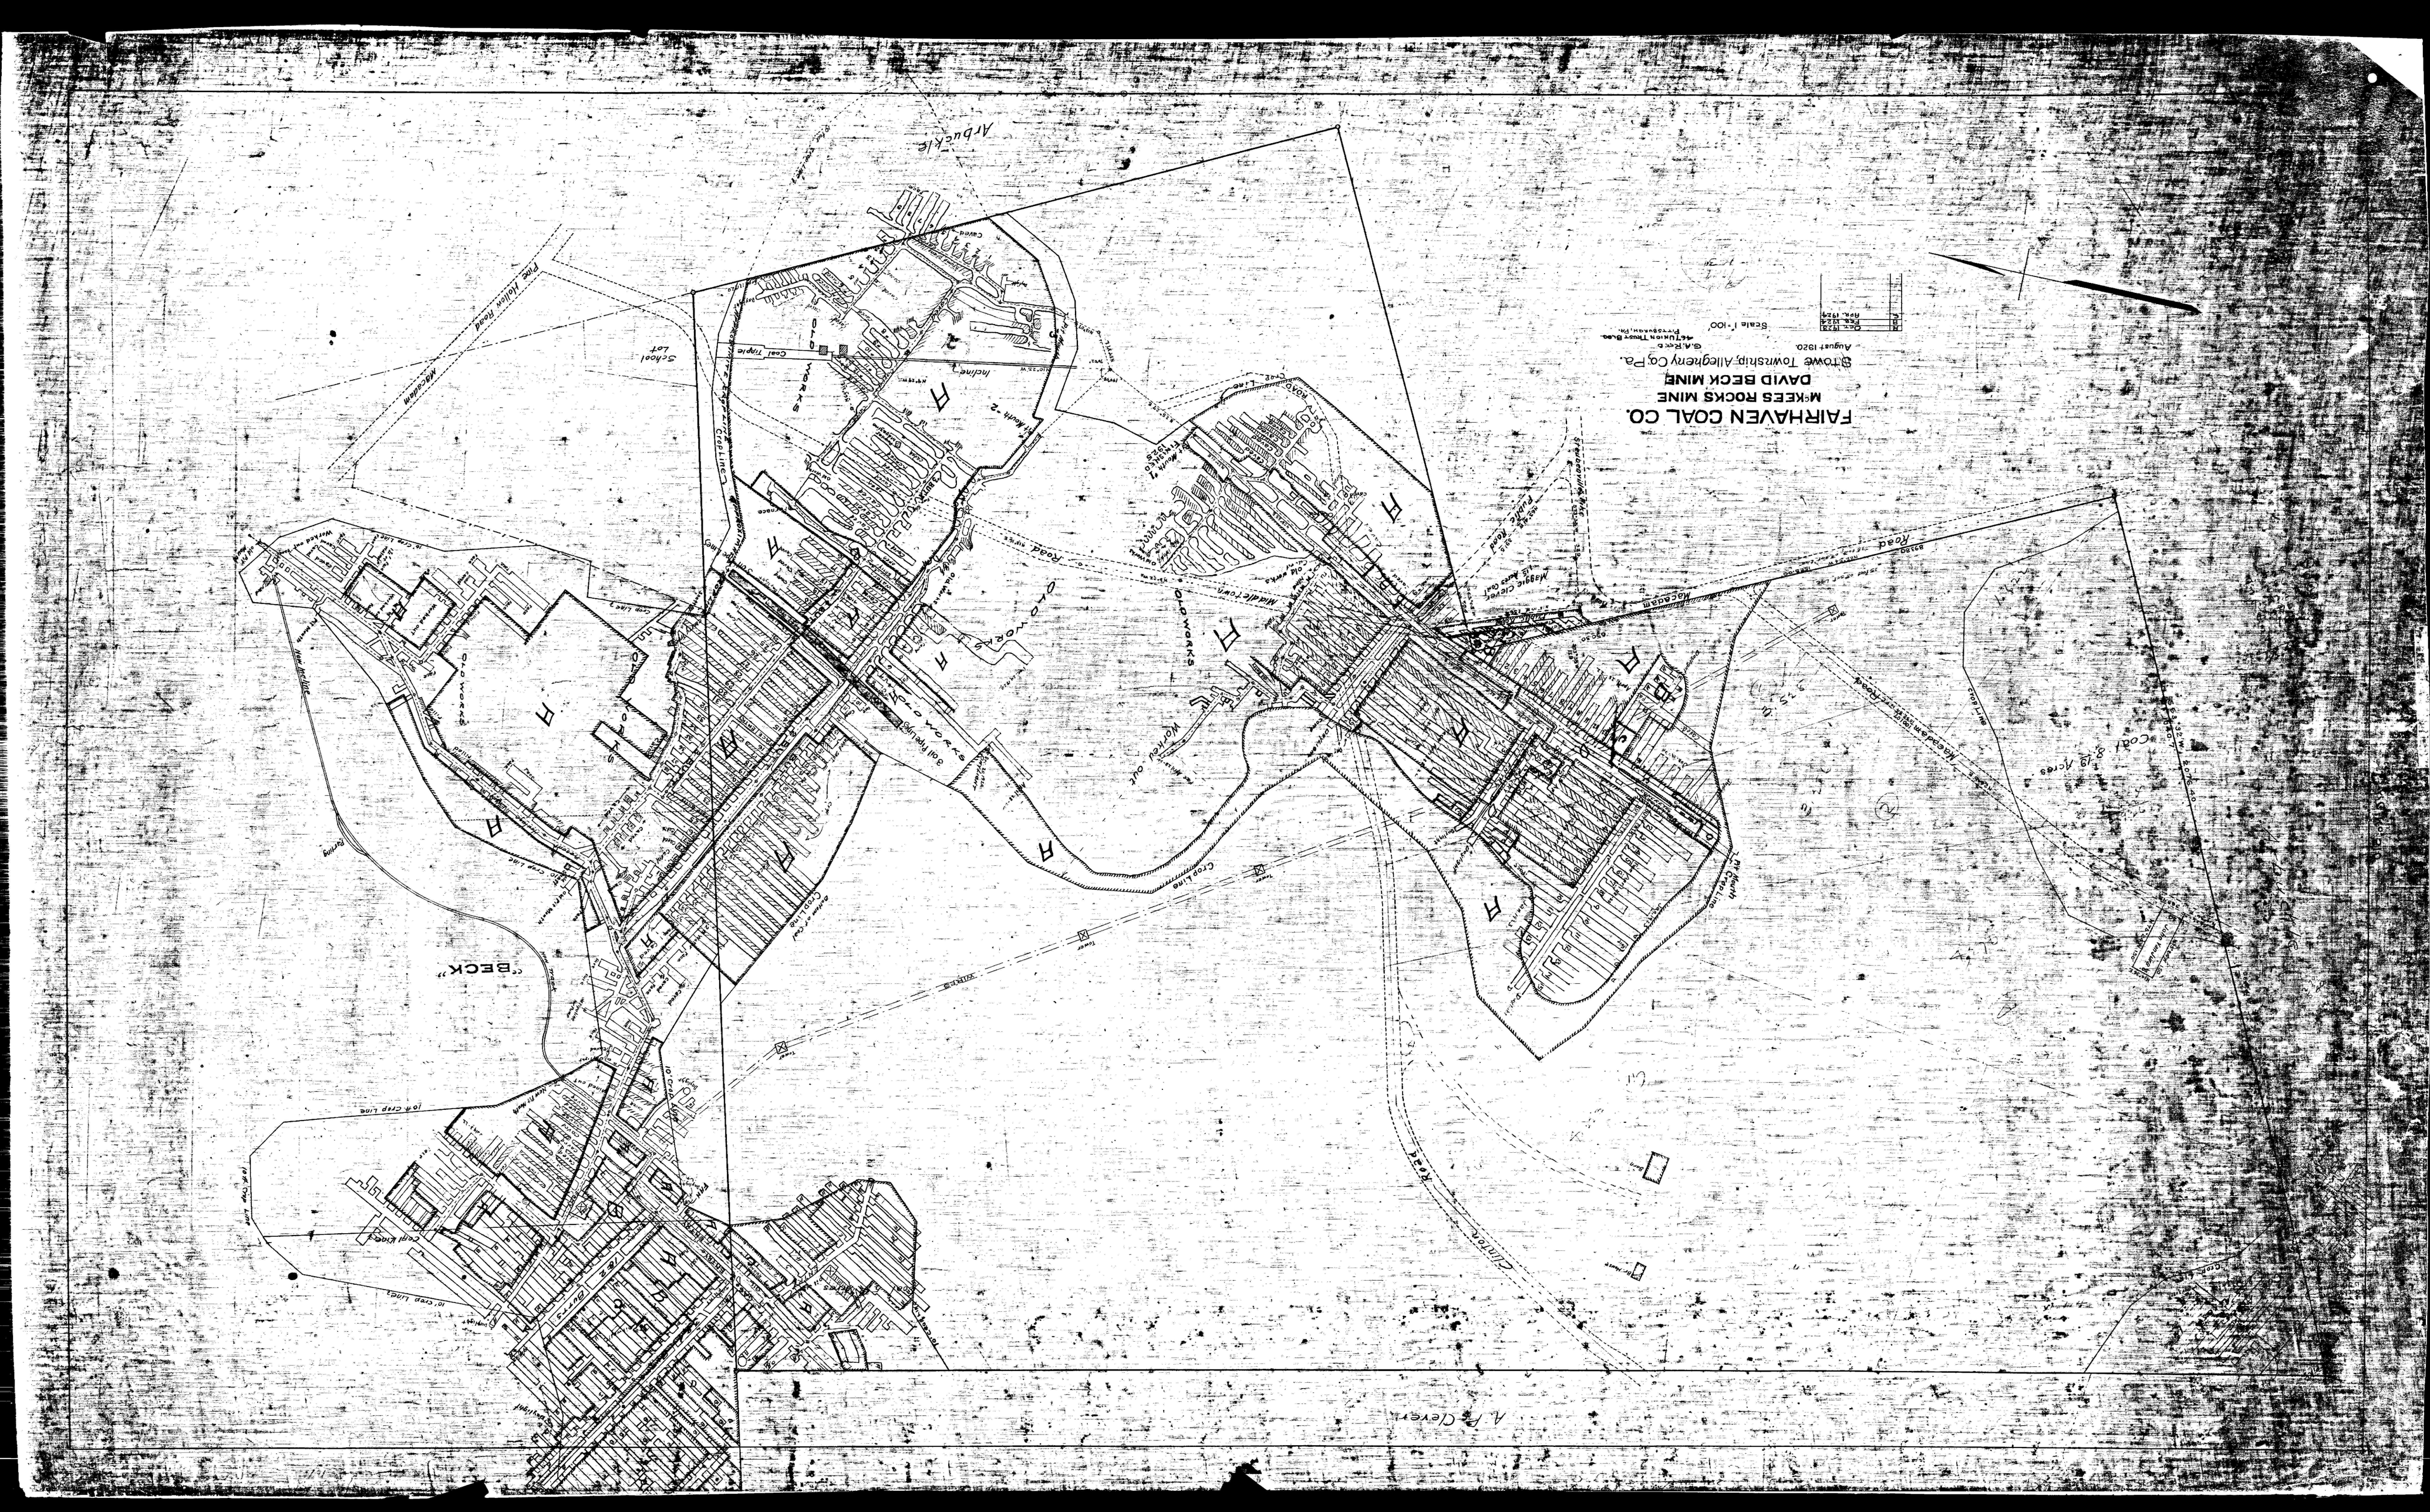
FAIRHAVEN COAL CO.
McKEES ROCKS MINE
DAVID BECK MINE
Stowe Township, Allegheny Co., Pa.
August 1920
G.A.R.c.b
46 Union Trust Bldg.
Pittsburgh, Pa.
Scale 1"=100'
Dec. 1923
Feb. 1924
Mar. 1924
Coal 8.19 Acres
Coal Tipple
Incline
Mouth 2
Mouth 1
Coke Ovens
Old Works
Old Coke Ovens
Coke Ovens
Coke Ovens Tipple
Coke Ovens Cooling Tower
