


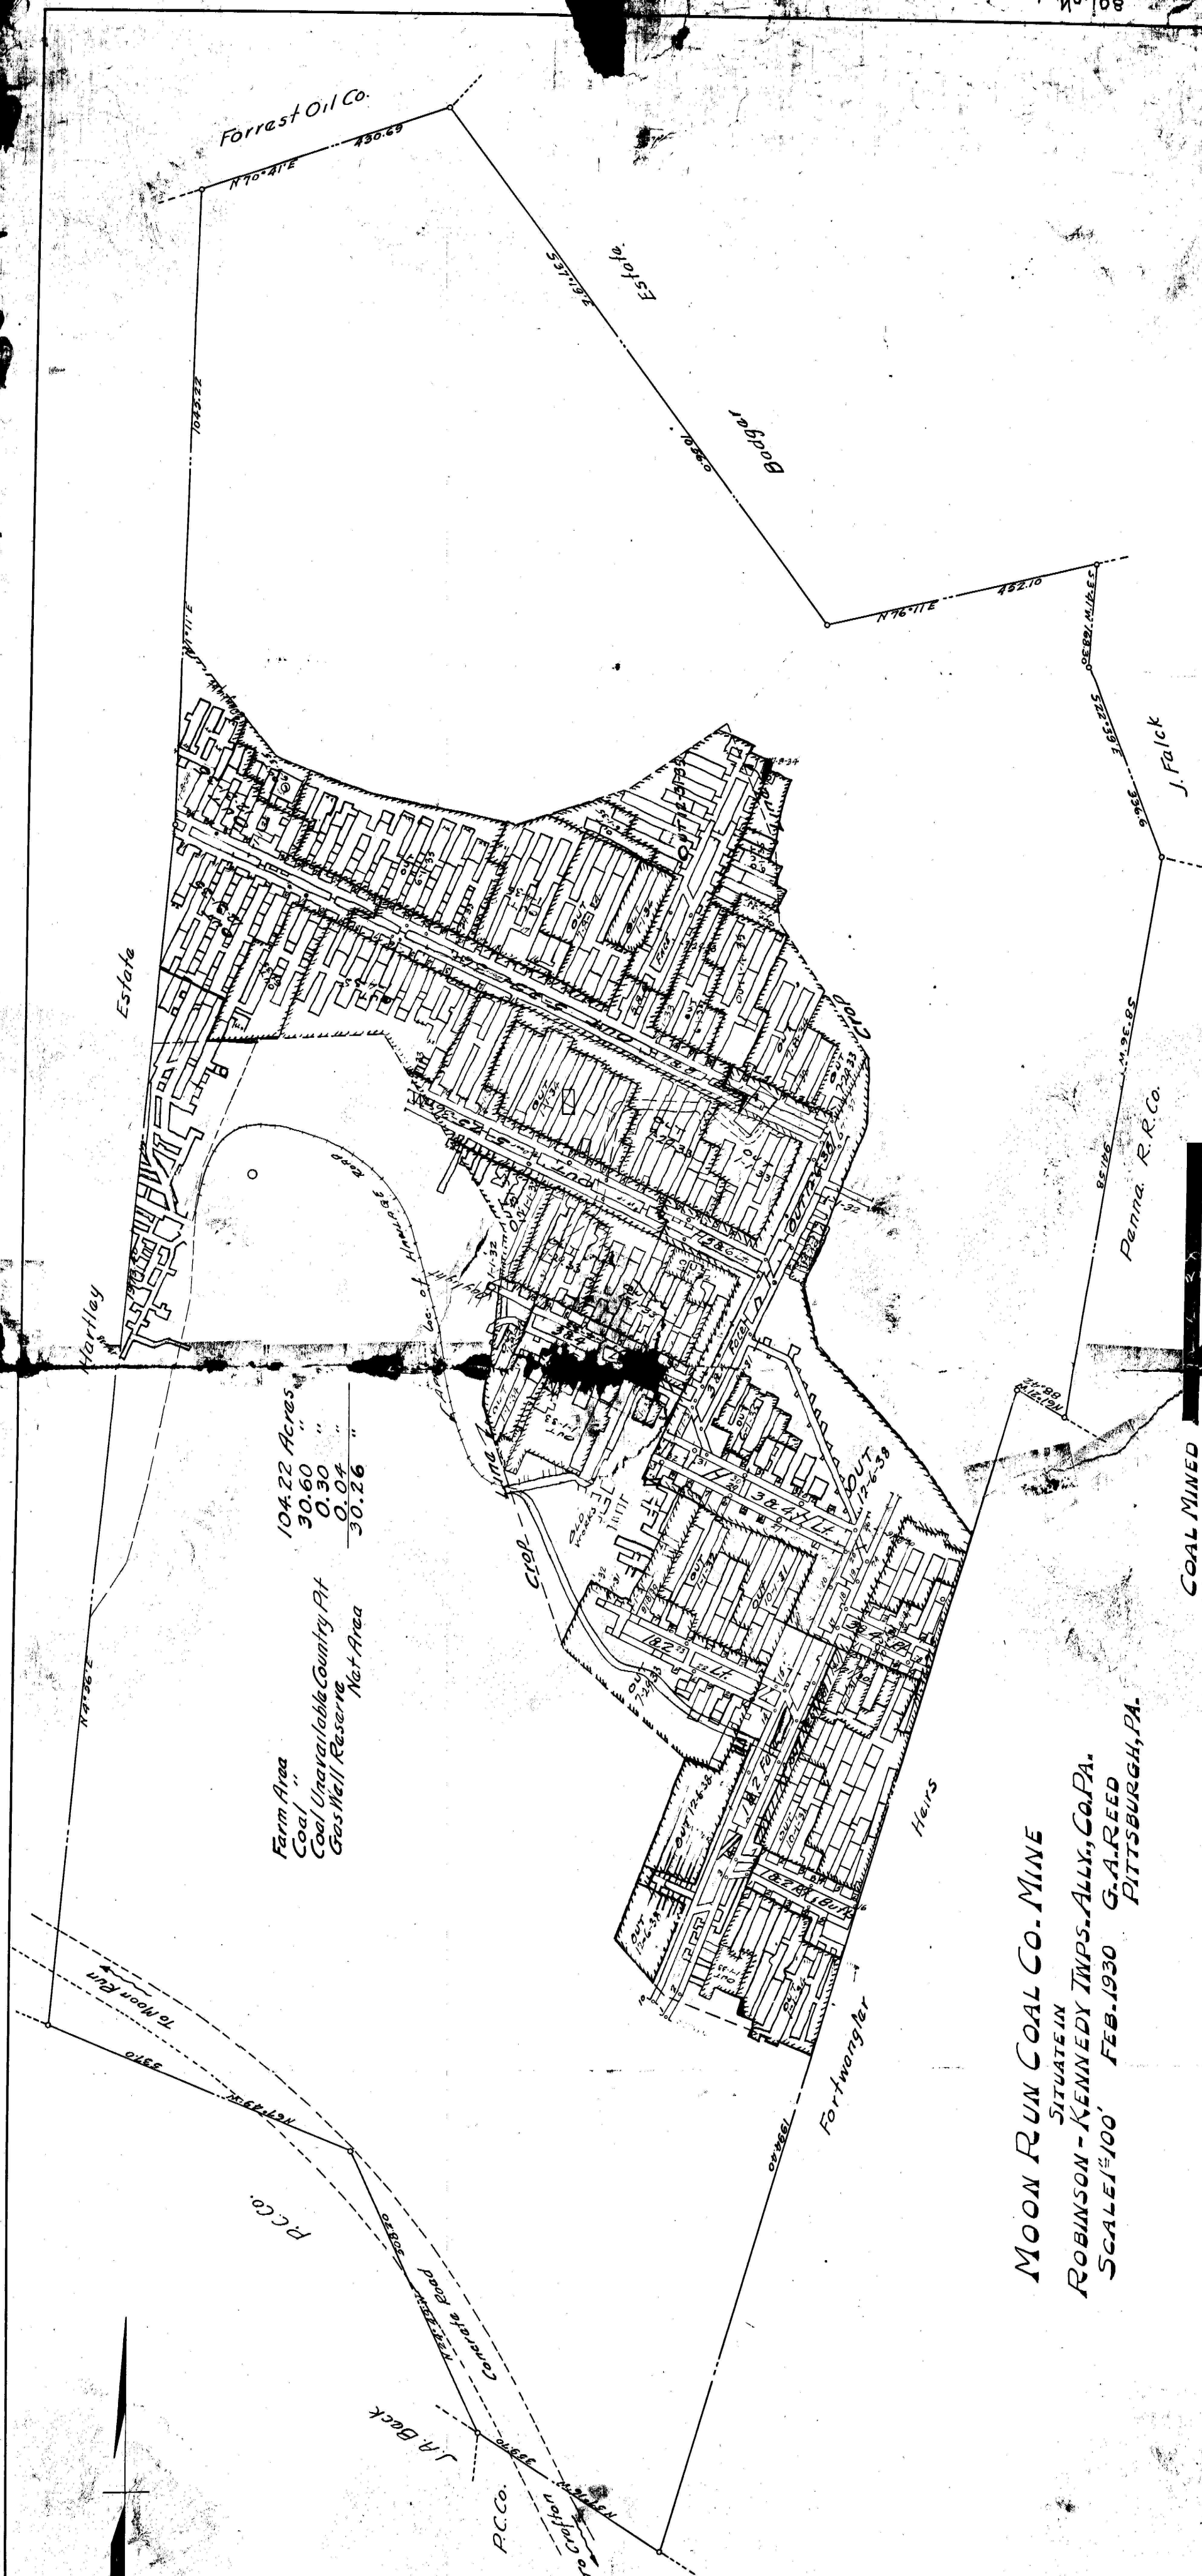

MOON RUN COAL CO. MINE
SITUATE IN
ROBINSON - KENNEDY TRPS. ALLY, Co. PA.
SCALE 1/4" = 100' FEB. 1930 G.A. REED
PITTSBURGH, PA.