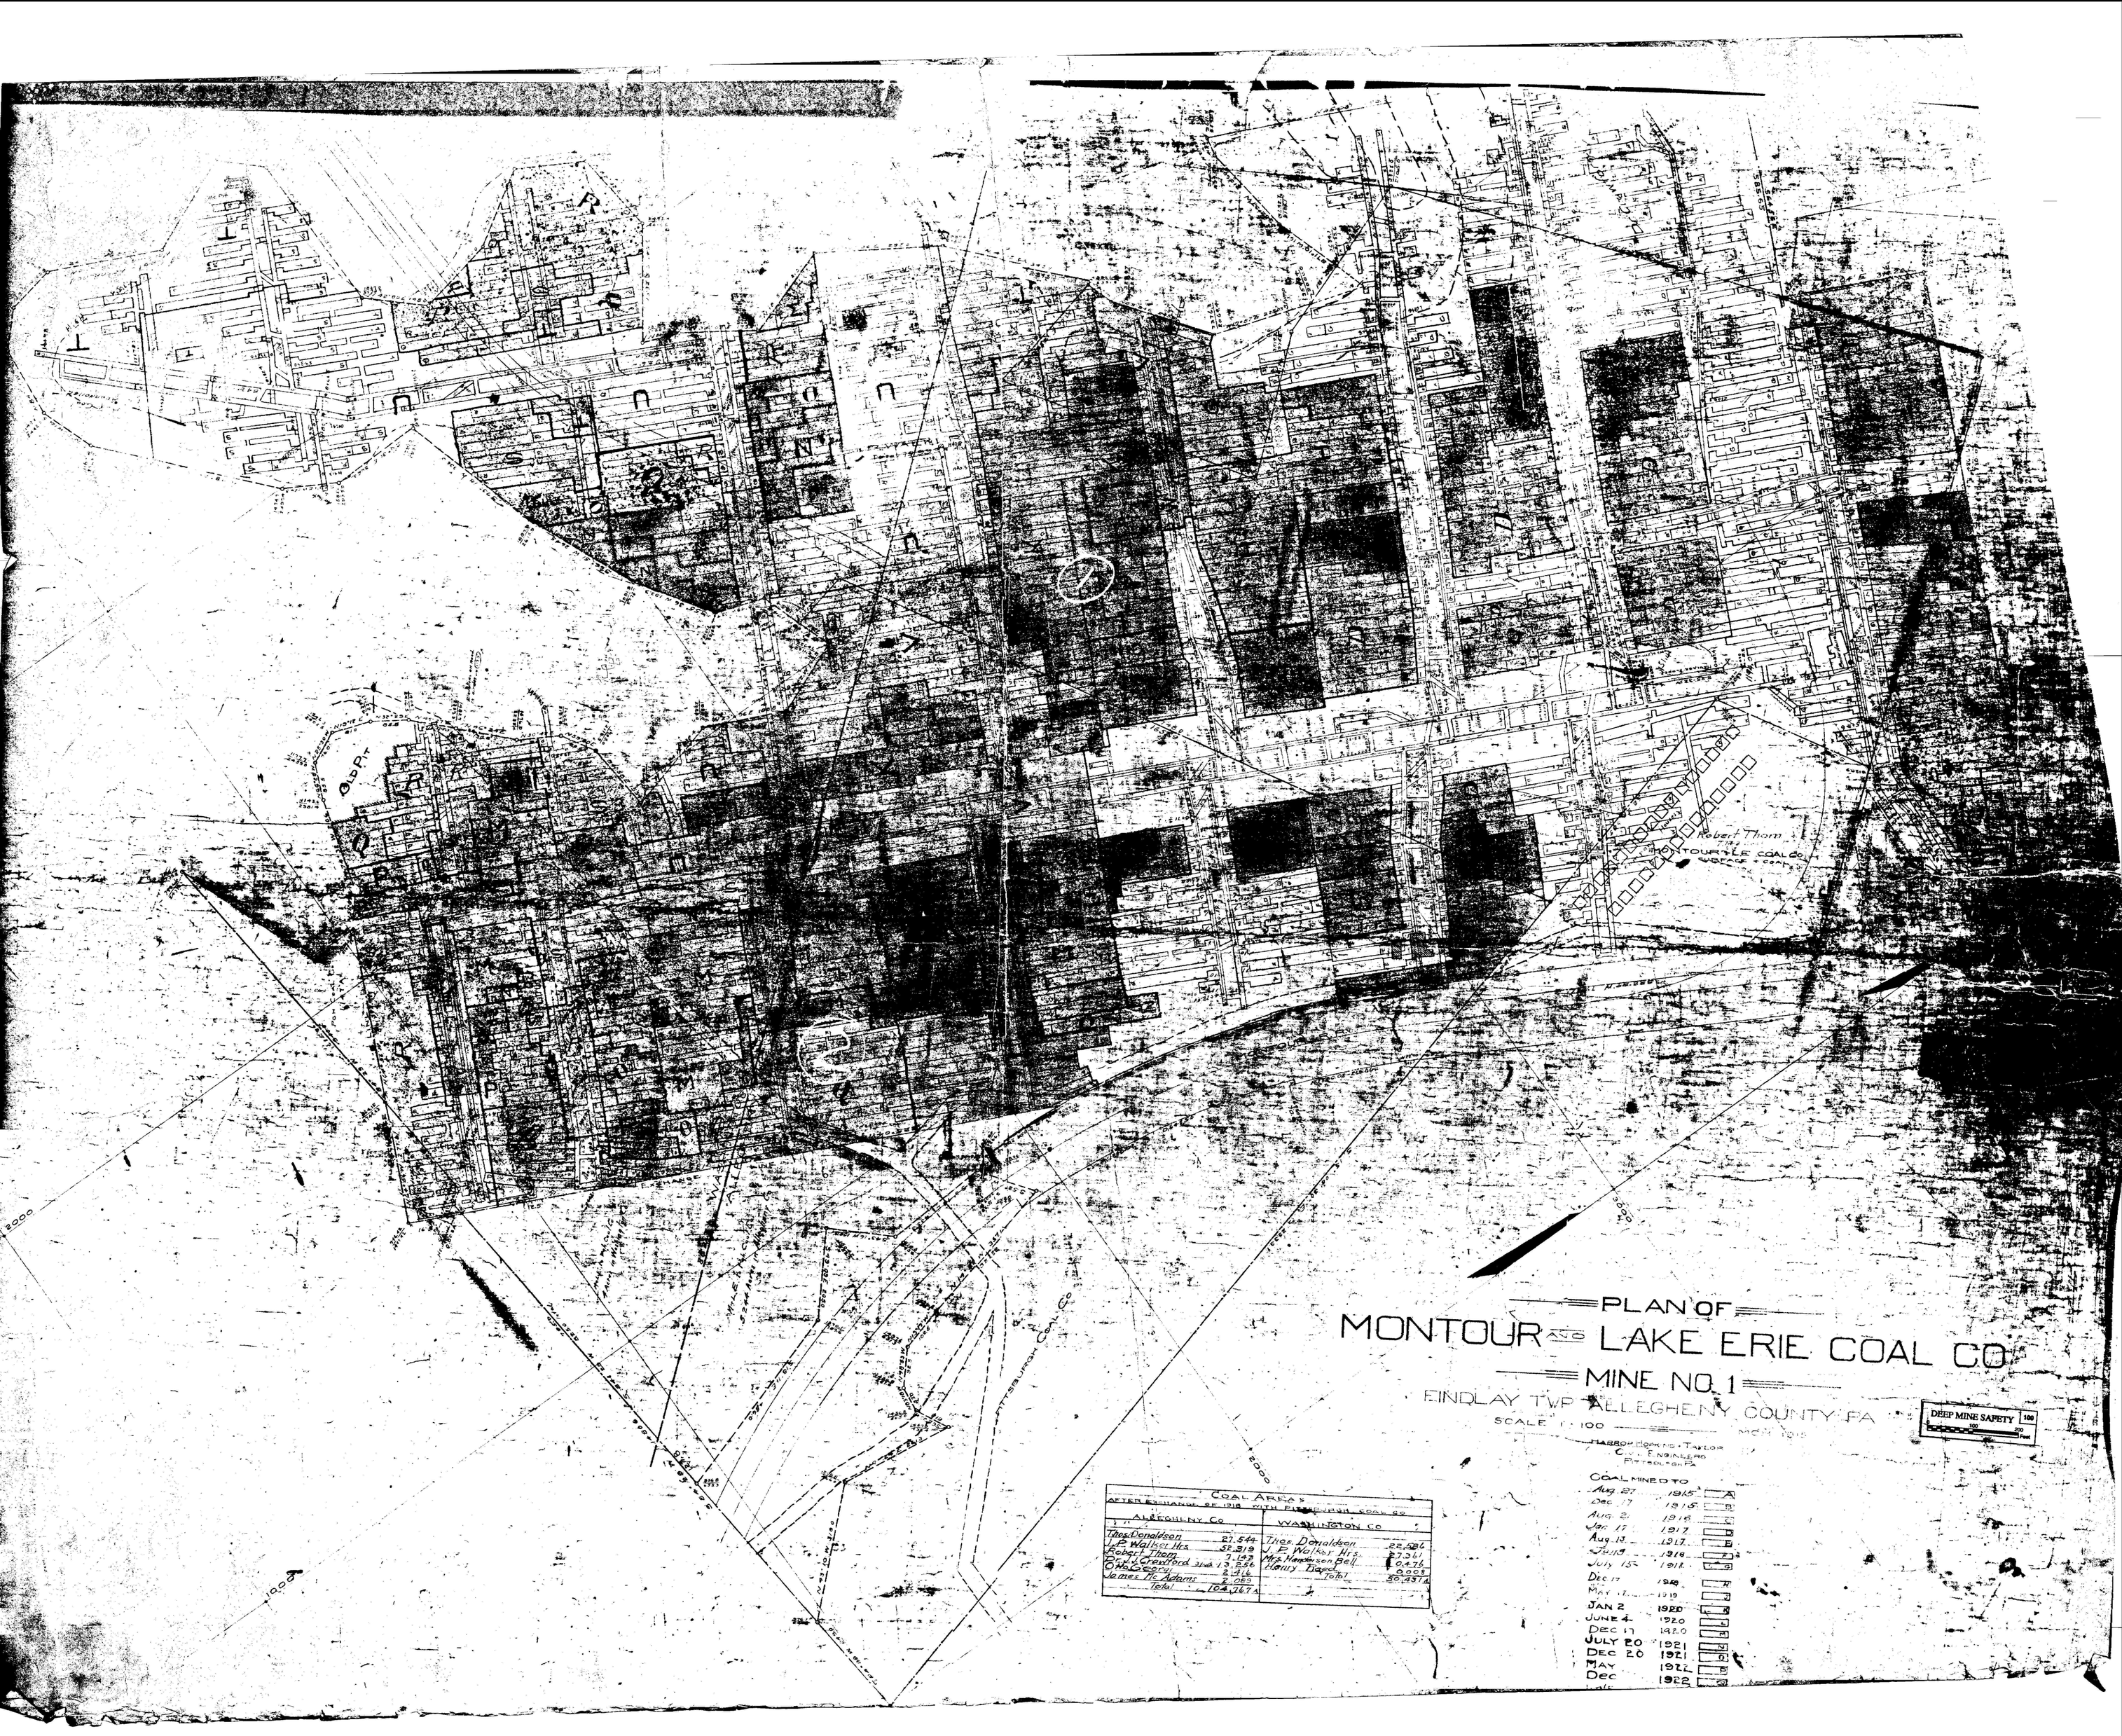
PLAN OF
MONTOUR AND LAKE ERIE COAL CO.
MINE NO. 1
FINDLAY TWP. ALLEGHENY COUNTY PA
SCALE 1" = 100'
DEEP MINE SAFETY 100
HARROP HOPKINS & TAYLOR
C. E. ENGINEERS
PITTSBURGH PA
COAL MINED TO
Aug 27 1915 A
Dec 17 1915 B
Aug 2 1916 C
Jan 17 1917 D
Aug 13 1917 E
July 9 1918 F
July 15 1918 G
Dec 17 1918 H
May 17 1919 I
JAN 2 1920 J
JUNE 4 1920 K
DEC 17 1920 L
JULY 20 1921 M
DEC 20 1921 N
MAY 1922 O
Dec 1922 P
COAL AREAS
AFTER ISSUANCE OF 1918 WITH ELIMINATION COAL CO
ALLEGHENY CO
Thos Donaldson 21.544
J.P. Walker Hrs. 32.319
Robert Thom 7.183
Chas. Crawford 3rd 13.256
O. McCarry 2.416
James H. Adams 2.069
Total 104.787
WASHINGTON CO
Thos. Donaldson 22.526
J. P. Walker Hrs. 27.261
Mrs. Hannah Bell 0.476
Henry Bland 0.003
Total 50.237
Robert Thom
MONTOUR & LE COAL CO
PITTSBURGH COAL CO
2000
1000