


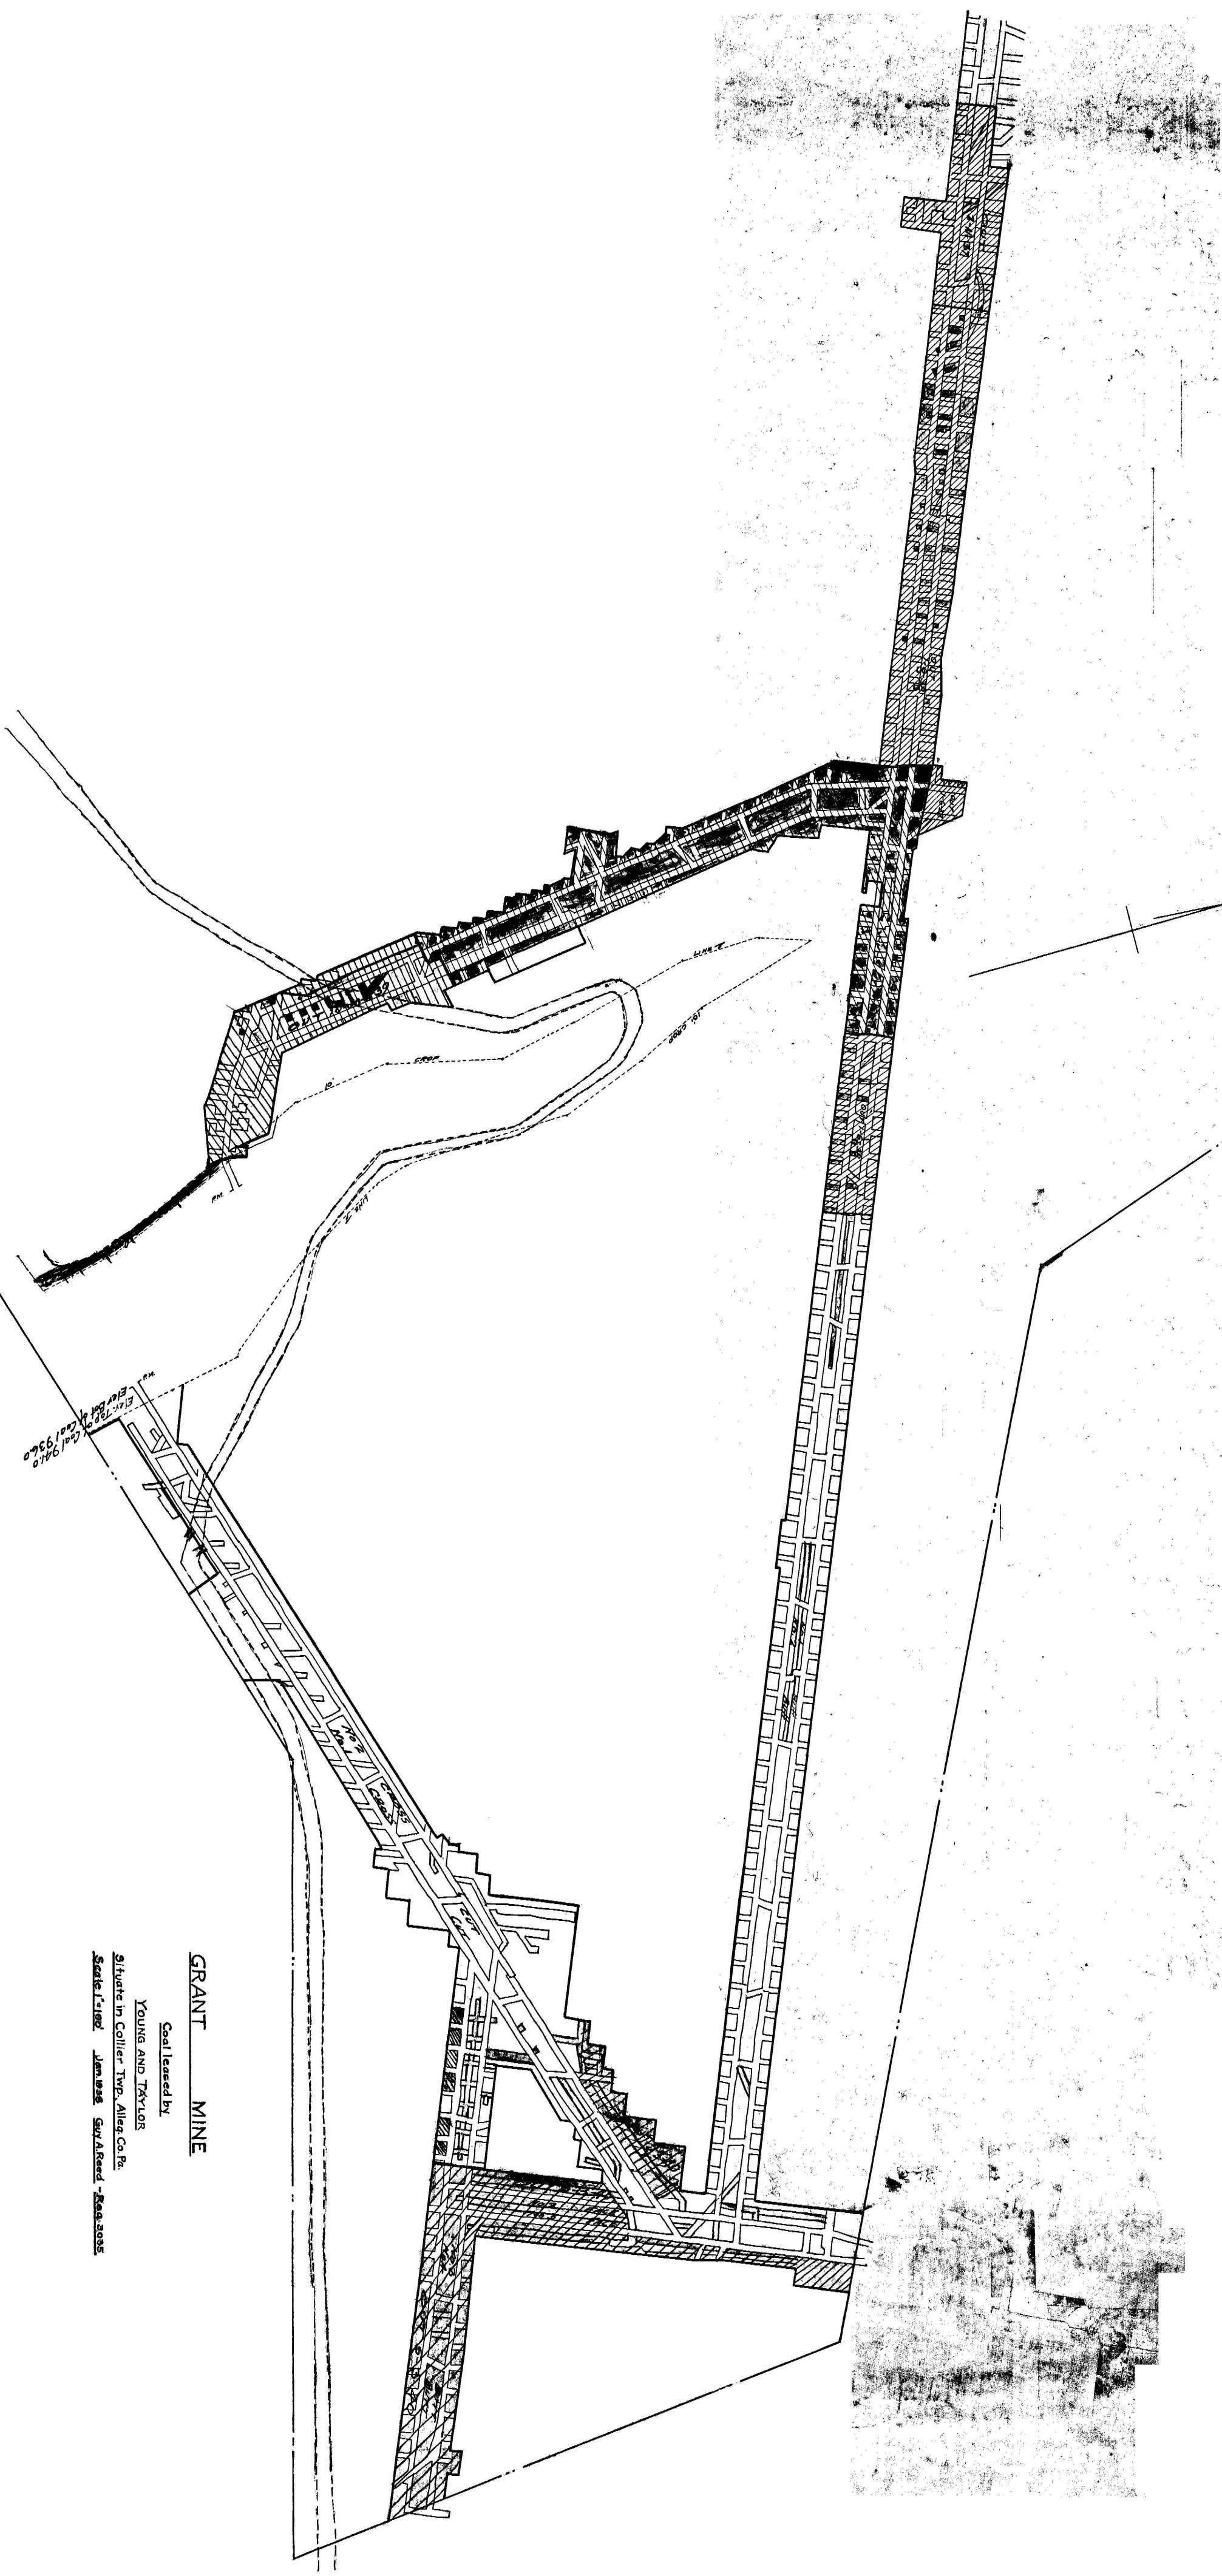

GRANT MINE

Coal leased by
YOUNG AND TAYLOR
Situate in Collier Twp. Alleg Co. Pa.
Scale 1"=100' Jan. 1898 Sur A. Reed - Reg. 3035