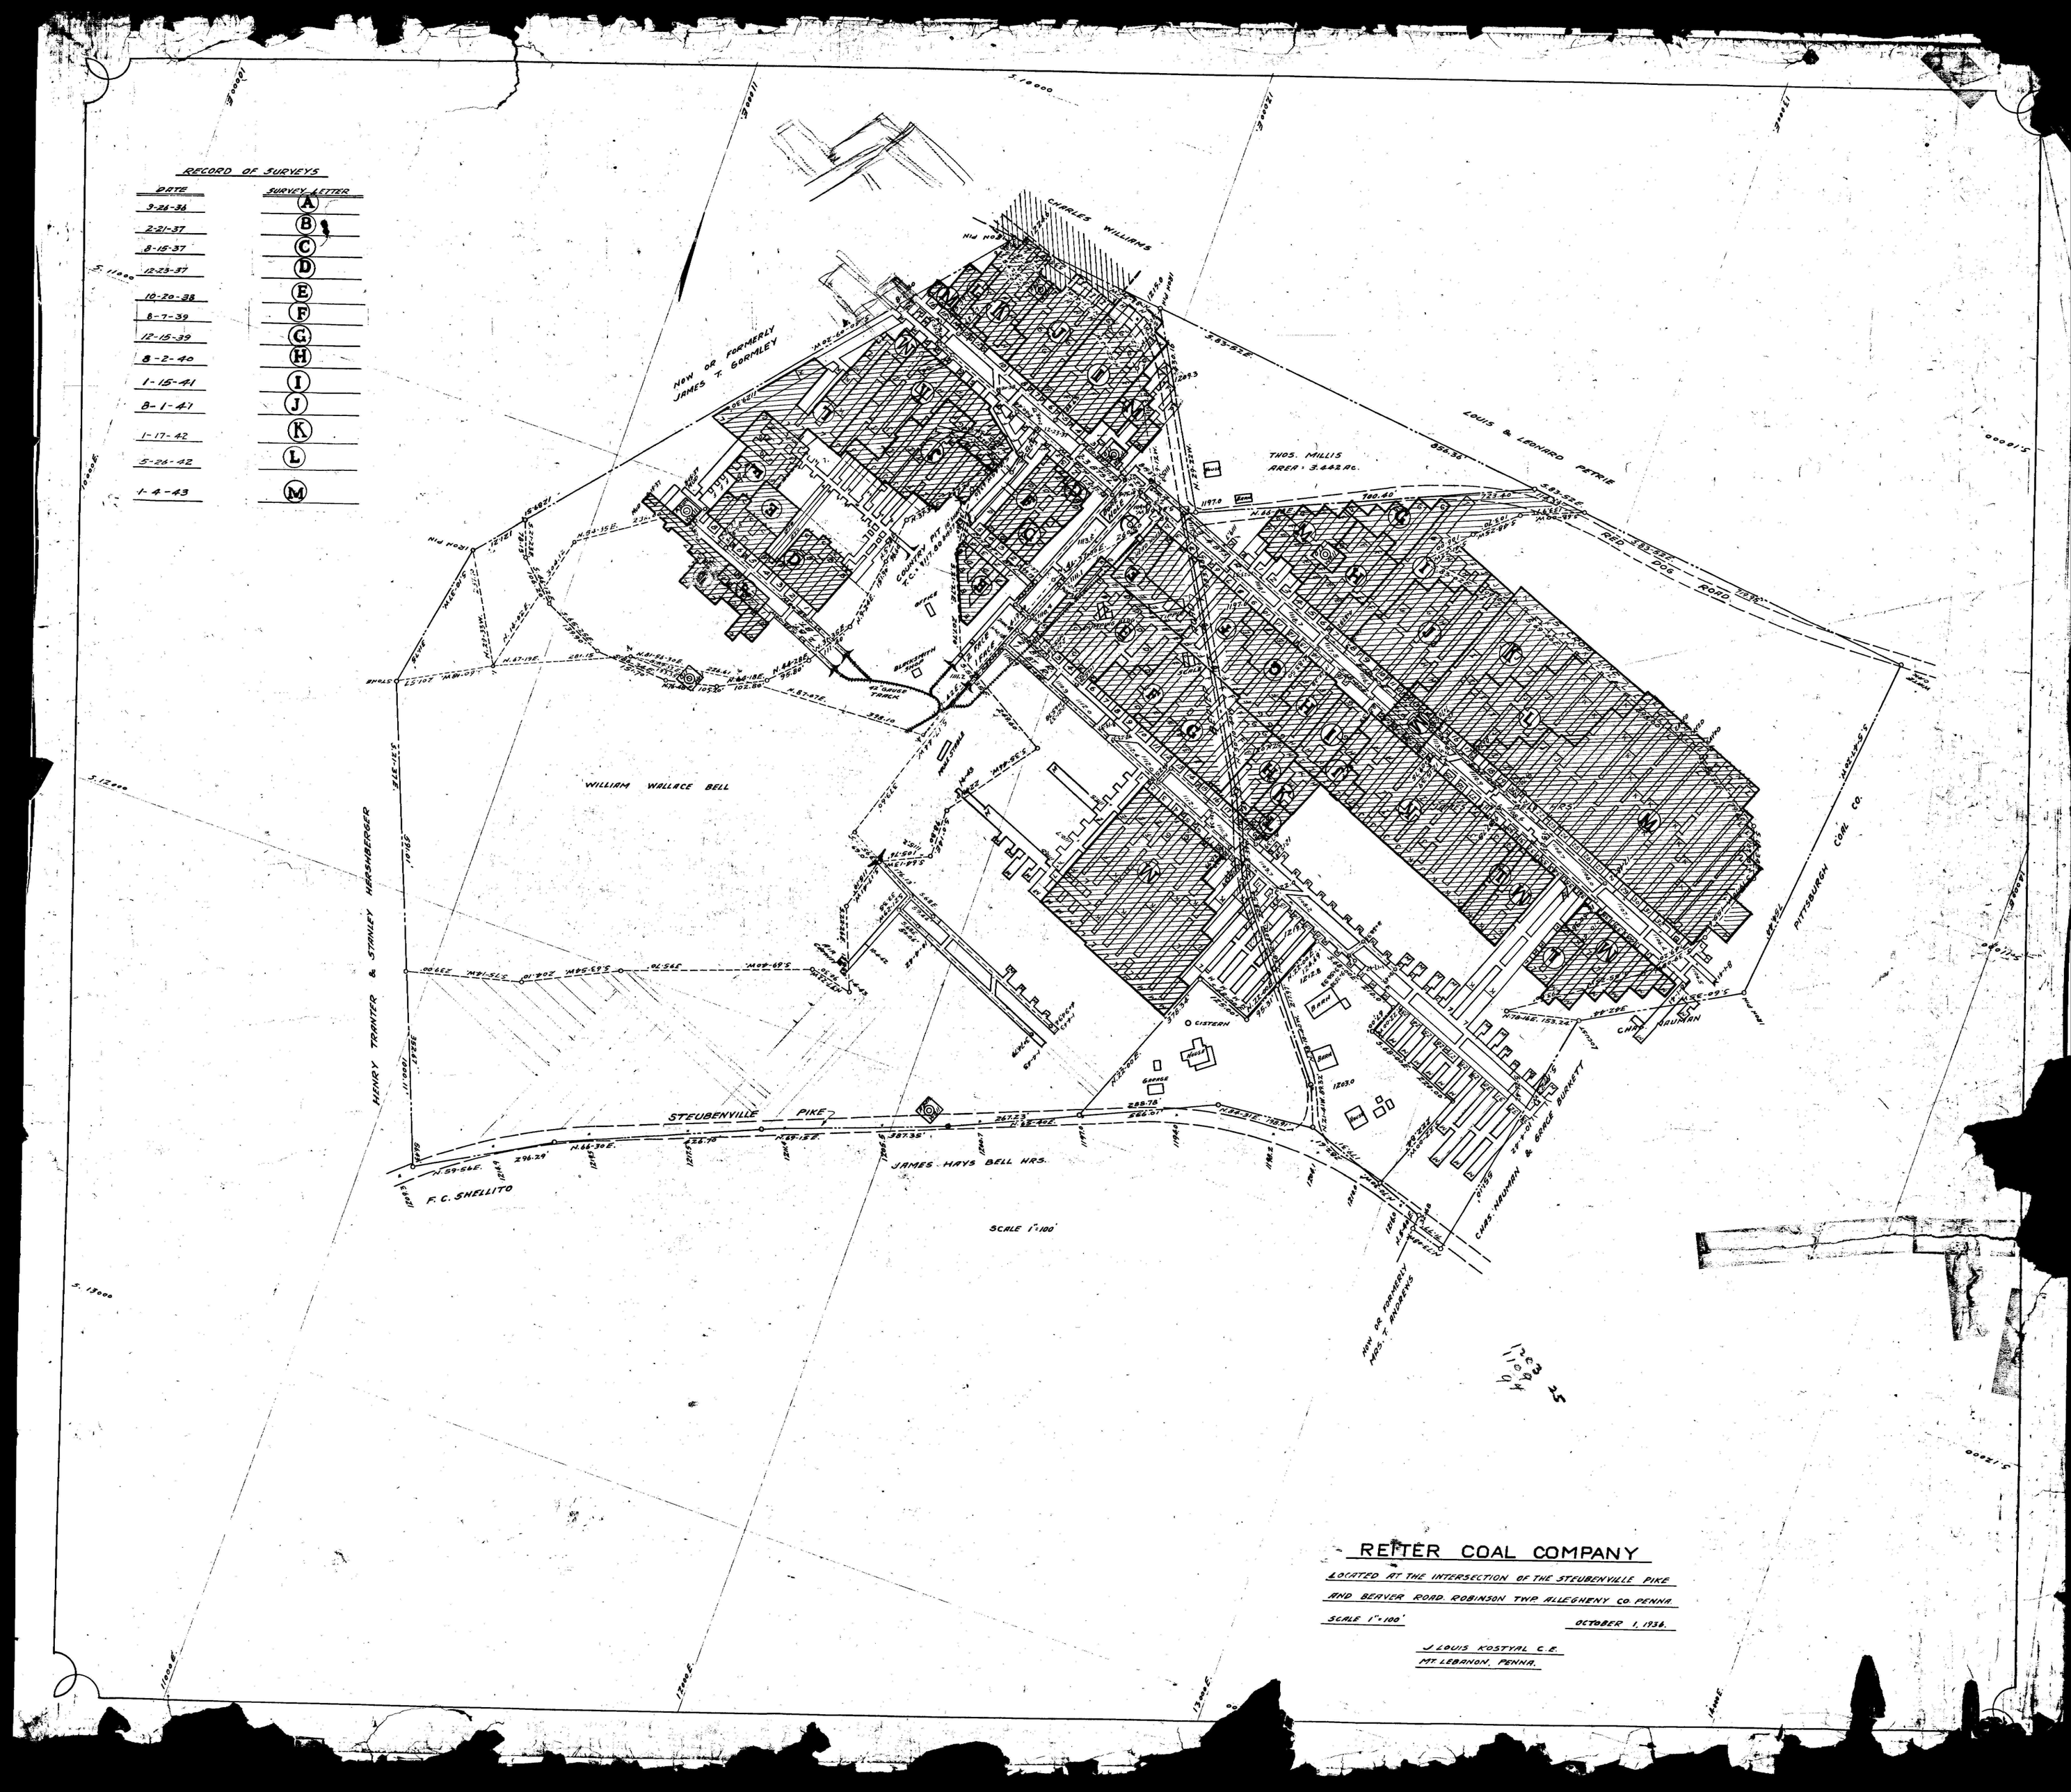

RETTER COAL COMPANY

LOCATED AT THE INTERSECTION OF THE STEUBENVILLE PIKE AND BEAVER ROAD, ROBINSON TWP. ALLEGHENY CO. PENNA.

SCALE 1"=100'

OCTOBER 1, 1936.

J. LOUIS KOSTYAL C.E.
MT. LEBANON, PENNA.