


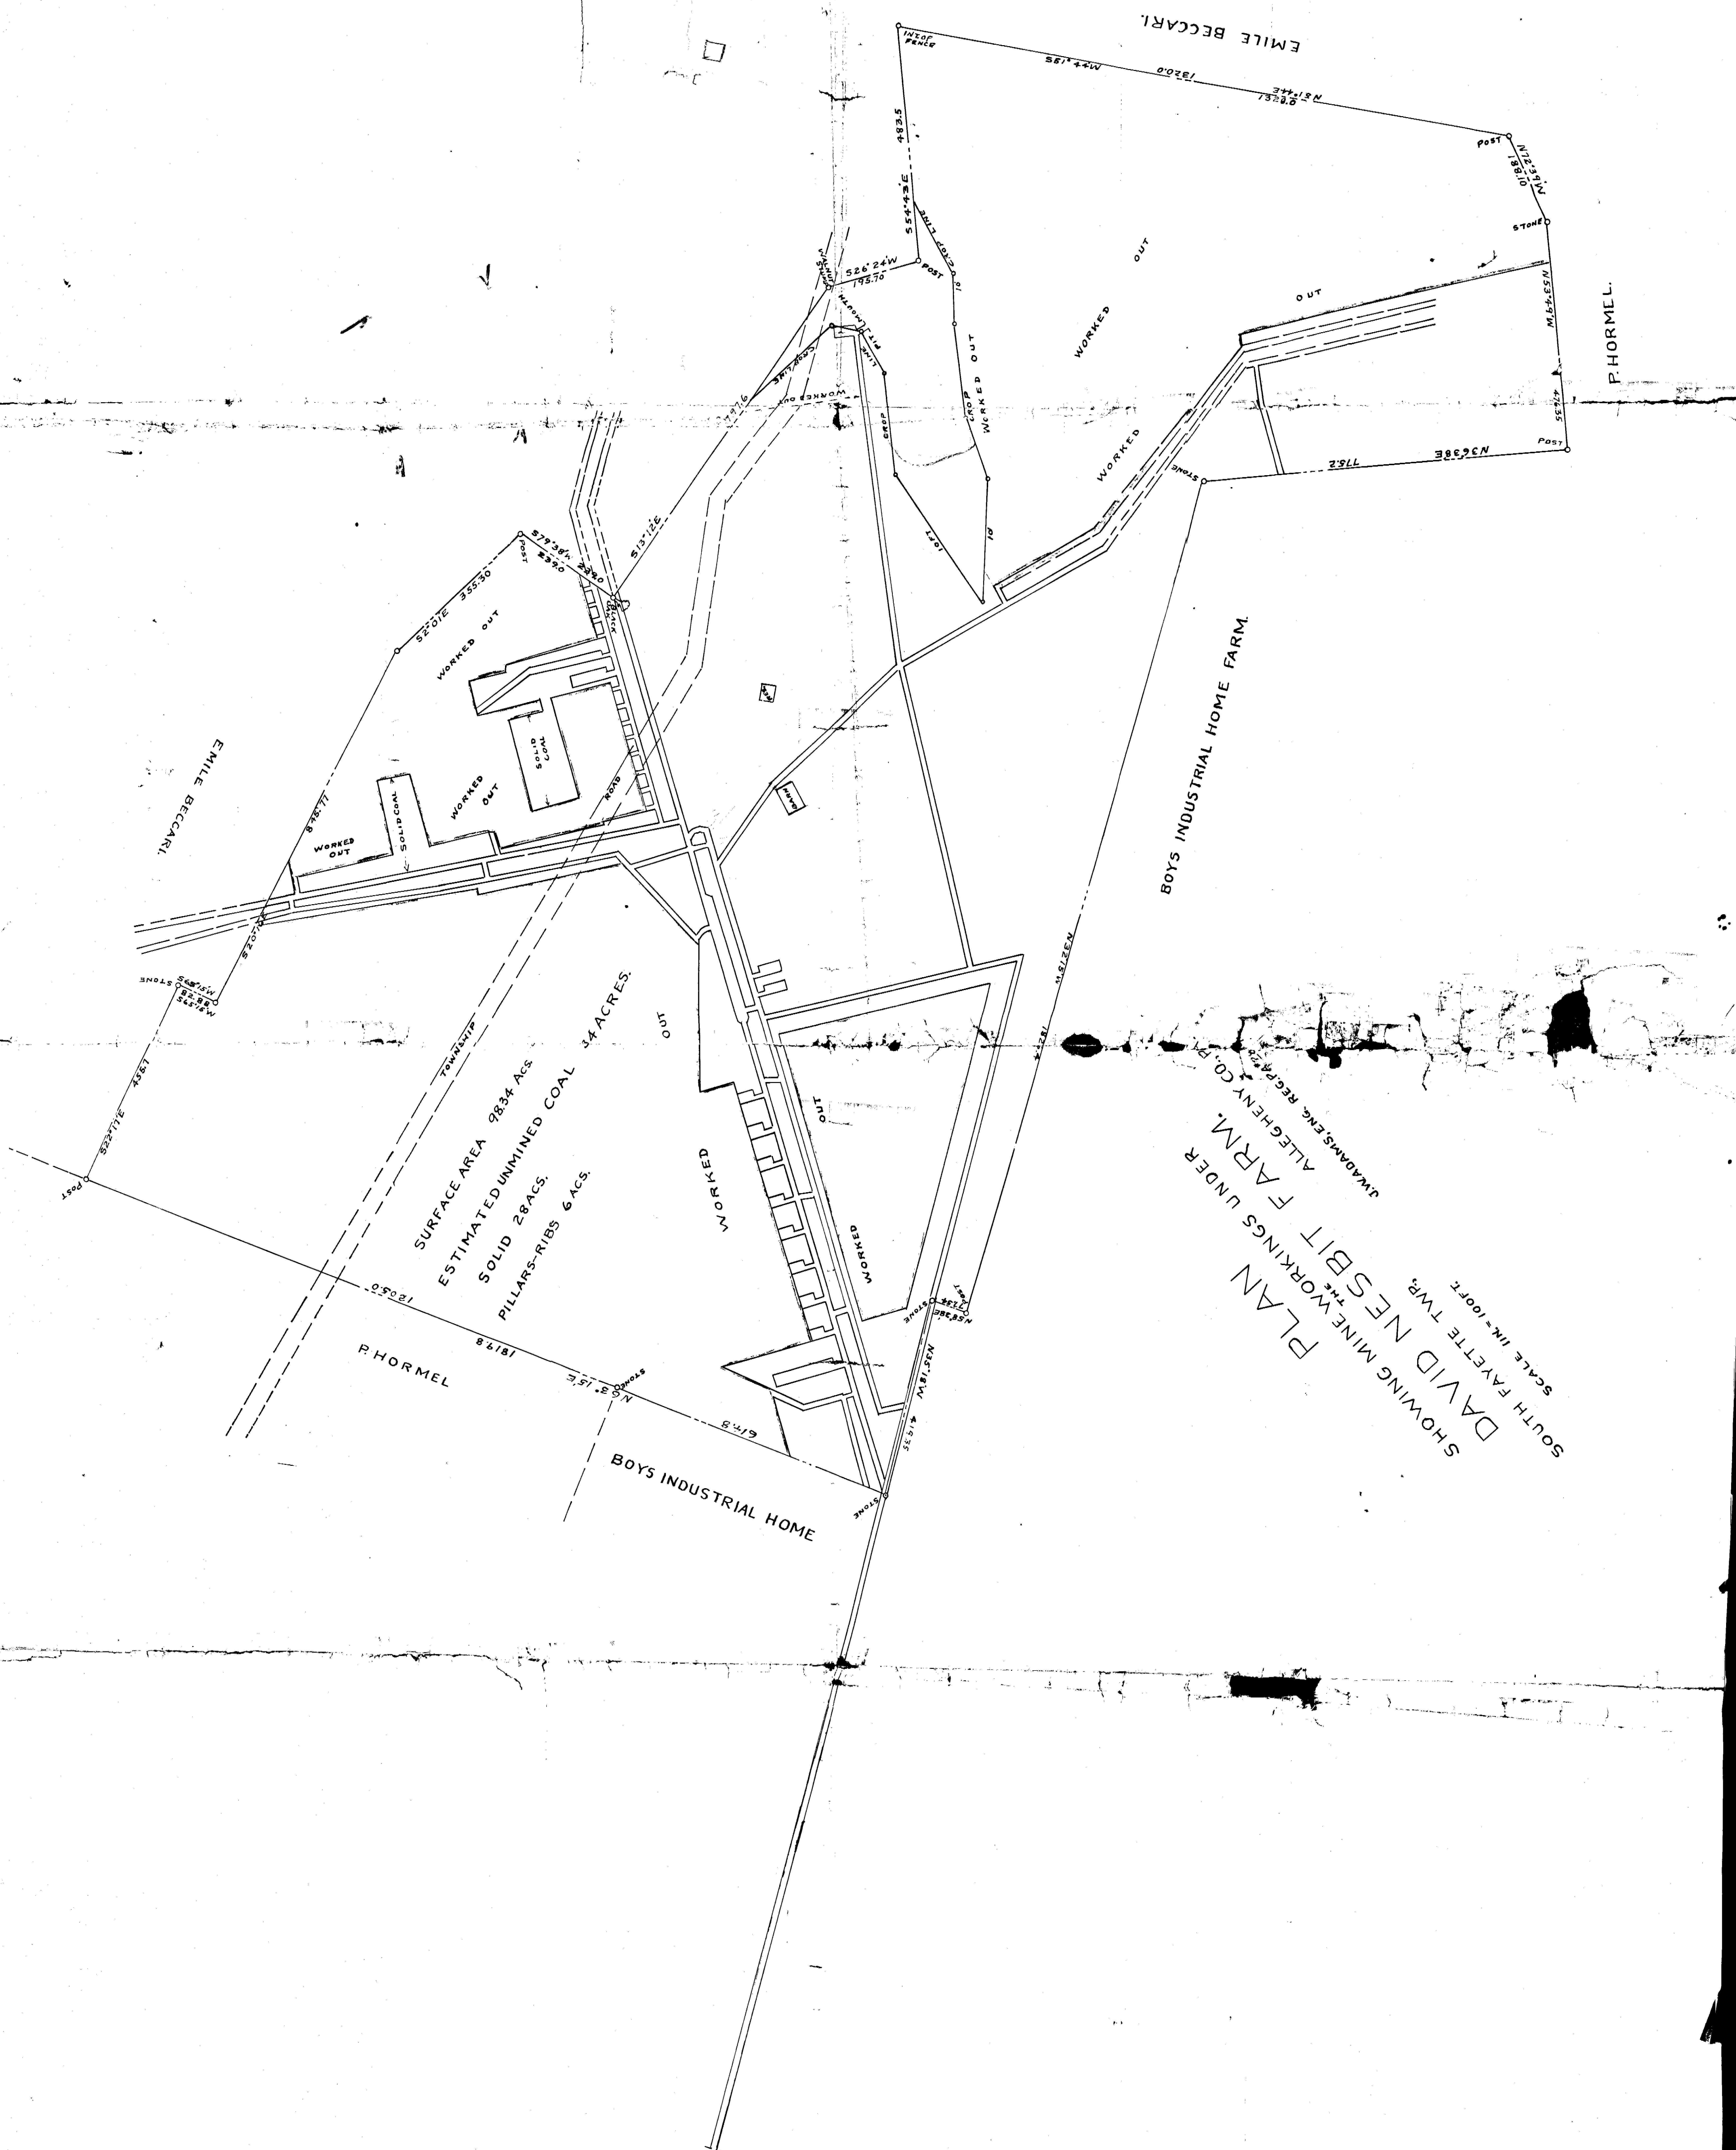

SHOWING MINE WORKINGS UNDER
DAVID NESBITT FARM.
ALLEGHENY CO. PA.
SOUTH FAYETTE TWP.
SCALE 1 IN = 100 FT.