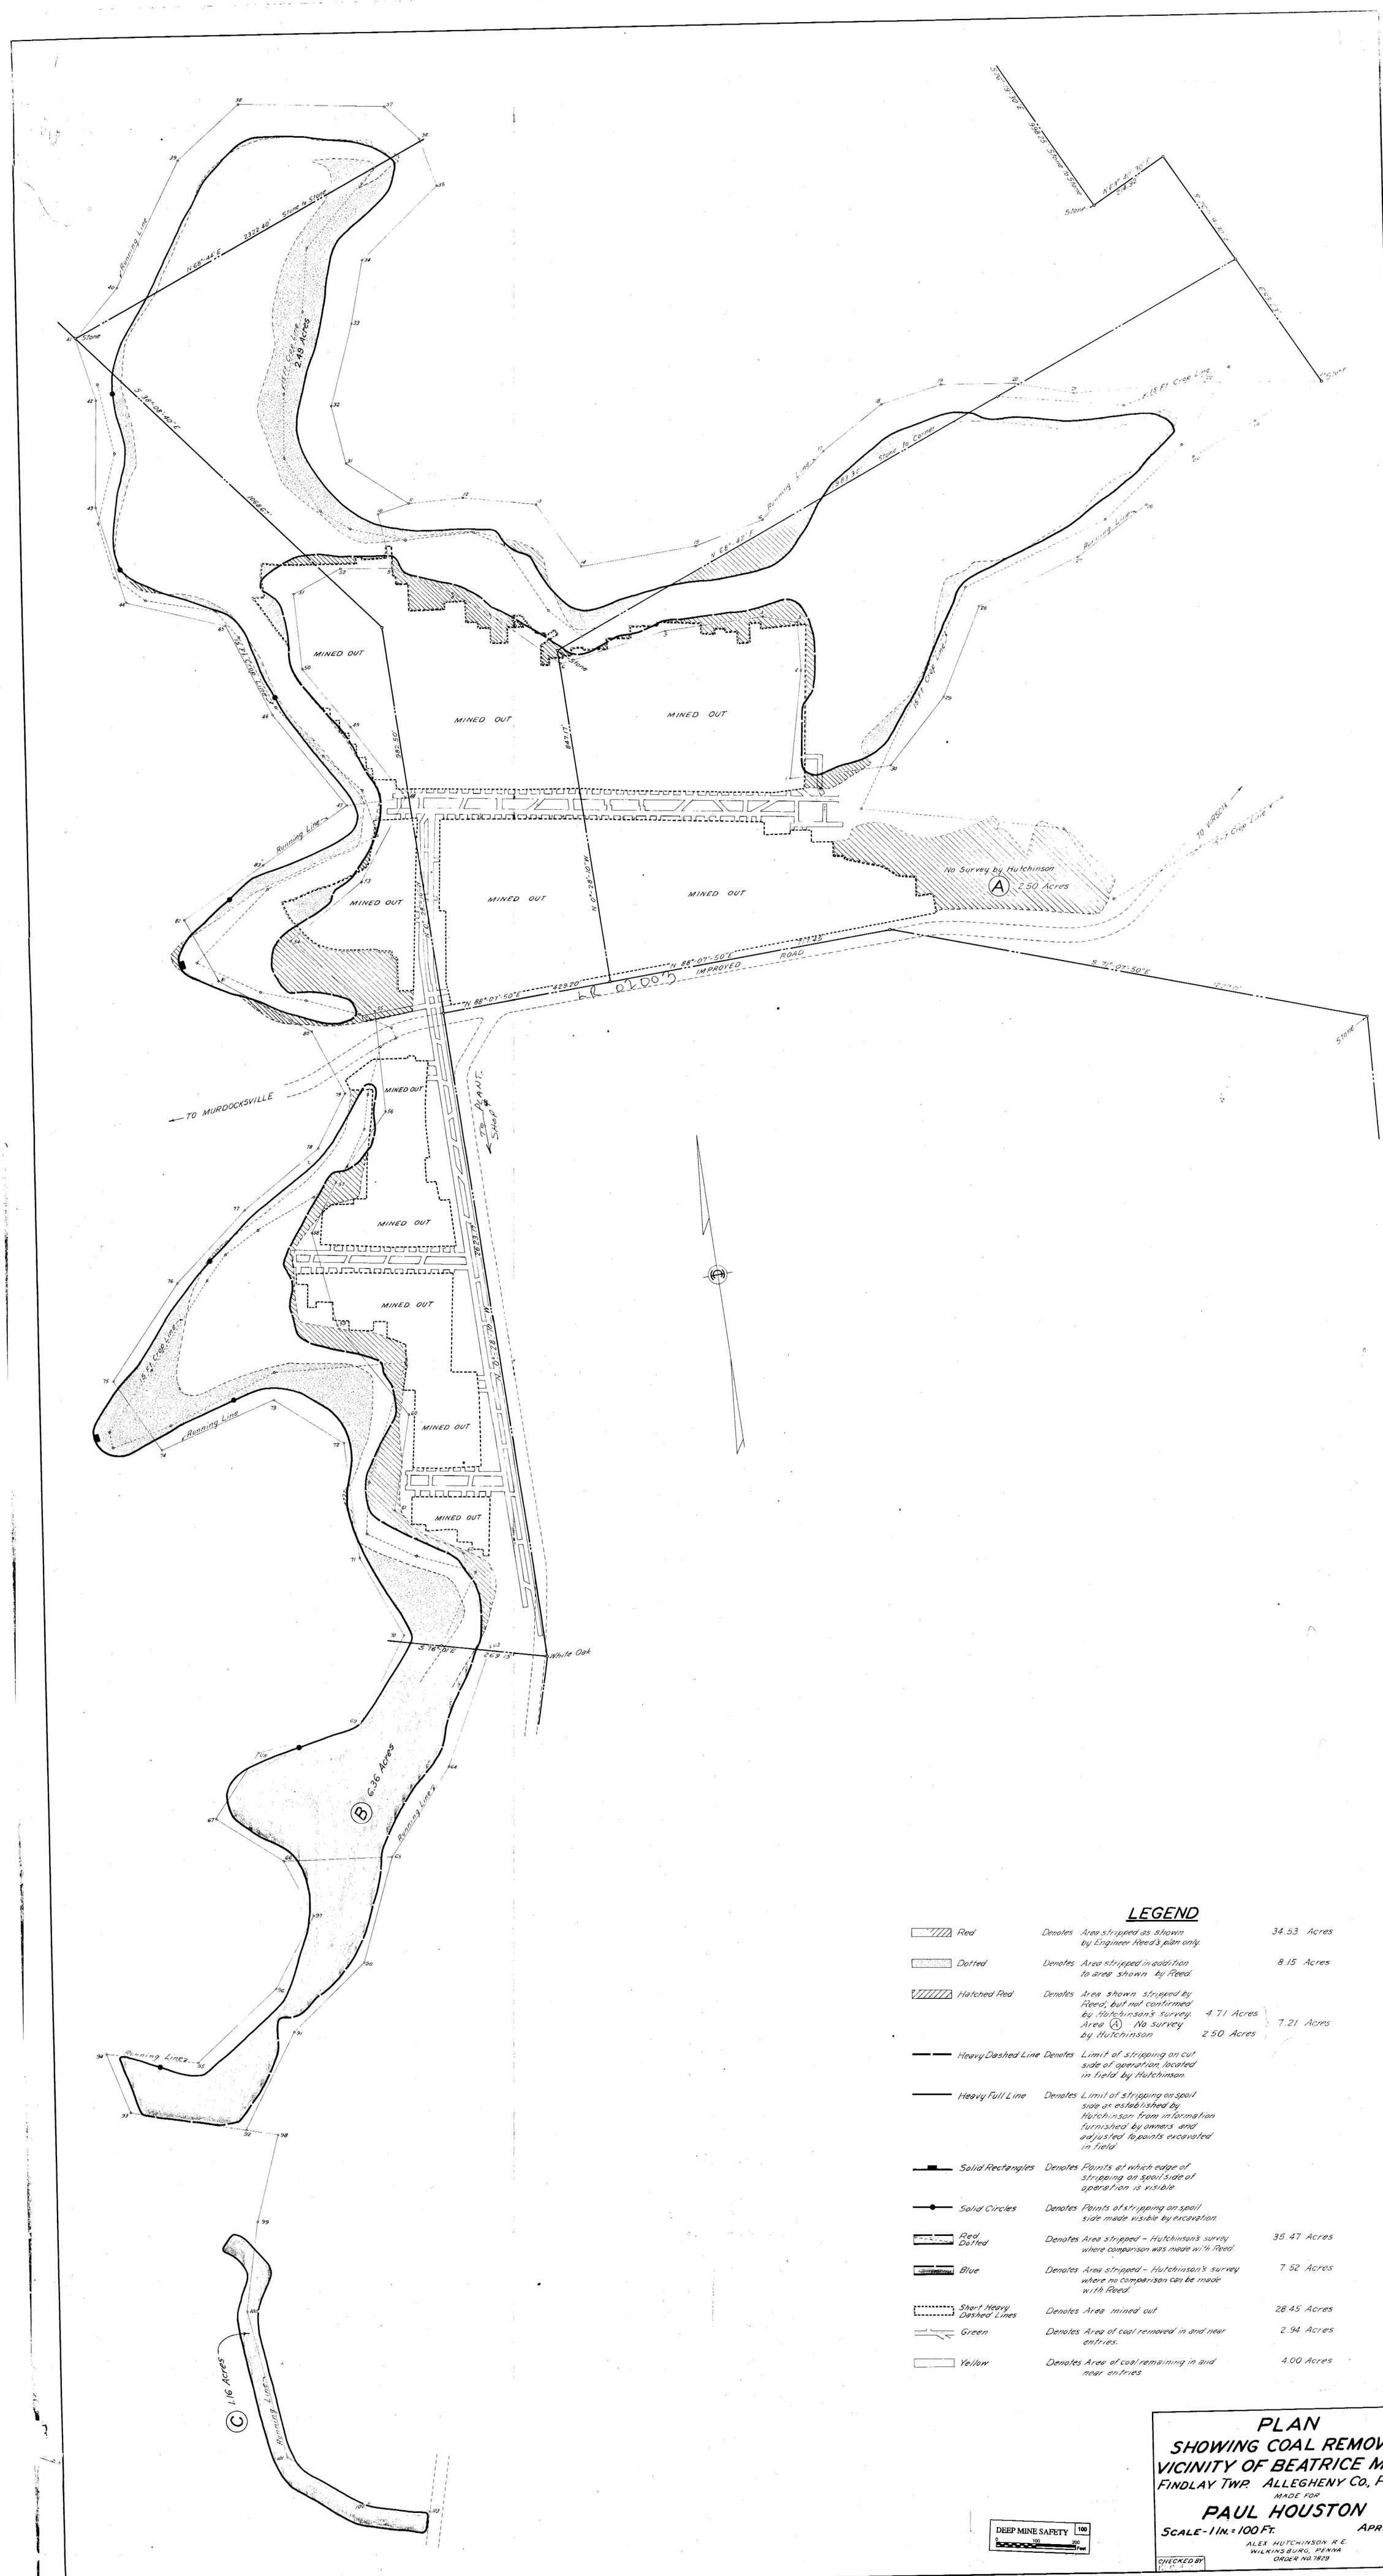

LEGEND

Red	Denotes	Area stripped as shown by Engineer Reed's plan only.	34.53 Acres
Dotted	Denotes	Area stripped in addition to area shown by Reed.	8.15 Acres
Hatched Red	Denotes	Area shown stripped by Reed, but not confirmed by Hutchinson's survey. 4.71 Acres; Area (A) No survey by Hutchinson 2.50 Acres	7.21 Acres
Heavy Dashed Line	Denotes	Limit of stripping on cut side of operation, located in field by Hutchinson.	
Heavy Full Line	Denotes	Limit of stripping on spoil side as established by Hutchinson from information furnished by owners and adjusted to points excavated in field.	
Solid Rectangles	Denotes	Points at which edge of stripping on spoil side of operation is visible.	
Solid Circles	Denotes	Points of stripping on spoil side made visible by excavation.	
Red Dotted	Denotes	Area stripped - Hutchinson's survey where comparison was made with Reed.	35.47 Acres
Blue	Denotes	Area stripped - Hutchinson's survey where no comparison can be made with Reed.	7.52 Acres
Short Heavy Dashed Lines	Denotes	Area mined out	28.45 Acres
Green	Denotes	Area of coal removed in and near entries.	2.94 Acres
Yellow	Denotes	Area of coal remaining in and near entries.	4.00 Acres

PLAN
SHOWING COAL REMOVED
VICINITY OF BEATRICE MINE
FINDLAY TWP. ALLEGHENY CO., PENNA.

MADE FOR

PAUL HOUSTON

SCALE - 1 IN. = 100 FT. APRIL 1950

ALEX HUTCHINSON R.E.
WILKINSBURG, PENNA
ORDER NO. 7829

CHECKED BY